


SECTION 17, T. 29, R. 23. X

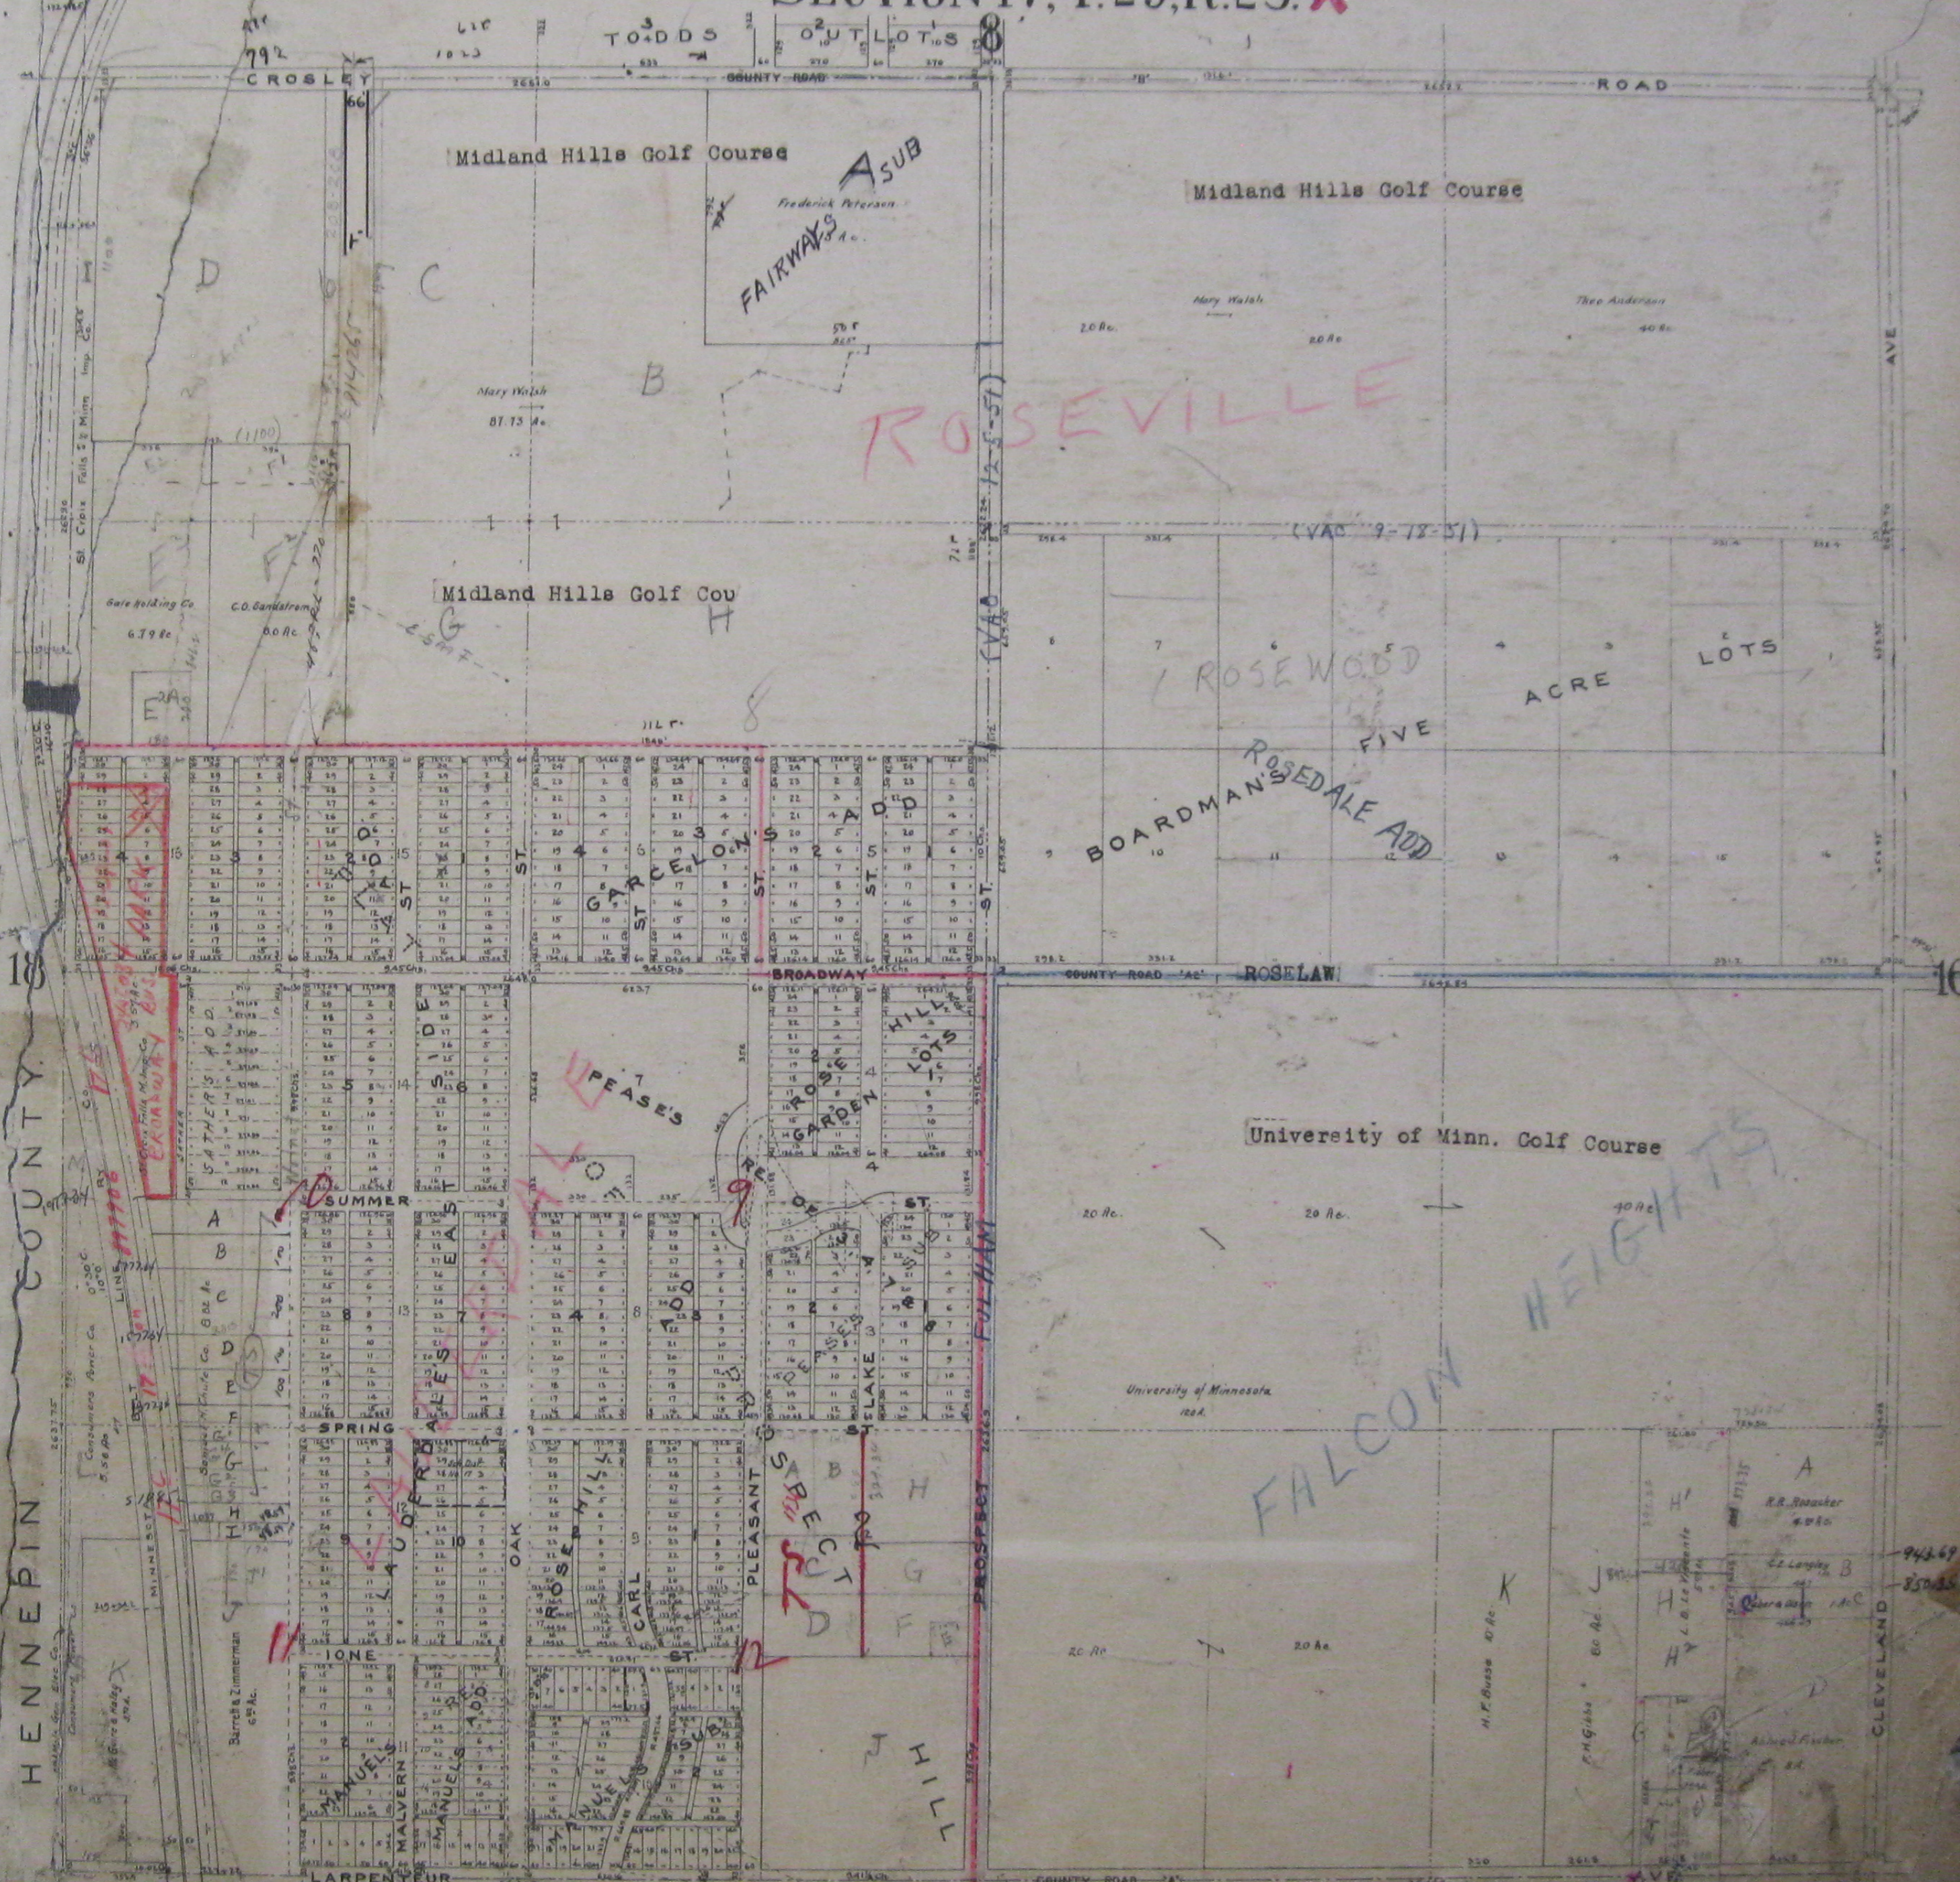

18

16

HENNEPIN COUNTY

CLEVELAND AVE

17-29-23

20