

SECTION 21 T. 29, R. 23. X

16

ANNIE L. HENDRICKSON'S ACRE LOTS




THE CROSSROADS

LARPEUR AVE.

COUNTY ROAD A

AVE.

AVE.

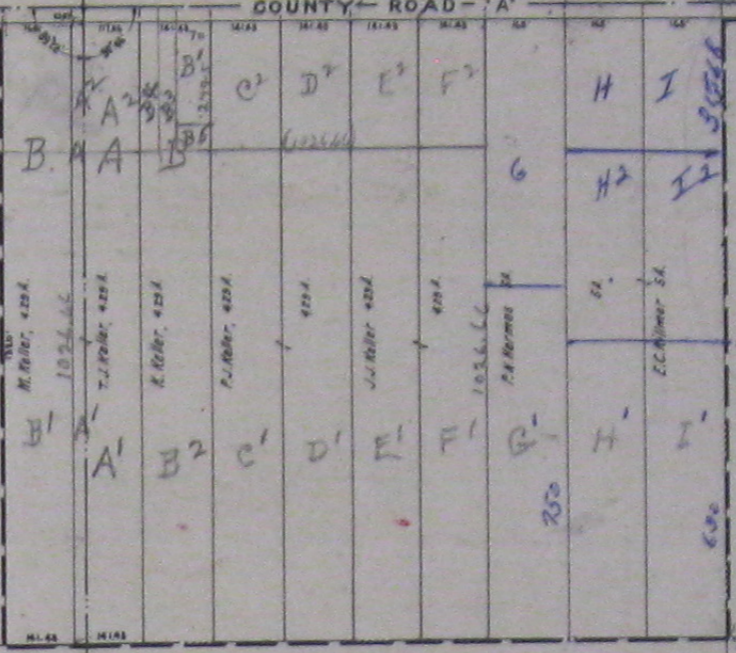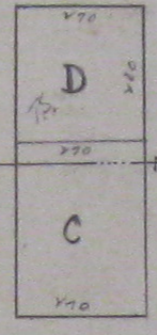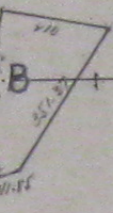

UNIVERSITY OF MINNESOTA

STATE OF MINNESOTA

FAIR GROUNDS

20

22

NORTH PARK

CLEVELAND

ST. ANTHONY

CITY LIMITS

TRUNK HIGHWAY 51


SNELLING

LAKE PARK ADD.

COMO

FRANKSON'S

STATE OF MINNESOTA

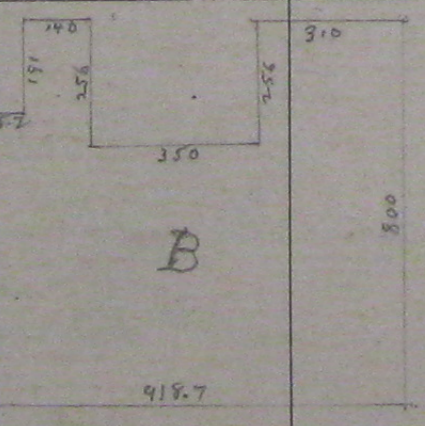

908923

COMO

AVE. W.

ST. ANTHONY PARK ADD.

LONG'S ADD.

28

1-29-23