


SECTION 10, T. 30, R. 22.

3

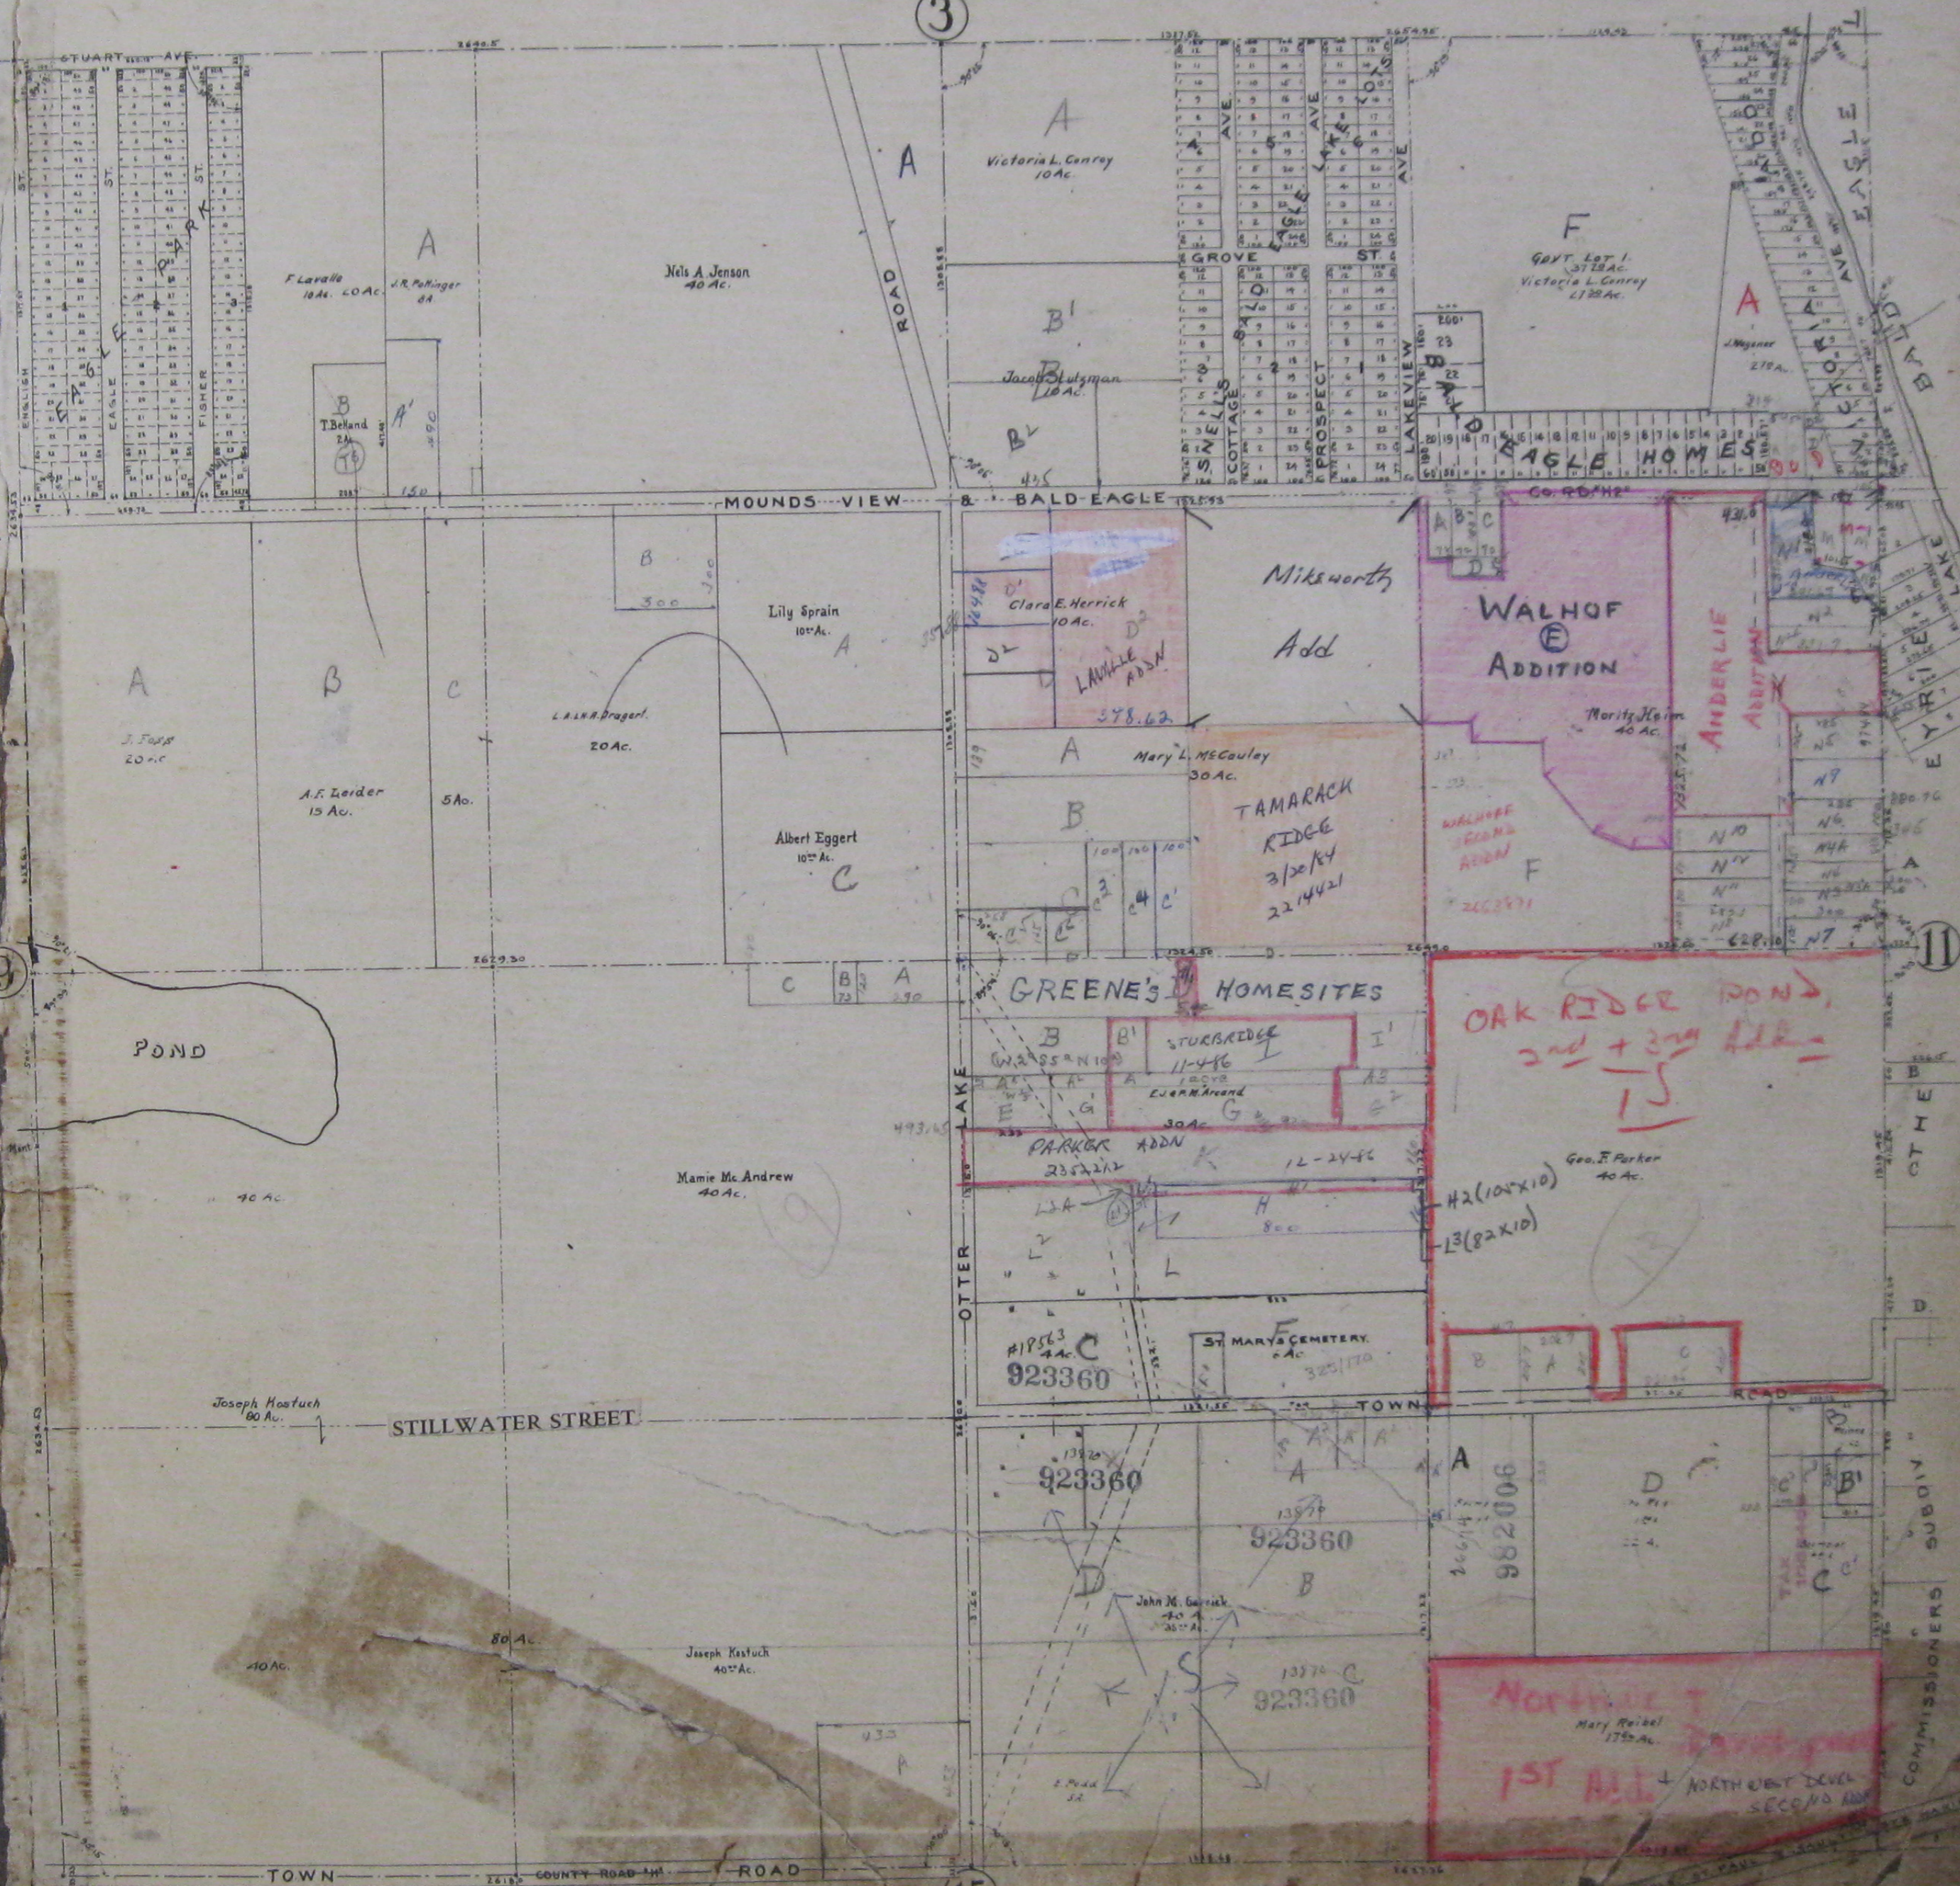

10-30-22

15

COMMISSIONERS SUBDIV