
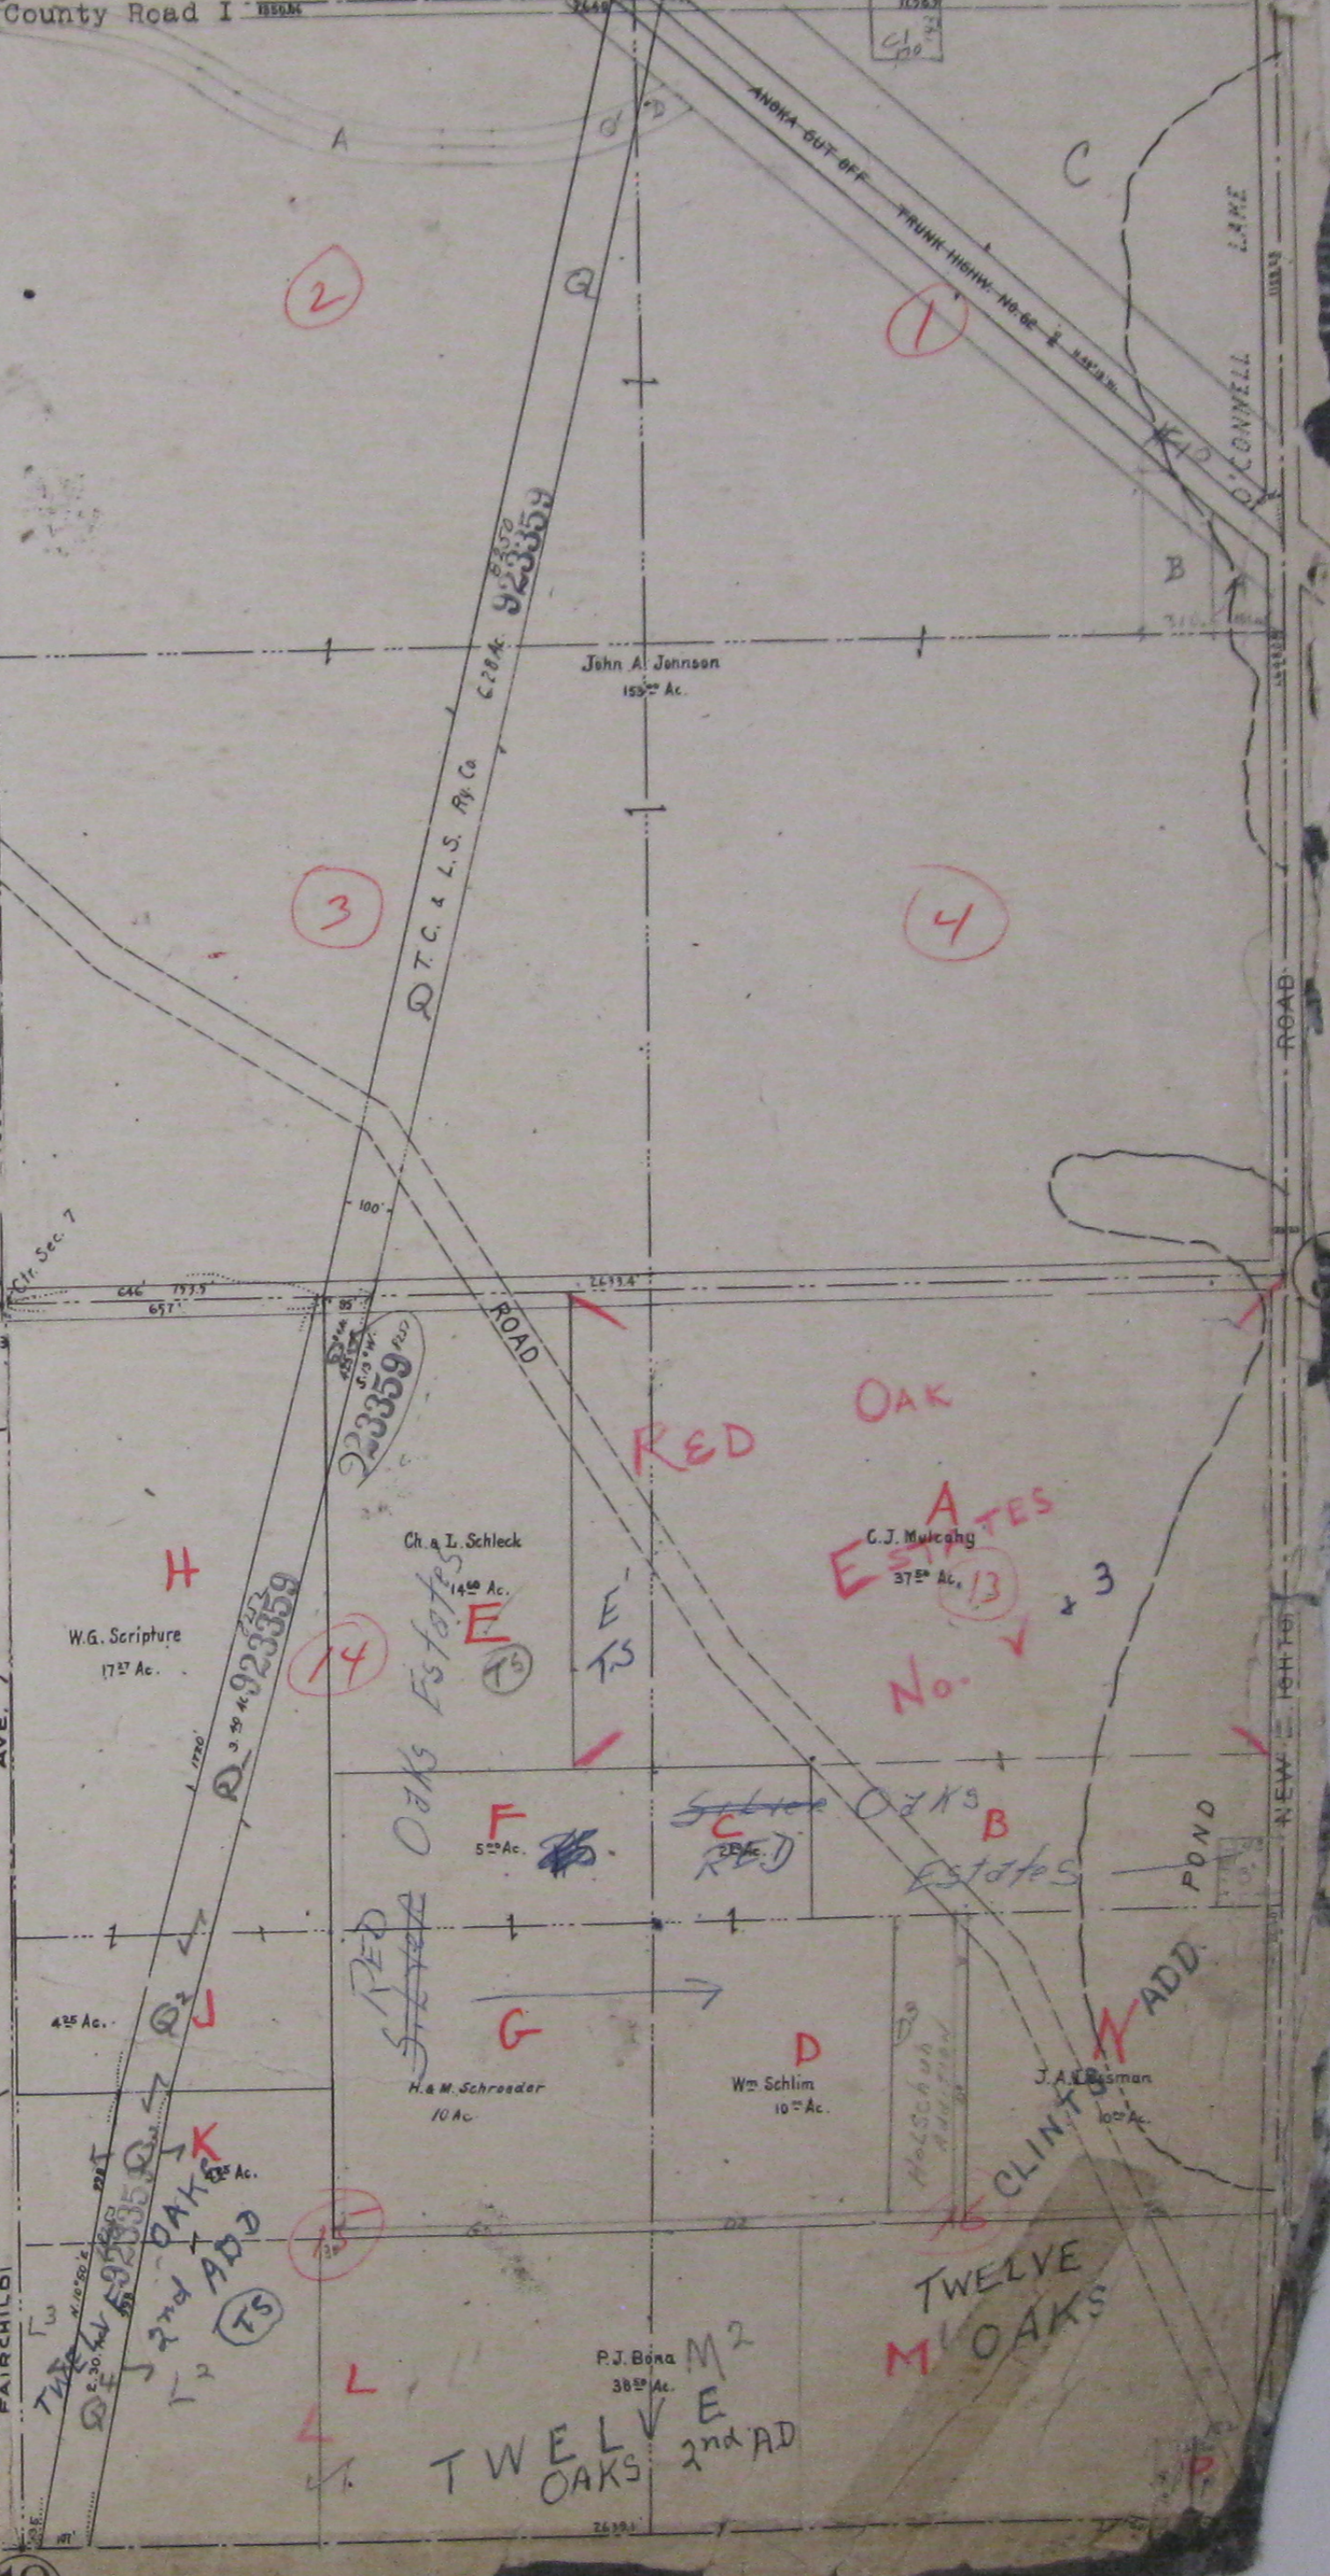


Section 7 T. 30 R. 23.

6

TSPL #182026

County Road I

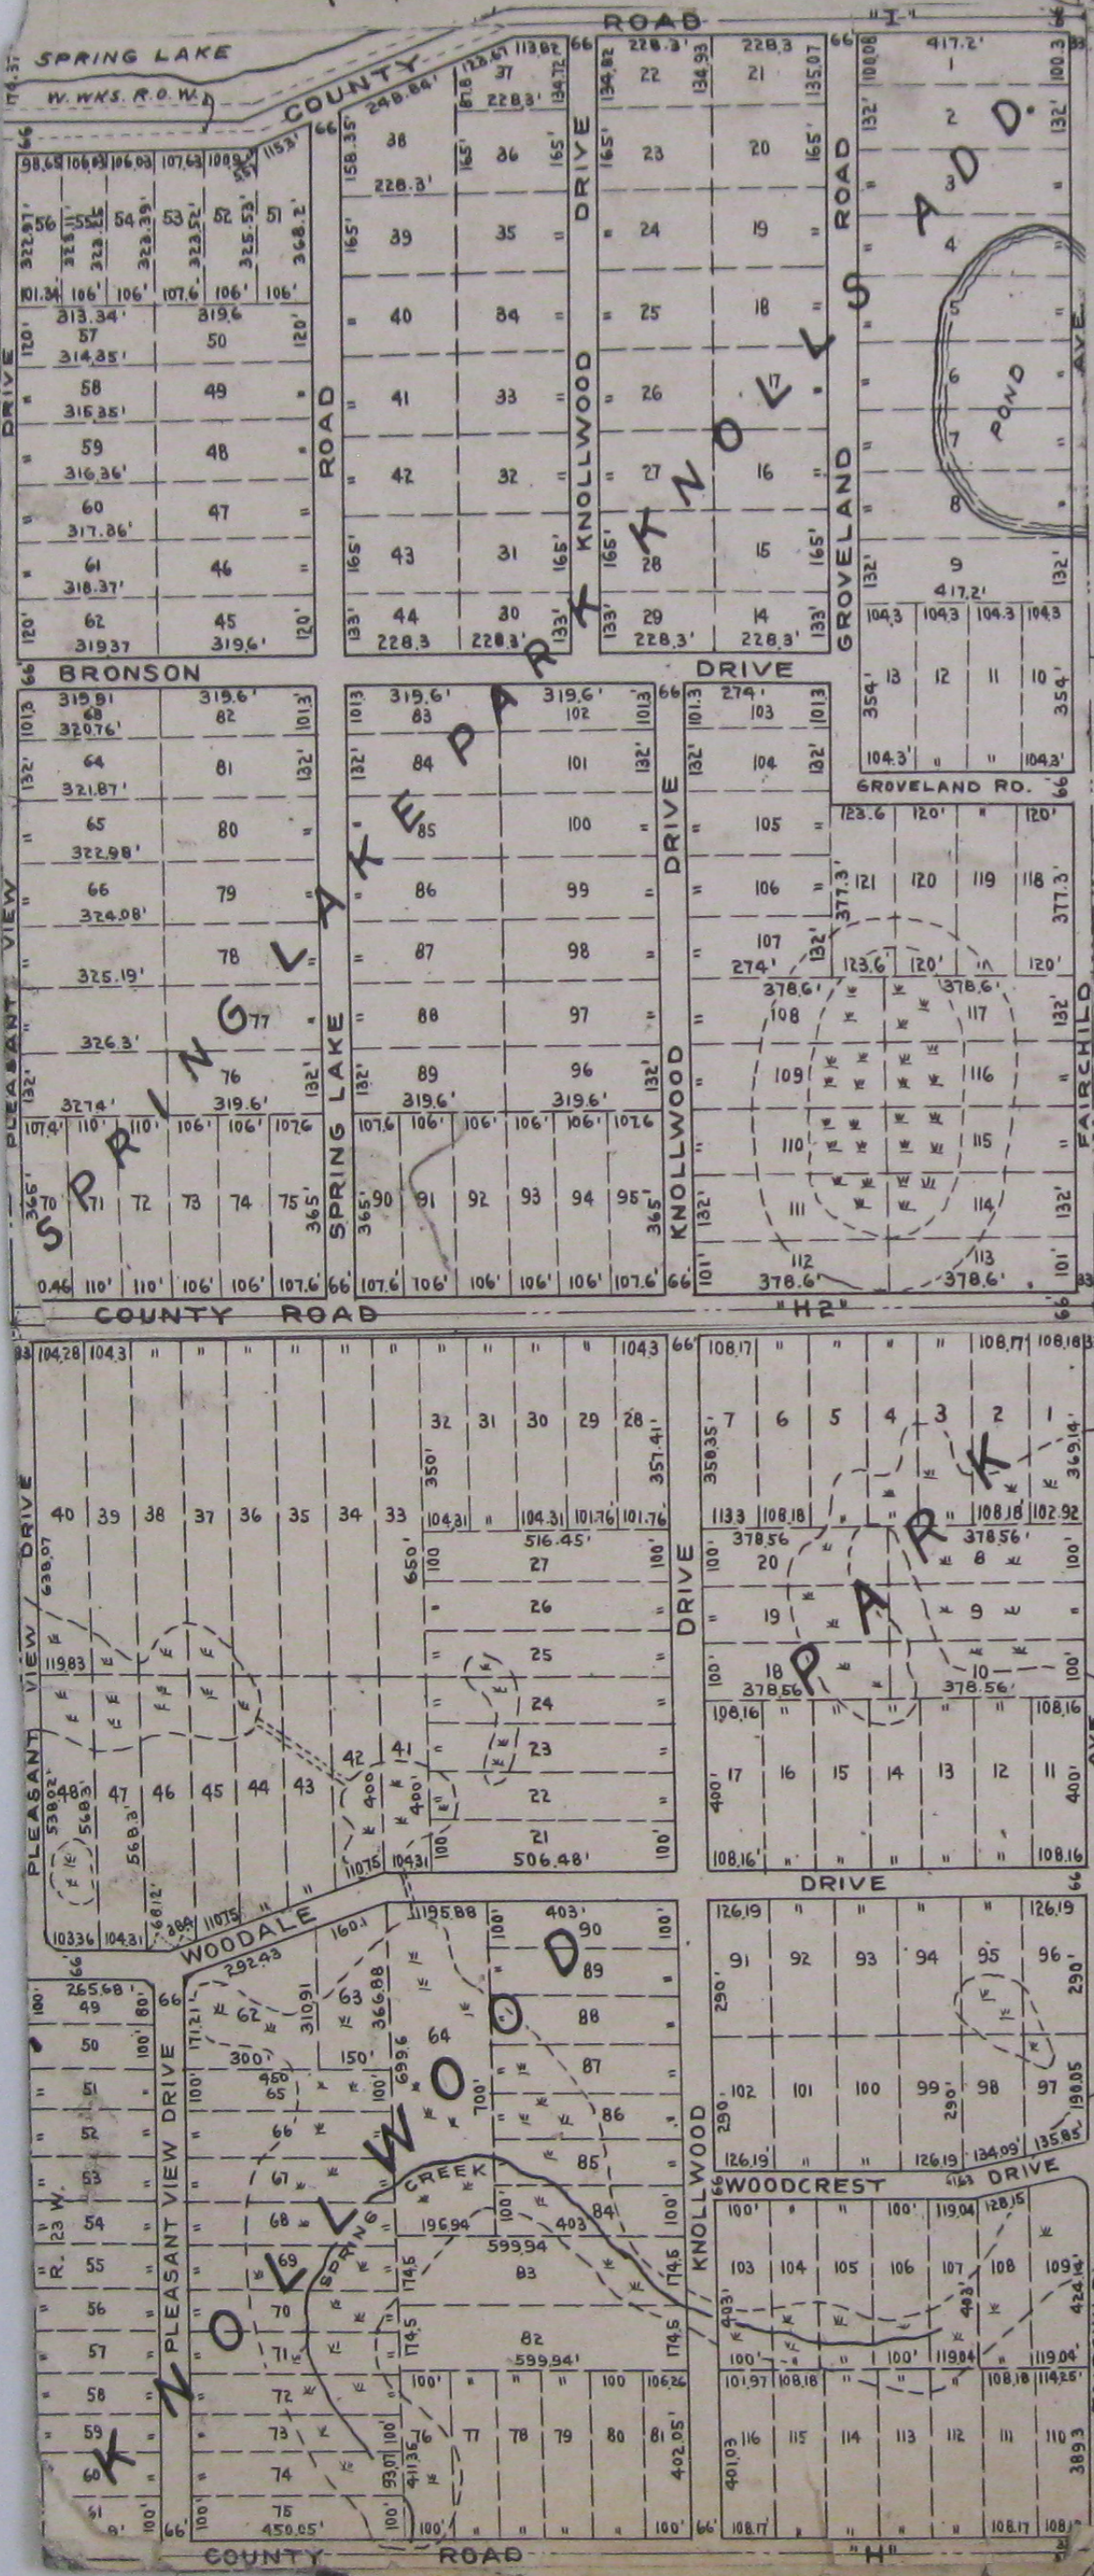

18