


# Section 16, T. 30., R. 23

9

973368

County Road H

TWIN CITIES ORDNANCE PLANT.  
PROPERTY OF THE UNITED STATES.  
SECTIONS 9-10-15-16 EXCEPT PART SOUTH  
OF TRUNK HIGHWAY 10.

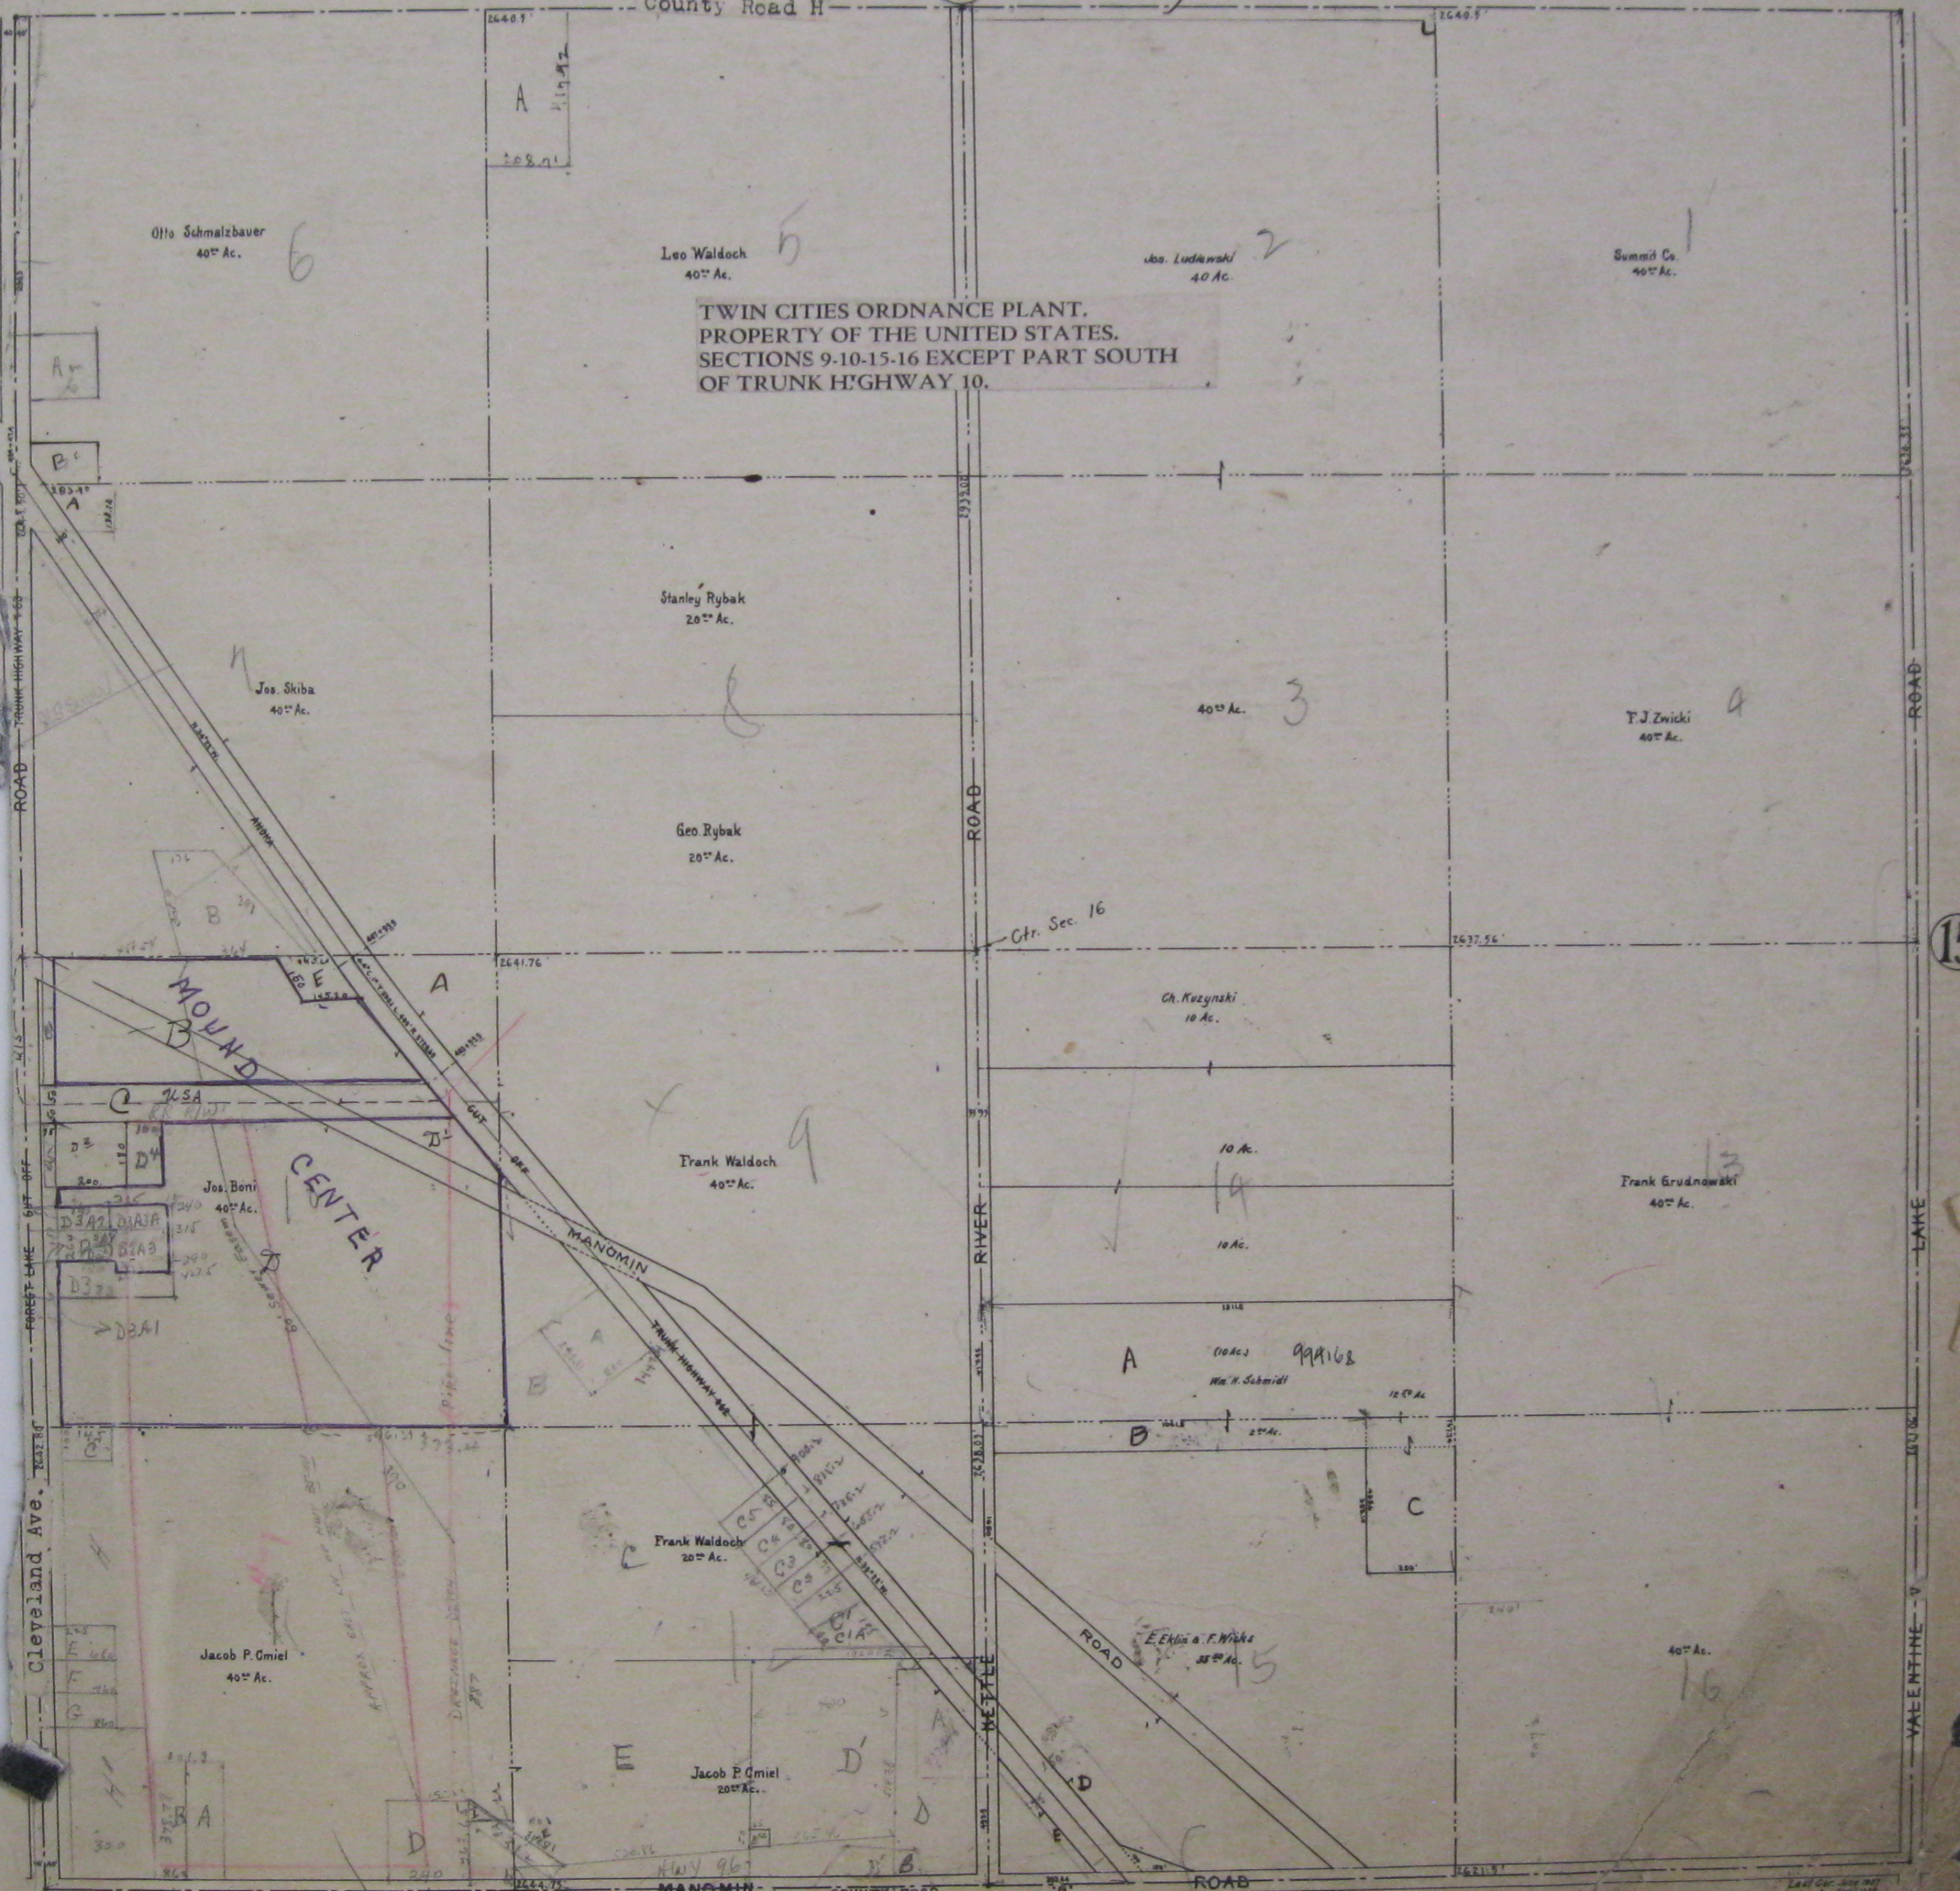

15

16 30 23

21