


SECTION 30, T.30, R.23.

19

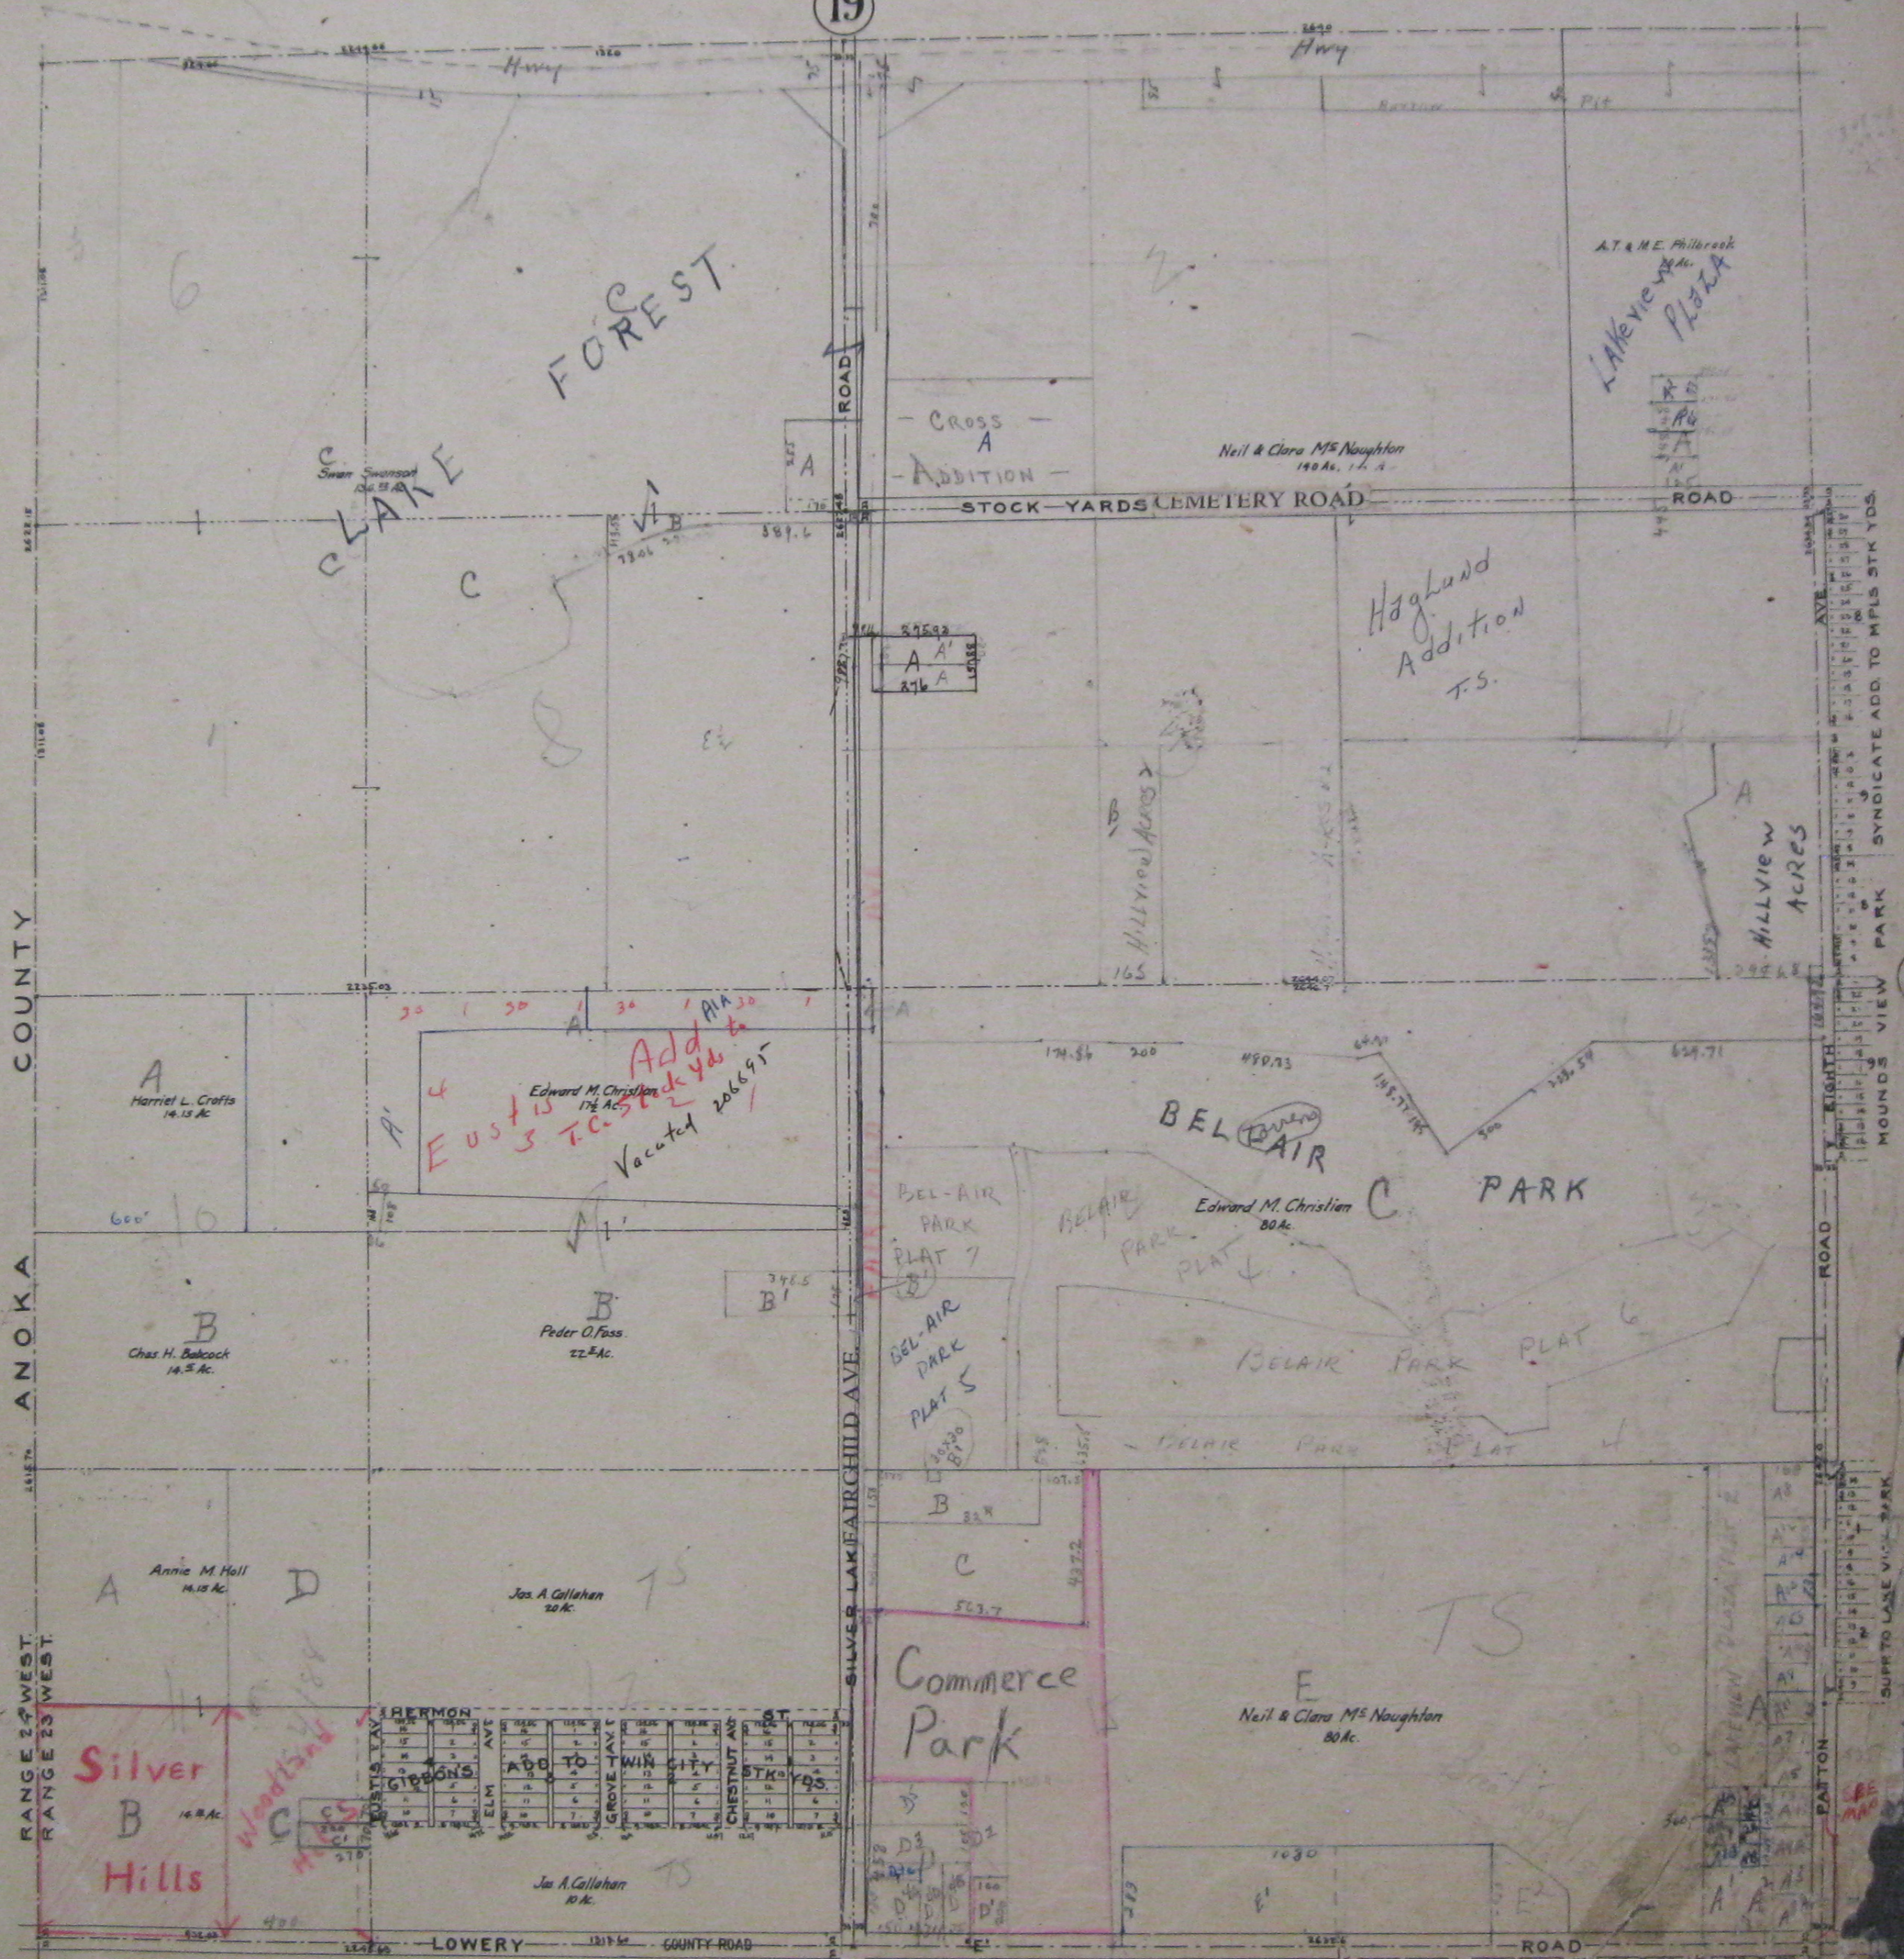

COUNTY ANOKA

RANGE 24 WEST
RANGE 23 WEST

29

MOUNDS VIEW PARK SYNDICATE ADD. TO MPLS STK YDS.

SUPP TO LASE VILL. PARK

31

30-30-23