


# CERTIFICATE of SURVEY

F. J. ARMSTRONG  
Civil Engineer and Surveyor  
ST. PAUL, MINN.

PAGE 57.

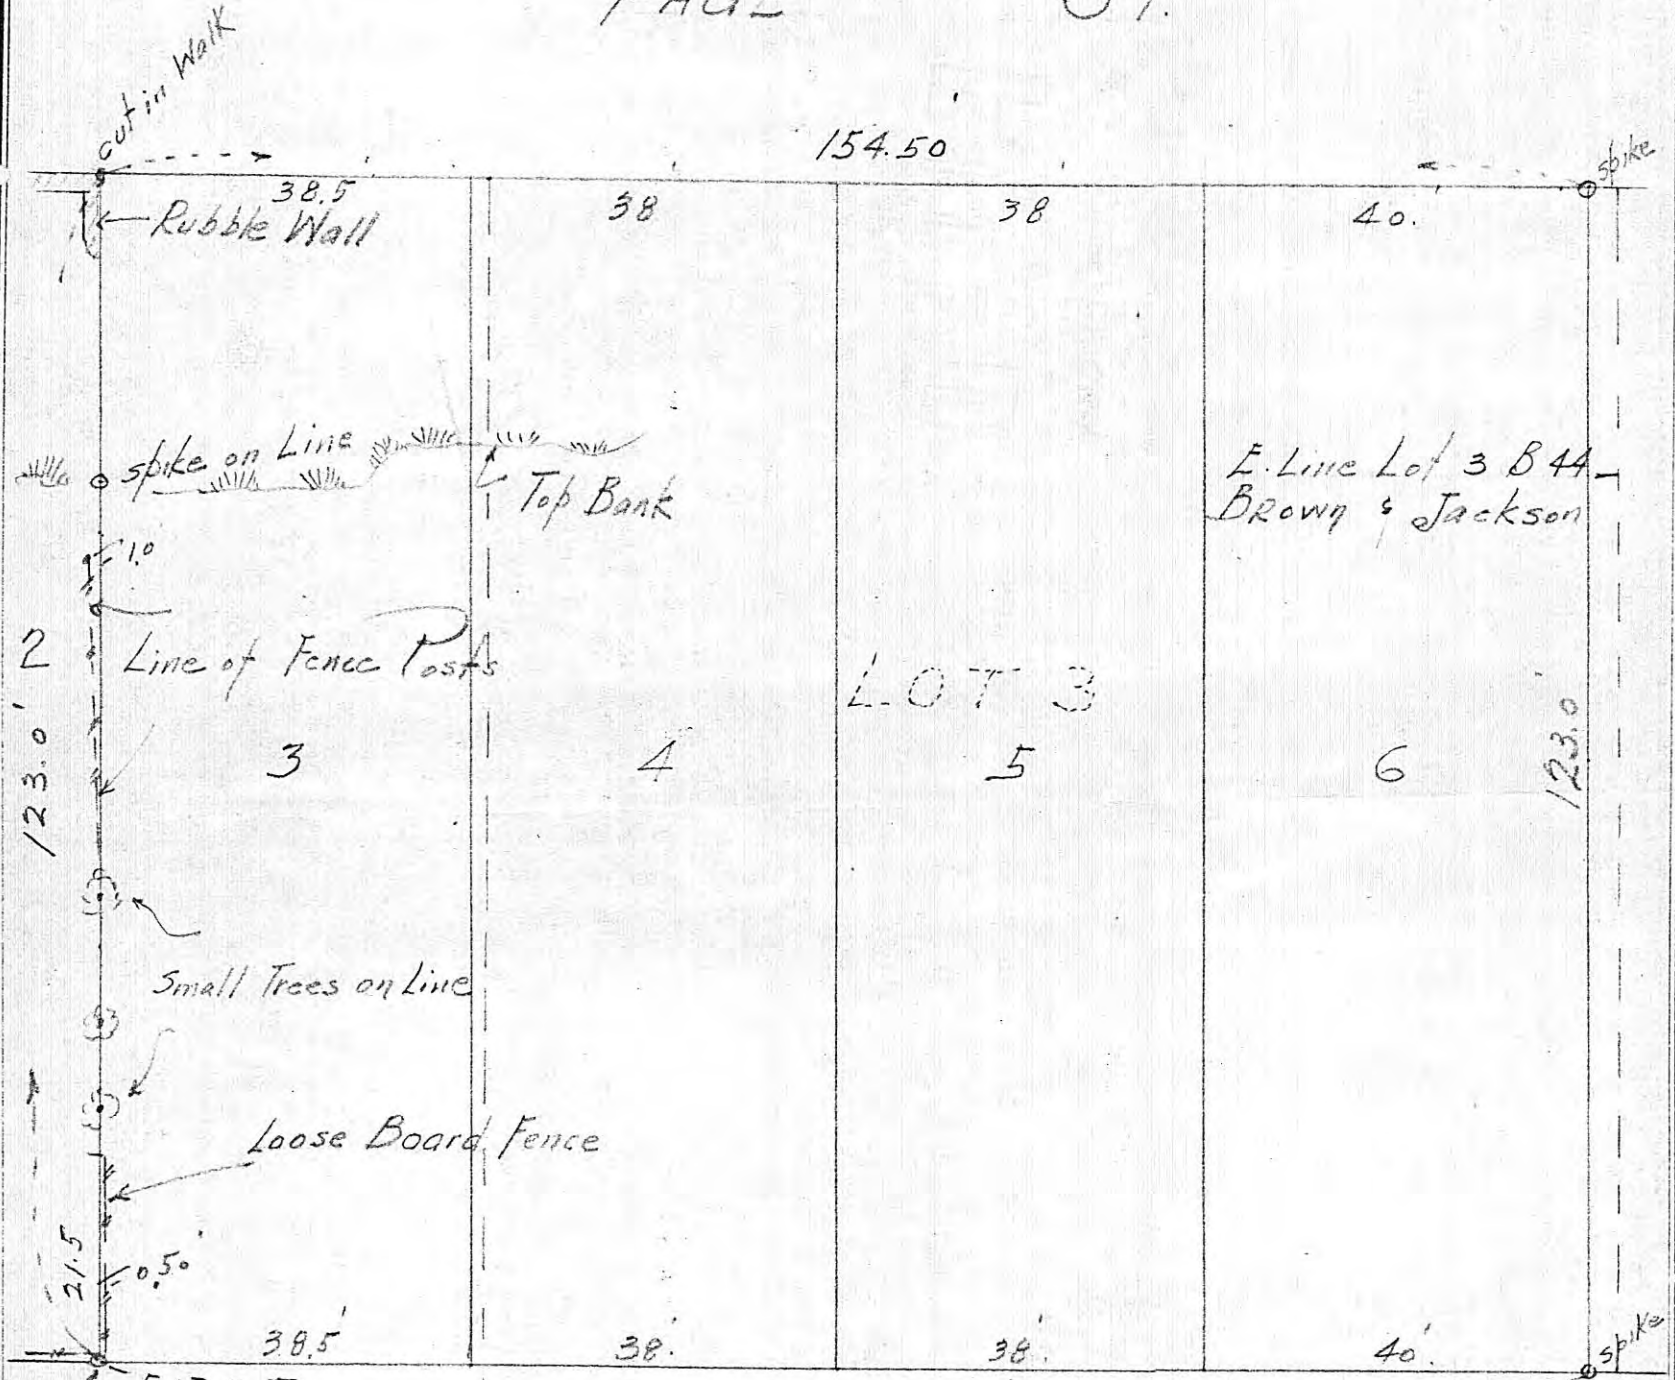

E. Line Lot 3 B 44  
Brown & Jackson

LOT 3

20" ALLEY

Lot three (3), four (4), five (5), and six (6). Riley's Re-arrangement of the West 257 ft of Block 44 Brown and Jackson's Addition St. Paul, Minn. according to the Plat thereof on file and of record in the office of the Register of Deeds in and for Ramsey County.

Scale 20' per inch.

I HEREBY CERTIFY that on the 10<sup>th</sup> day of March, A. D. 1960

I made a survey of the following described property, to-wit: As described above and the land above described is situated in Riley's Re-arrangement of Lots 3 & 4 Block 44 Brown & Jackson's Addn to West St Paul and the above map is a true and correct map of said survey and the improvements shown thereon are correctly indicated

Subscribed and sworn to before me this 14 day of March, 1960

Roger L. Ginkel  
Notary Public.

ROGER L. GINKEL

My Commission Expires Notary Public, Dakota County, Minn.  
My Commission Expires Oct. 2, 1961

F. J. Armstrong  
Civil Engineer