10046
Roll #350

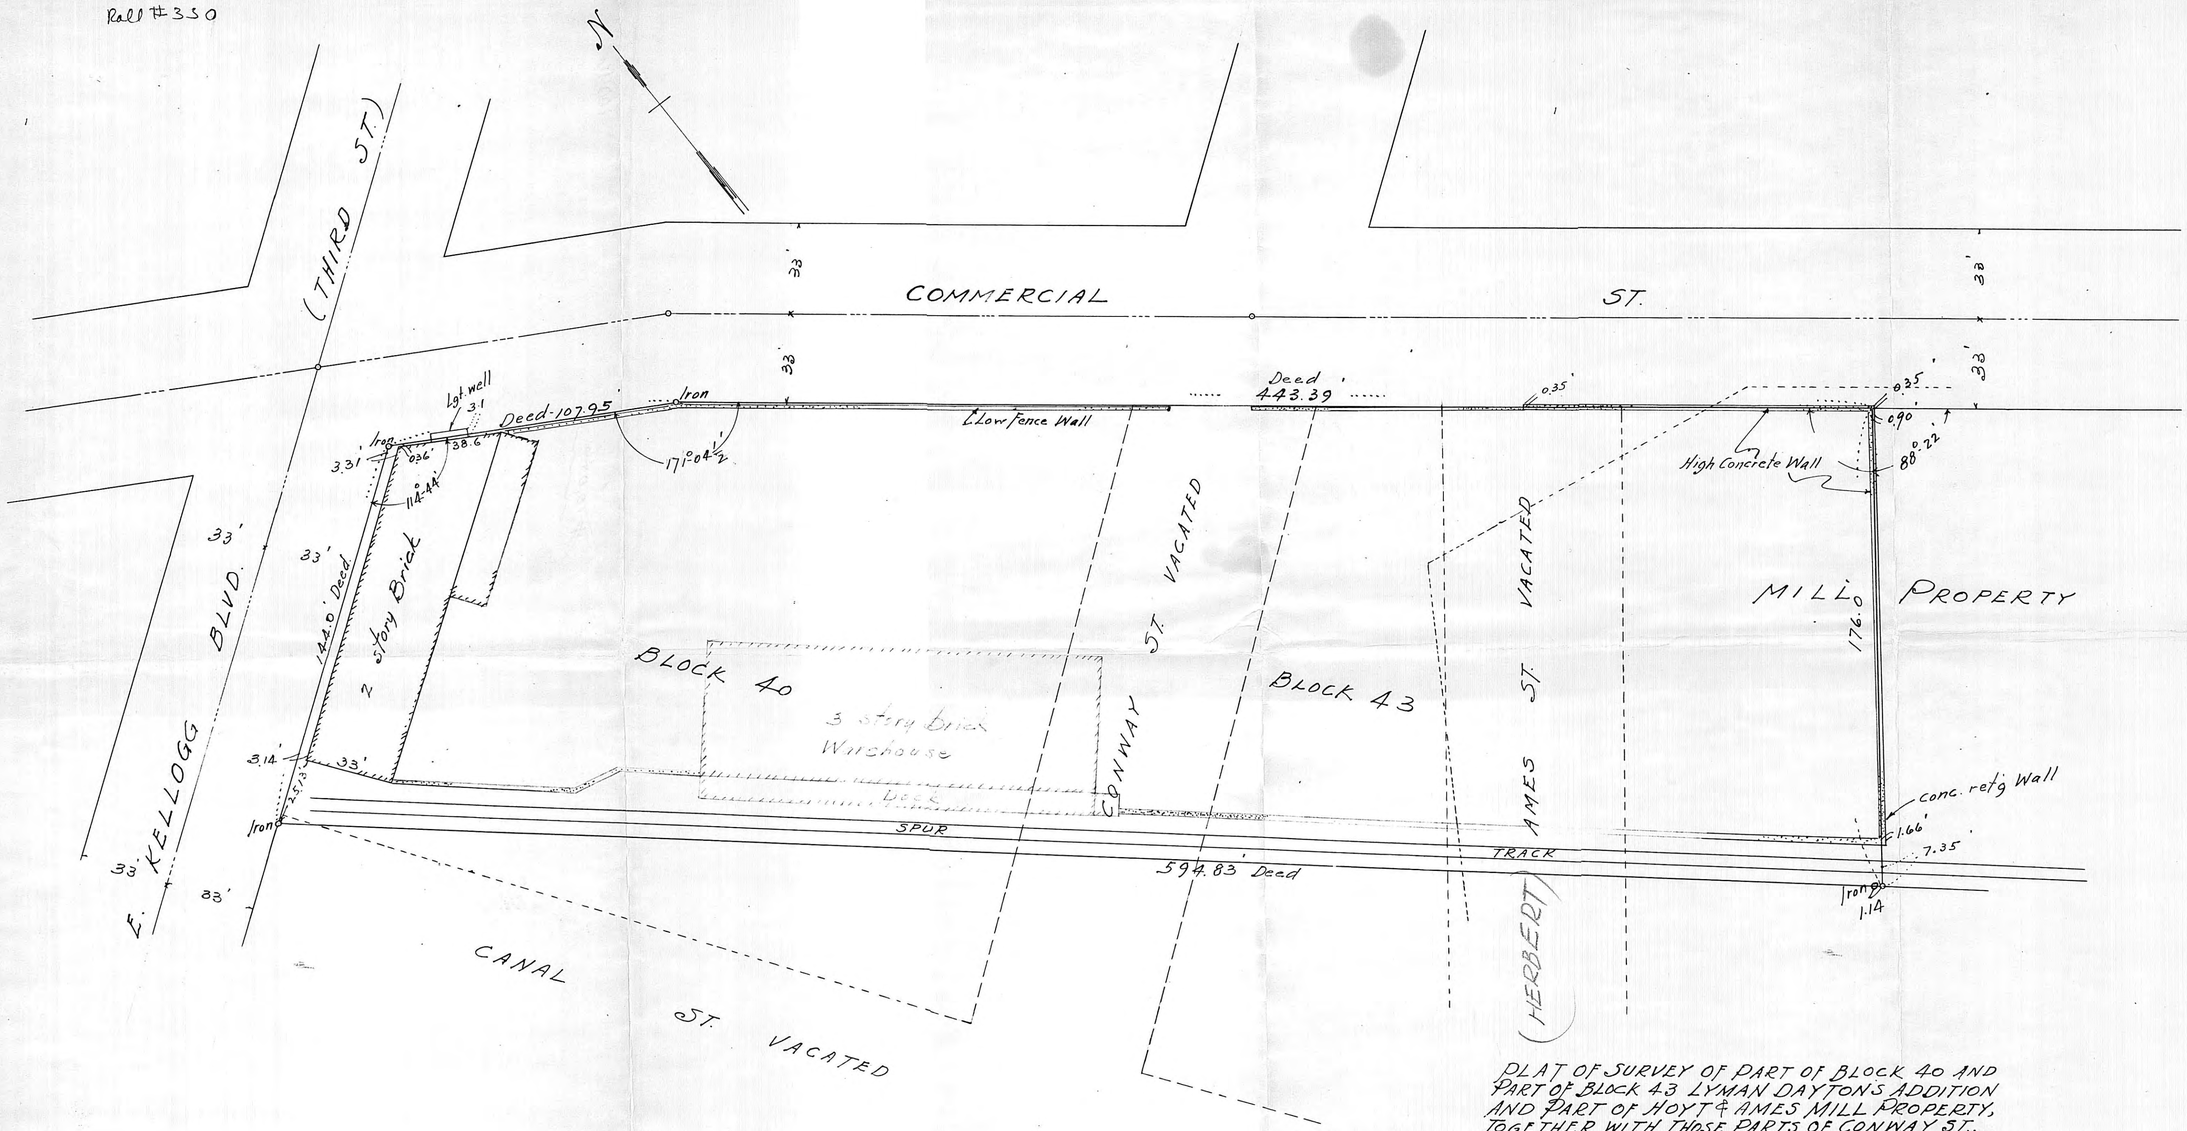

PLAT OF SURVEY OF PART OF BLOCK 40 AND PART OF BLOCK 43 LYMAN DAYTON'S ADDITION AND PART OF HOYT & AMES MILL PROPERTY, TOGETHER WITH THOSE PARTS OF CONWAY ST., CANAL ST. AND AMES ST. VACATED, AS LIE WITHIN THE BOUNDS OF THE PROPERTY HEREIN INDICATED.

Sept. 4th 1959

F. J. Armstrong - Civil Engr

A°738

A°738