1701

10 098

Roll # 332
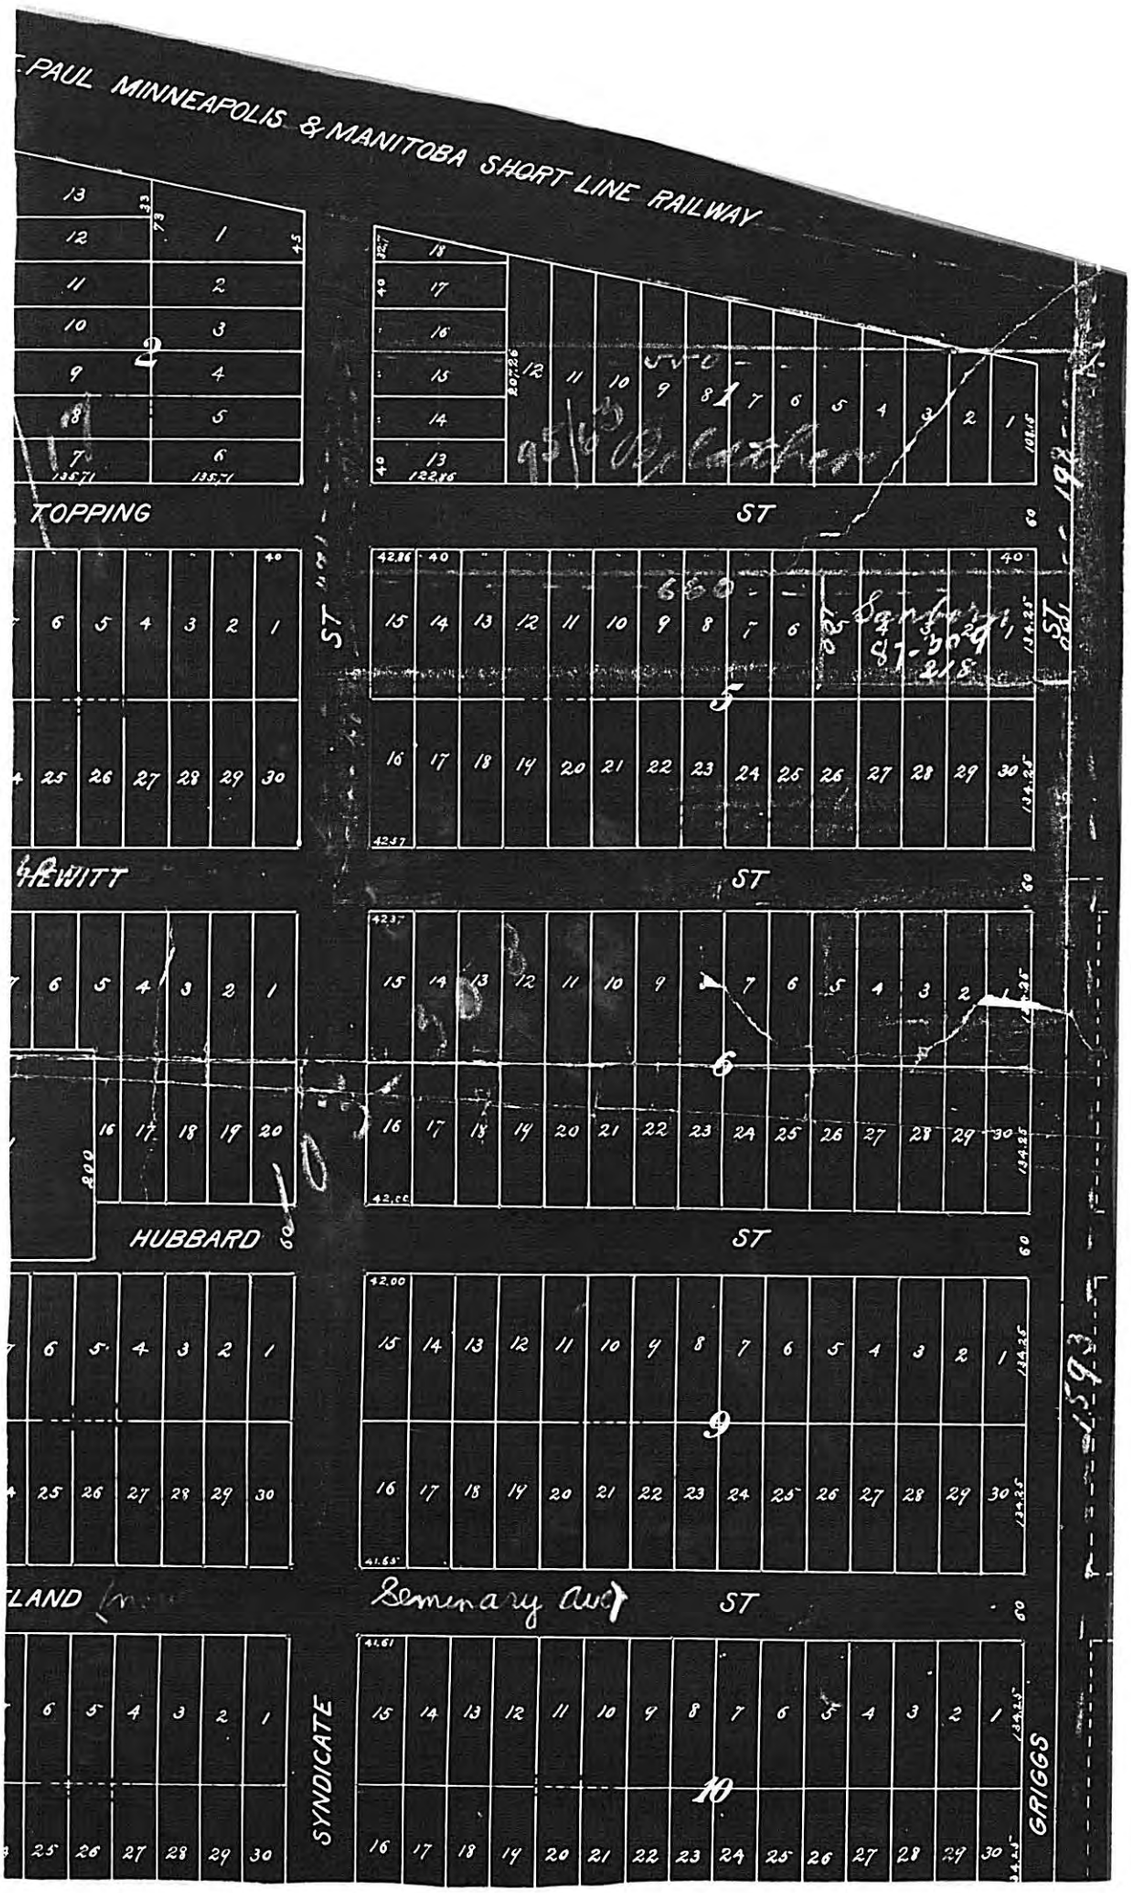
10098