

File 10298

Roll 339

Telephone: Midway 62179

# PLAT OF SURVEY


OF PROPERTY OF Richard Weiss

DESCRIBED AS FOLLOWS Lot 9 and the Southwesterly 10 feet of Lot 10, Block 51, Rice & Irvine's Add And Dayton & Irvine's Add. Except Easement over the Southeasterly 120' of the Southwesterly 10 feet of said Lot 10

SCALE: 1 INCH = 30 FEET  
O INDICATES IRON

~~W. O. CONNOR~~, Registered Surveyor  
F. R. KVIDERA  
~~W. O. CONNOR~~ AVE., ST. PAUL 4, MINN.  
823 N. Hamline

86201

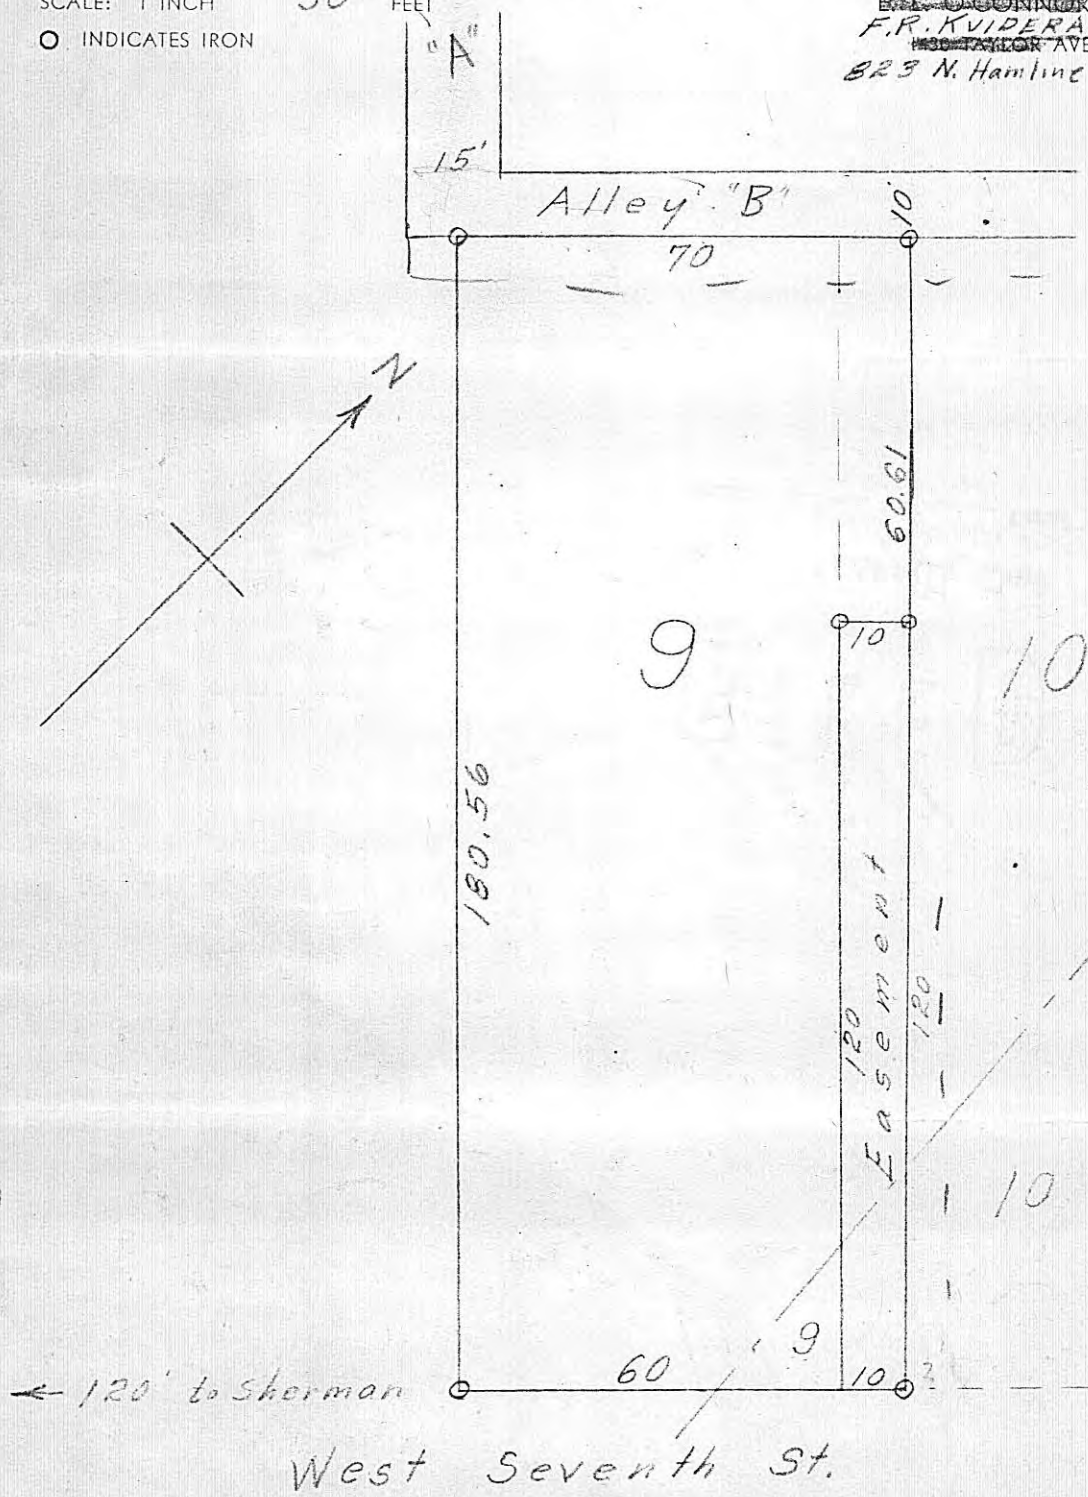

### CERTIFICATE OF SURVEY

I hereby certify that on Oct 15 1960  
I surveyed the property described above and that the above  
plat is a correct representation of said survey.

*Francis Kvidera*