

#10,368

CERTIFICATE OF SURVEY

10368

FROM THE OFFICE OF
P. R. McLAGAN

217 Dakota Avenue West St. Paul, Minn.

MINNESOTA REGISTERED LAND SURVEYOR

I Hereby Certify that this plat shows a survey made by me of the property described on this plat, and that the corners are correctly plated as shown, and that all locations, encroachments, etc., have been correctly shown.

P. R. McLAGAN


SURVEYED FOR W.H. Vana.

DATE April 18, 1947.

SCALE 20ft. per inch.

BY *P. R. McLagan*

LOT 12 BLOCK 2
STONE & ROGER'S ADD.

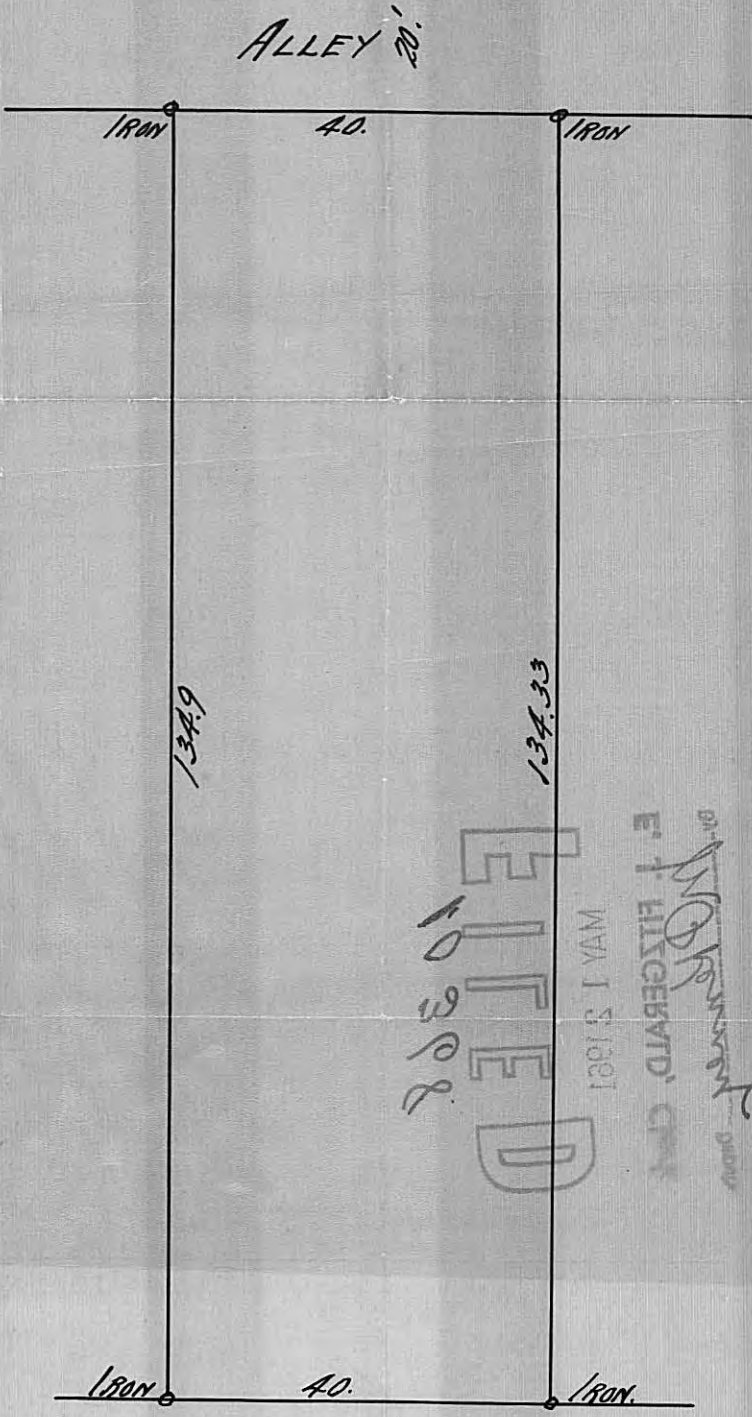

FILED
 10368
 MAY 1 2 1947
 E. J. FITZGERALD, CLERK
 P. R. McLagan

CARROLL AVE.

10368
R# 34