


10482

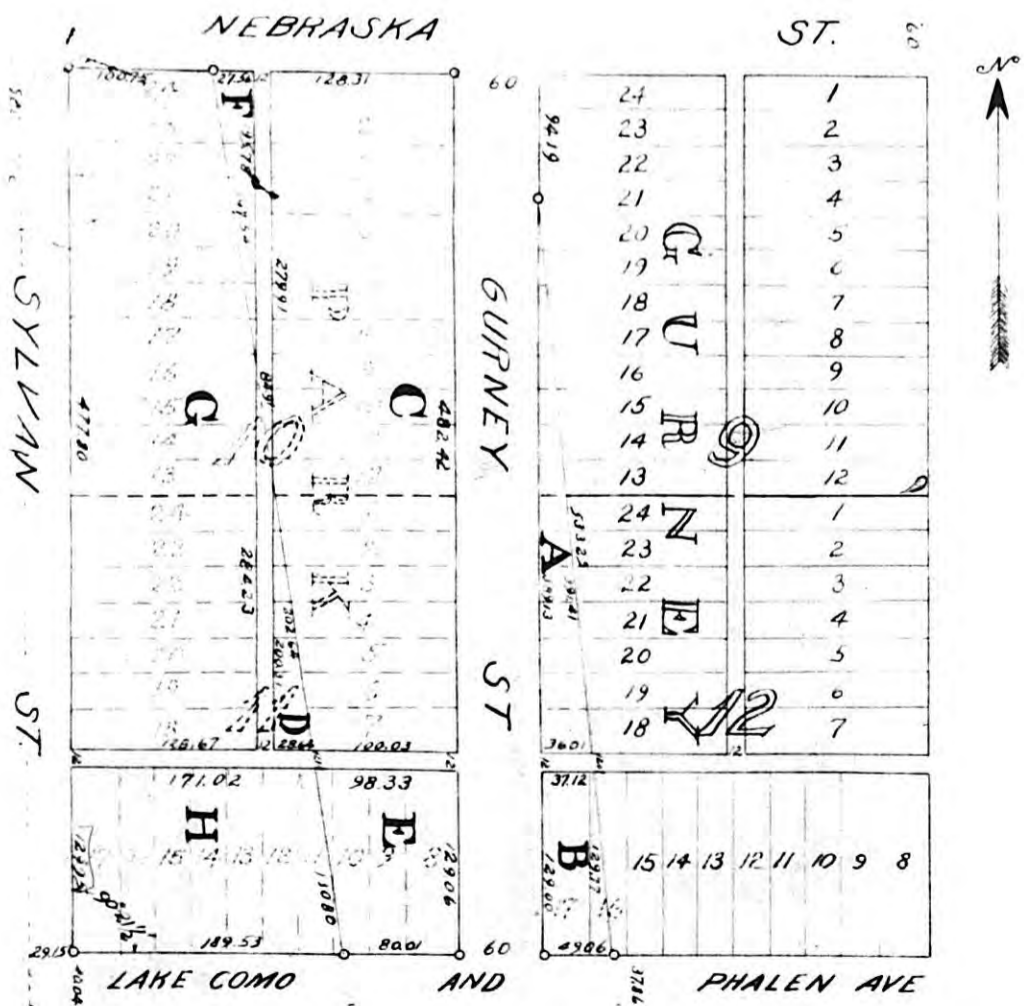

10482
R 346