


10498

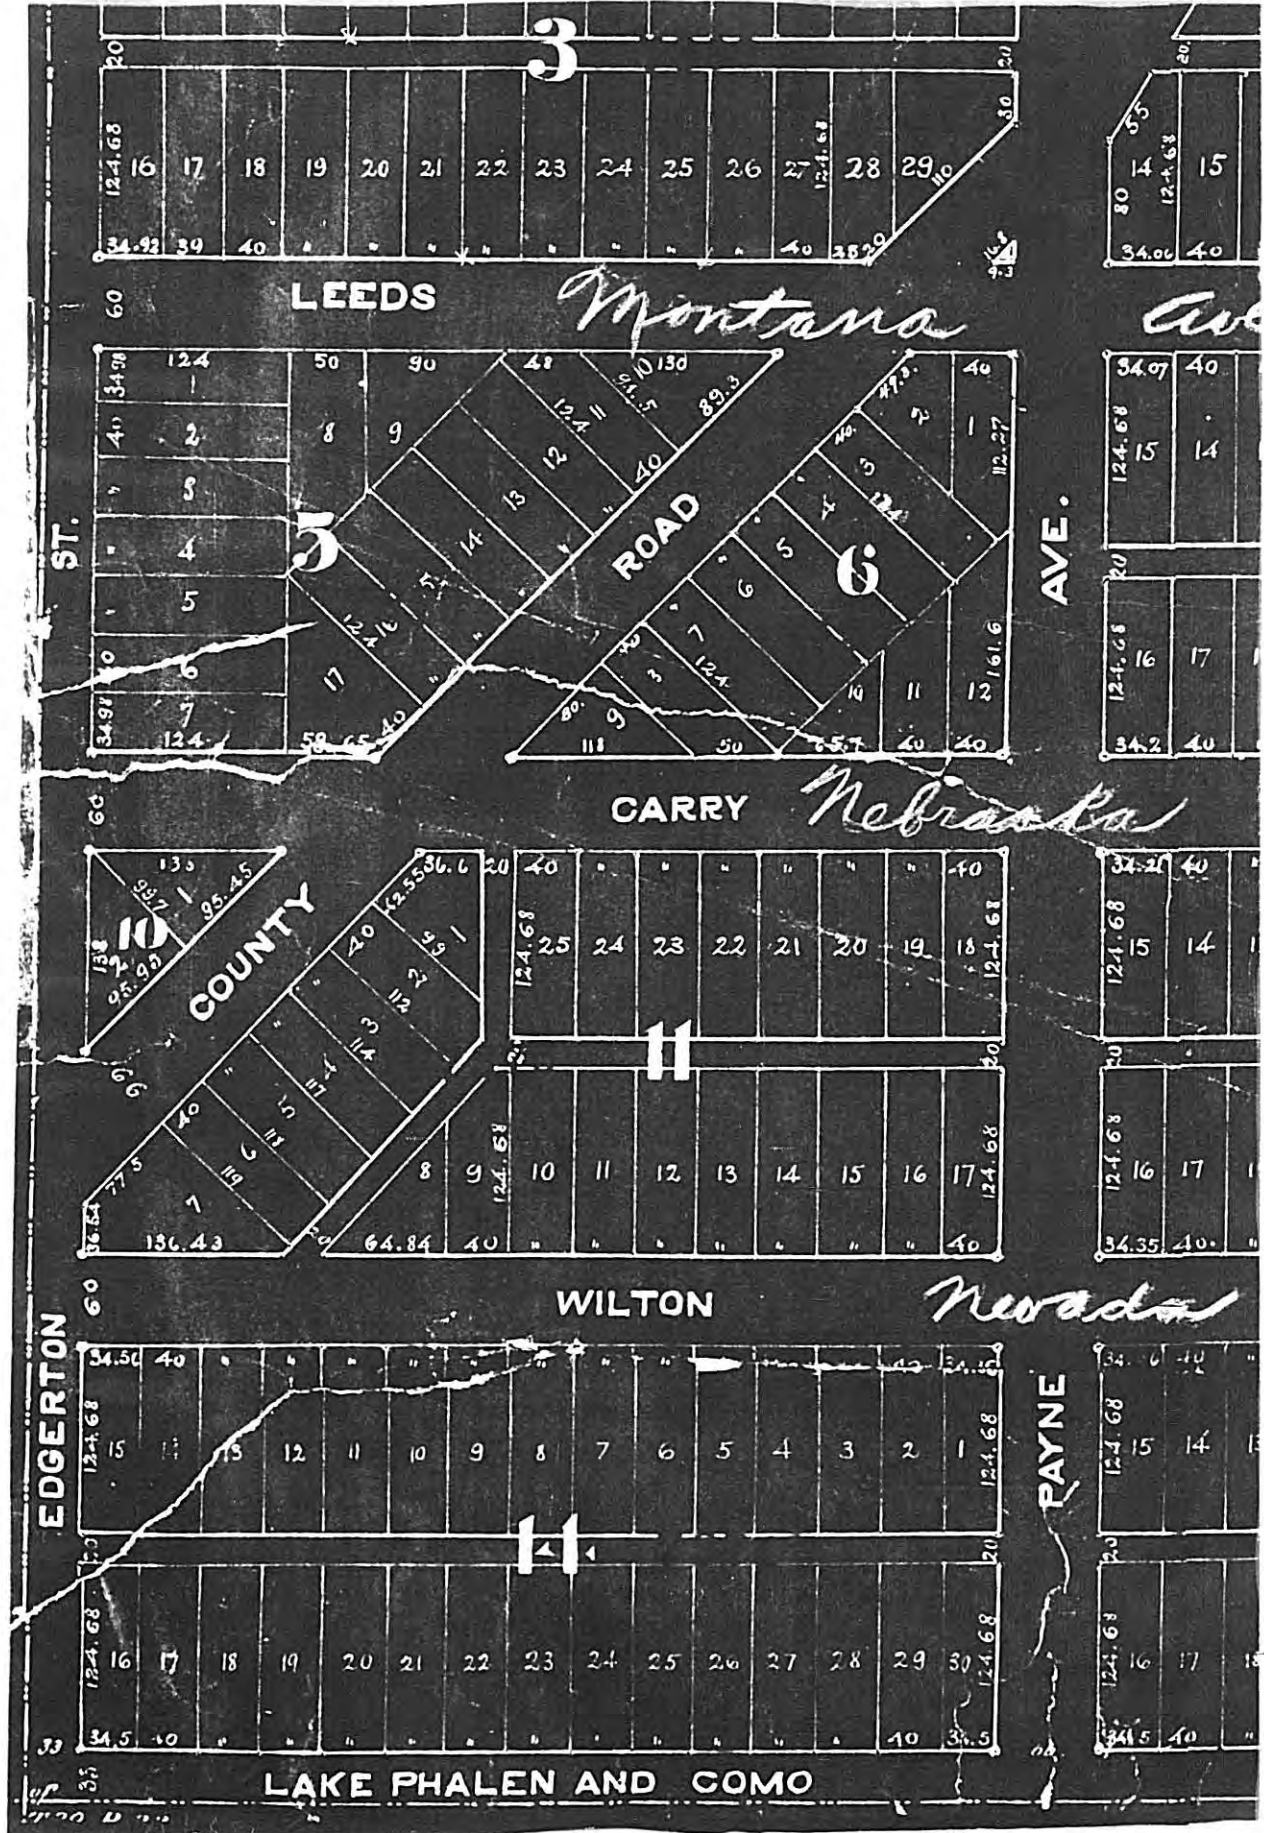

# 10498

R# 347