



MCLEANS RESERVATION

63.5 acres



R# 347
10508

10565

PLAT OF SURVEY

by
R. C. WOLFGRAM
REGISTERED LAND SURVEYOR
ST. PAUL, MINNESOTA

I hereby certify that this is a true and correct plat of a survey of the land shown and described hereon, and that any monuments or markers indicated hereon have been placed as shown, and that any improvements or physical conditions indicated hereon are as shown.

Surveyed Apr., 9, 1962.

R. C. Wolfram

Plat Scale - 1 in. = 60 ft. • Indicates Iron Mont.

Description - The West 5 feet of North 40 feet of South 193 feet of Lot 19; and the East 45 feet of North 150 feet of Lot 20; and the West 40 feet of East 85 feet of North 151.5 feet of Lot 20; and all that part of the North 150 feet of Lot 20 lying West of the East 85 feet thereof; and the North $\frac{1}{2}$ of East 40 feet of Lot 21; all in Block 30, Suburban Hills Addition. (Except part thereof to be taken for street widening)

Lot 11 reserved

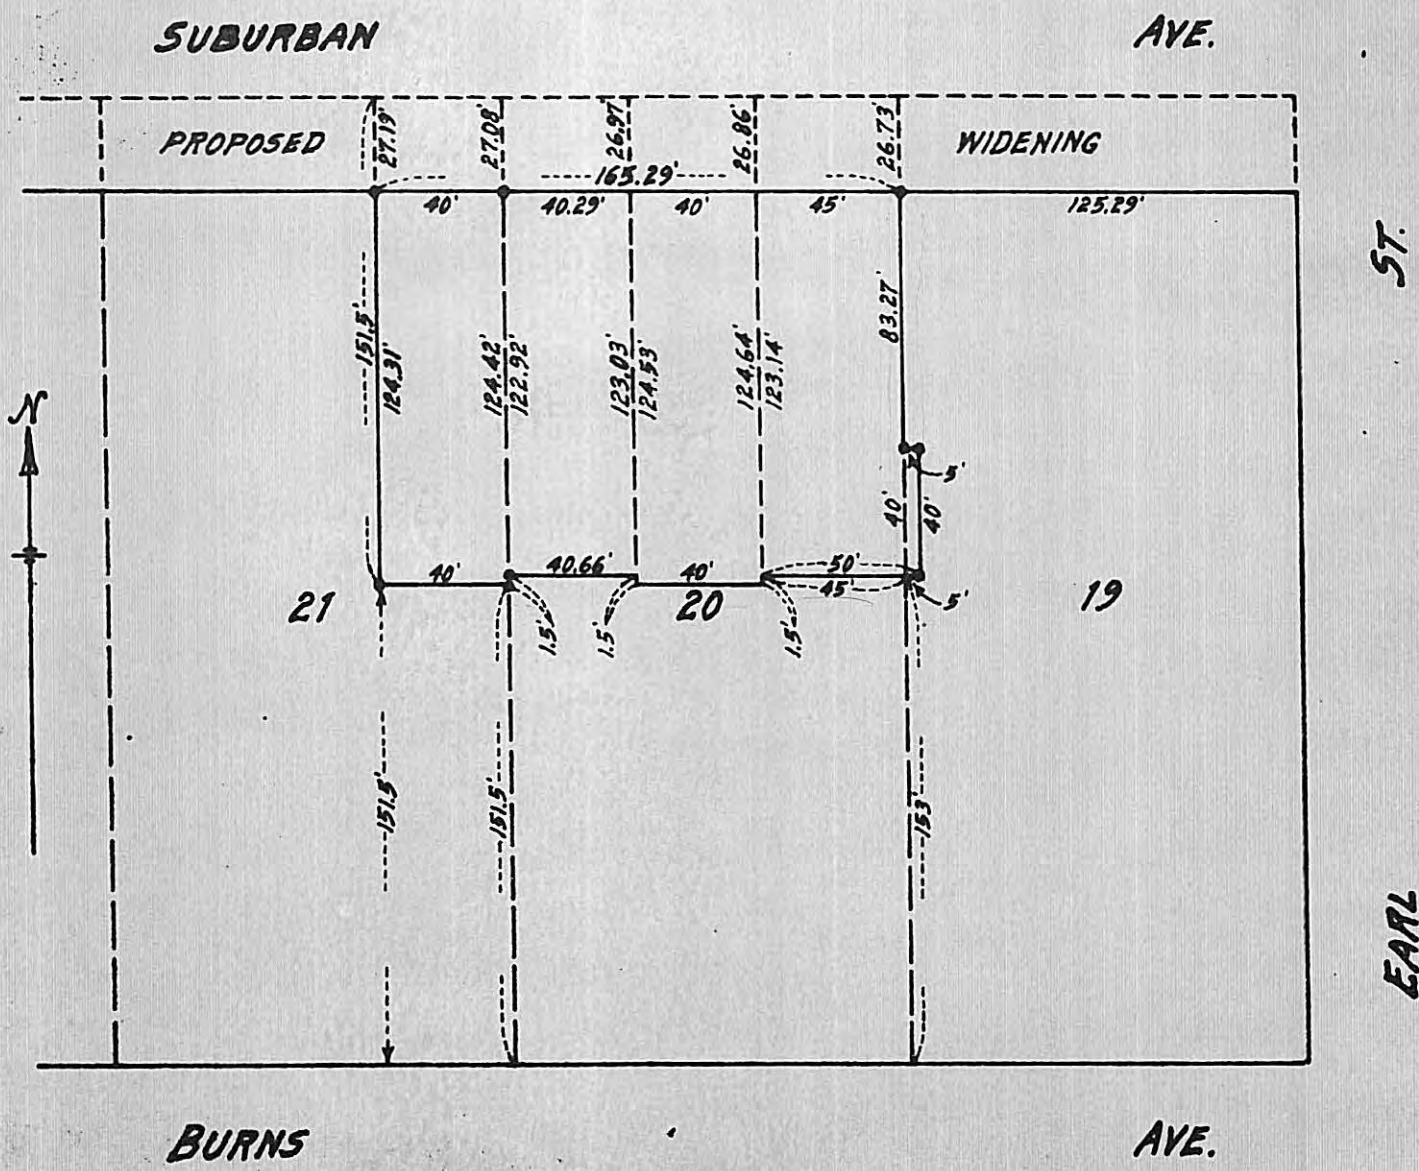


EXHIBIT "A"

10505
R# 347