


1056

CERTIFICATE of SURVEY

FRANKLYN ARMSTRONG CO.
Civil Engineers and Surveyors
ST. PAUL, MINN.

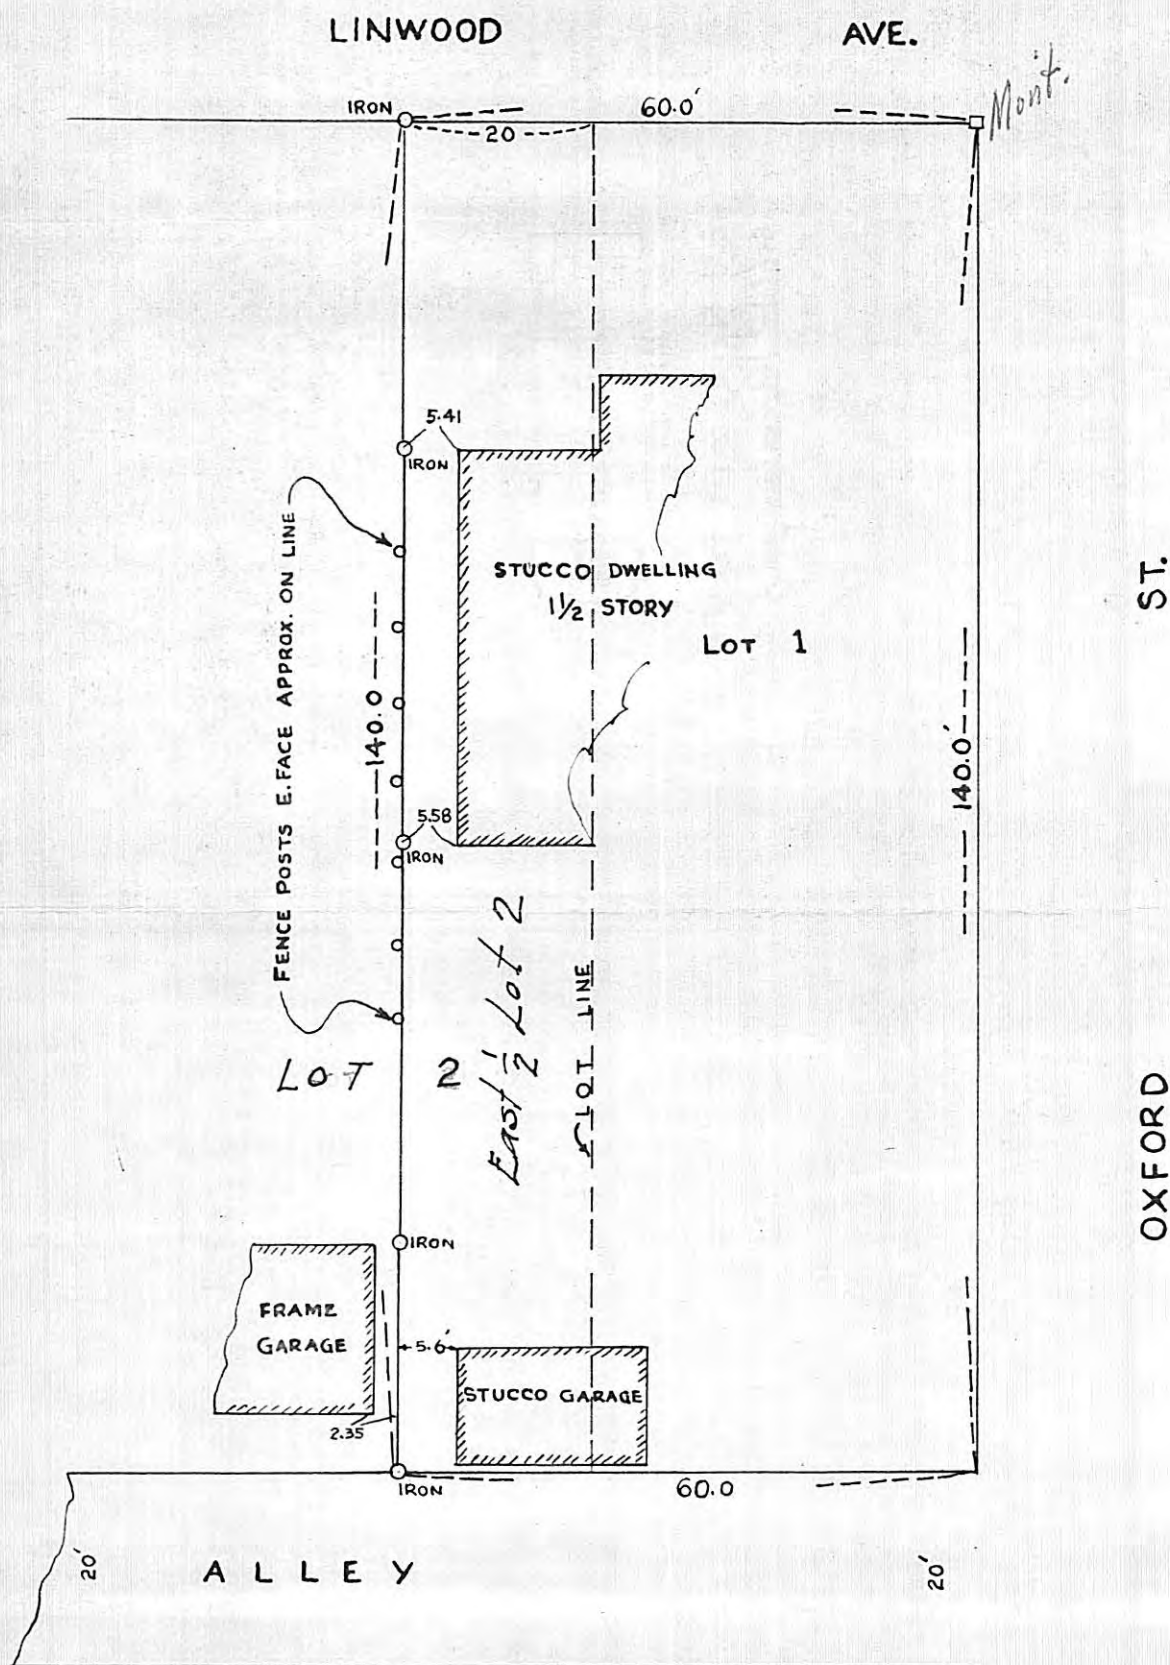

SCALE; 20 FEET PER INCH

I HEREBY CERTIFY that on the 12th day of June, A. D. 1962
I made a resurvey of the following described property, to-wit: LOT 1 AND EAST 1/2 OF LOT 2, BLK. 2
BRYANT'S PARK ADDITION N^o 3, ST. PAUL, MINN.

Subscribed and sworn to before me this
12th day of June, 1962
Erena C. Bach
Notary Public.

and the above map is a true and correct map of said survey and the improvements shown thereon are correctly indicated

My Commission Expires 10-29-63

Franklyn Armstrong
Civil Engineer

10561

R# 349