


PLAT OF SURVEY

OF PROPERTY OF Frank Krejci
 DESCRIBED AS FOLLOWS Lot 20, Block 102, H. M. Ranney's Subdivision of Blocks 101 and 102 Lyman Dayton's Addition

SCALE: 1 INCH = 20 FEET
 o Denotes Old Iron in Right Place

T. J. WELCH, REGISTERED SURVEYOR
 738 SURREY AVENUE, ST. PAUL 6, MINN.

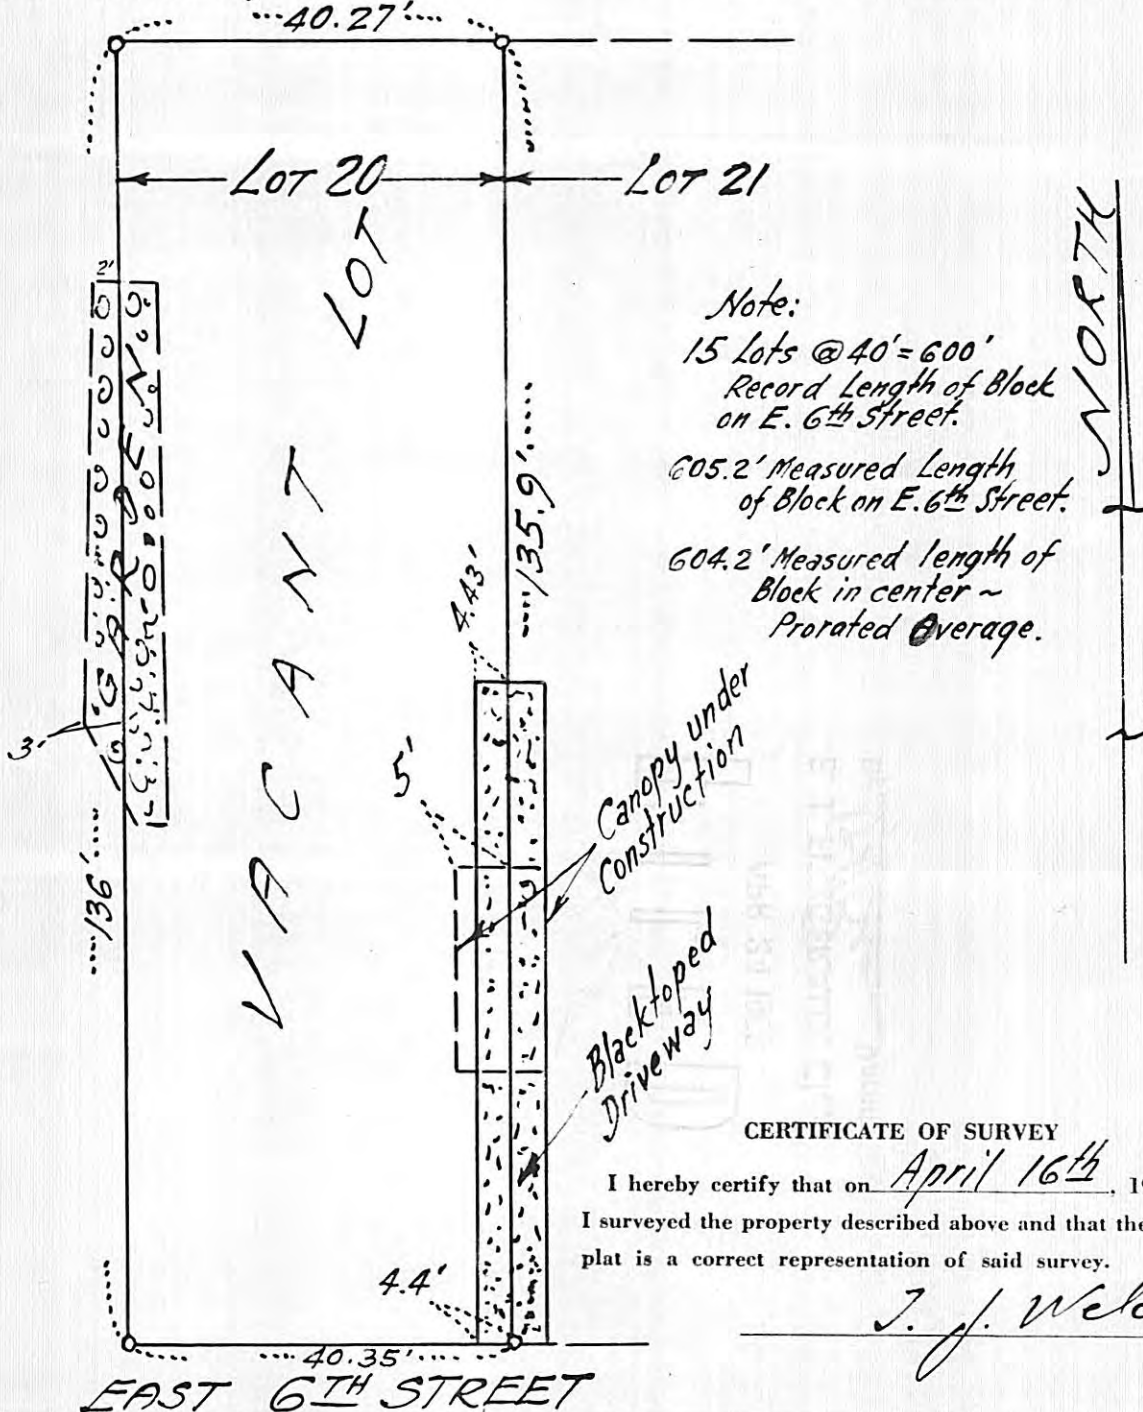

CERTIFICATE OF SURVEY

I hereby certify that on April 16th 1963
 I surveyed the property described above and that the above plat is a correct representation of said survey.

T. J. Welch