

CERTIFICATE OF SURVEY

DESCRIPTION ASHTON & SHERBURNES ADD
LOT 15, BLK 13 AND THE SLY 12 FT. OF THE
ELY 100 FT. OF LOT 16, BLOCK 13

SCALE 1/4" = 3 FT.

Subscribed and sworn to before me this
 day of _____ A. D. _____

St. Paul, Minn. May 11, 1940


I certify to having surveyed the above described property
 and that all distances and locations as hereon shown are
 correct.

Notary Public, Ramsey Co., Minn.
 My Commission Expires _____

James & Wm. E. Pedersen
 Surveyor, 210 Globe Bldg.

JACKSON ST.

#1062

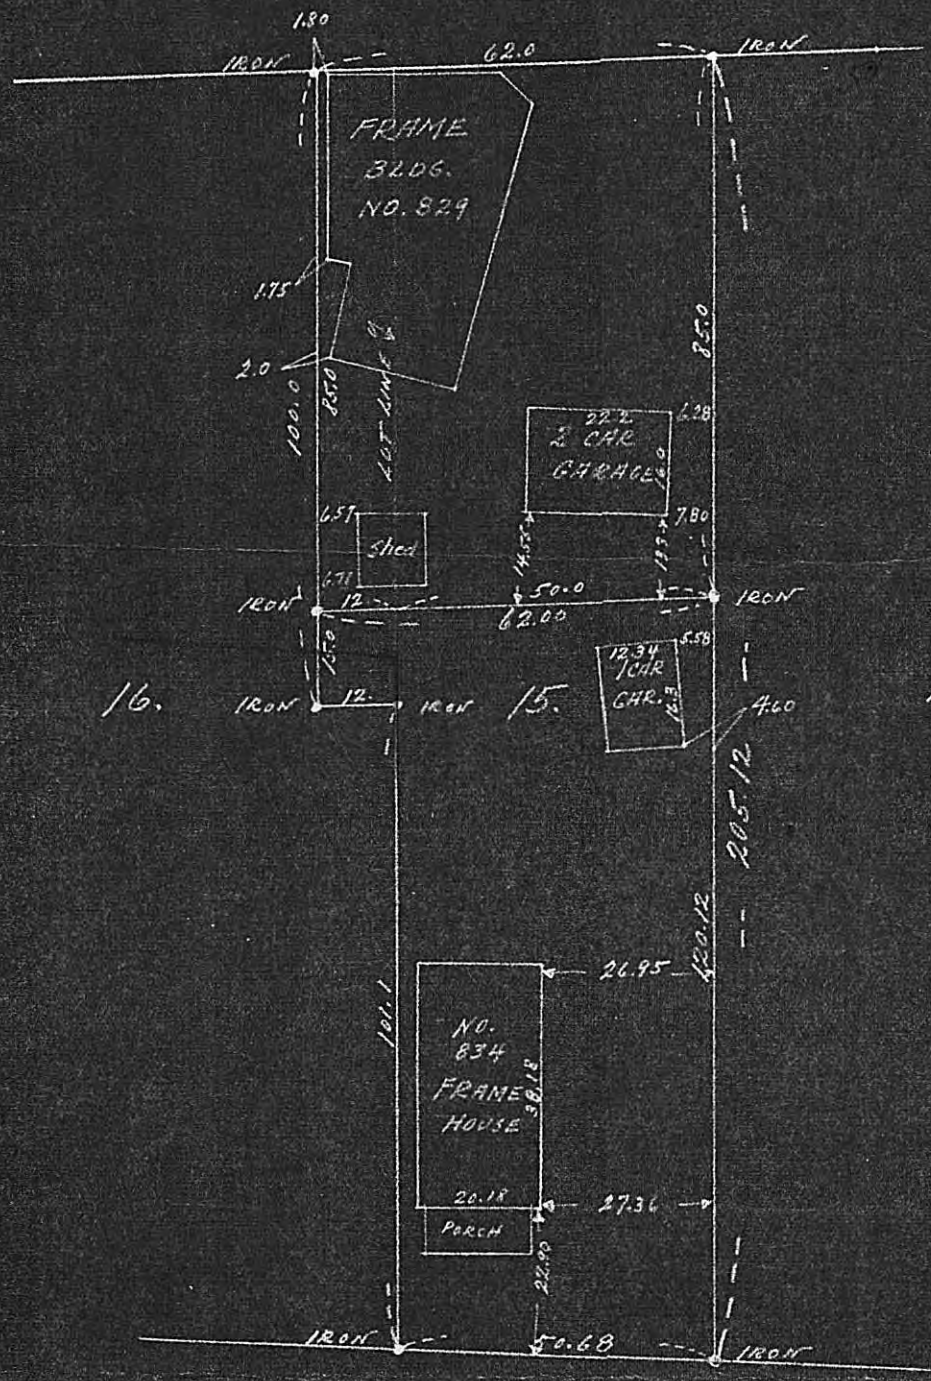

CAPITAL HEIGHTS