

ST. Fourth

file 10661




PLAT OF SURVEY OF LOT 13th
PART OF LOTS 4-5 & 6 IN BLOCK 23
IN WHAT IS COMMONLY KNOWN AS
ST. PAUL PROPER

Scaled 20 ft. per inch
Surveyed by me in May 1945
J. Bruce Long - Civil Engr.

ST.

WABASHA

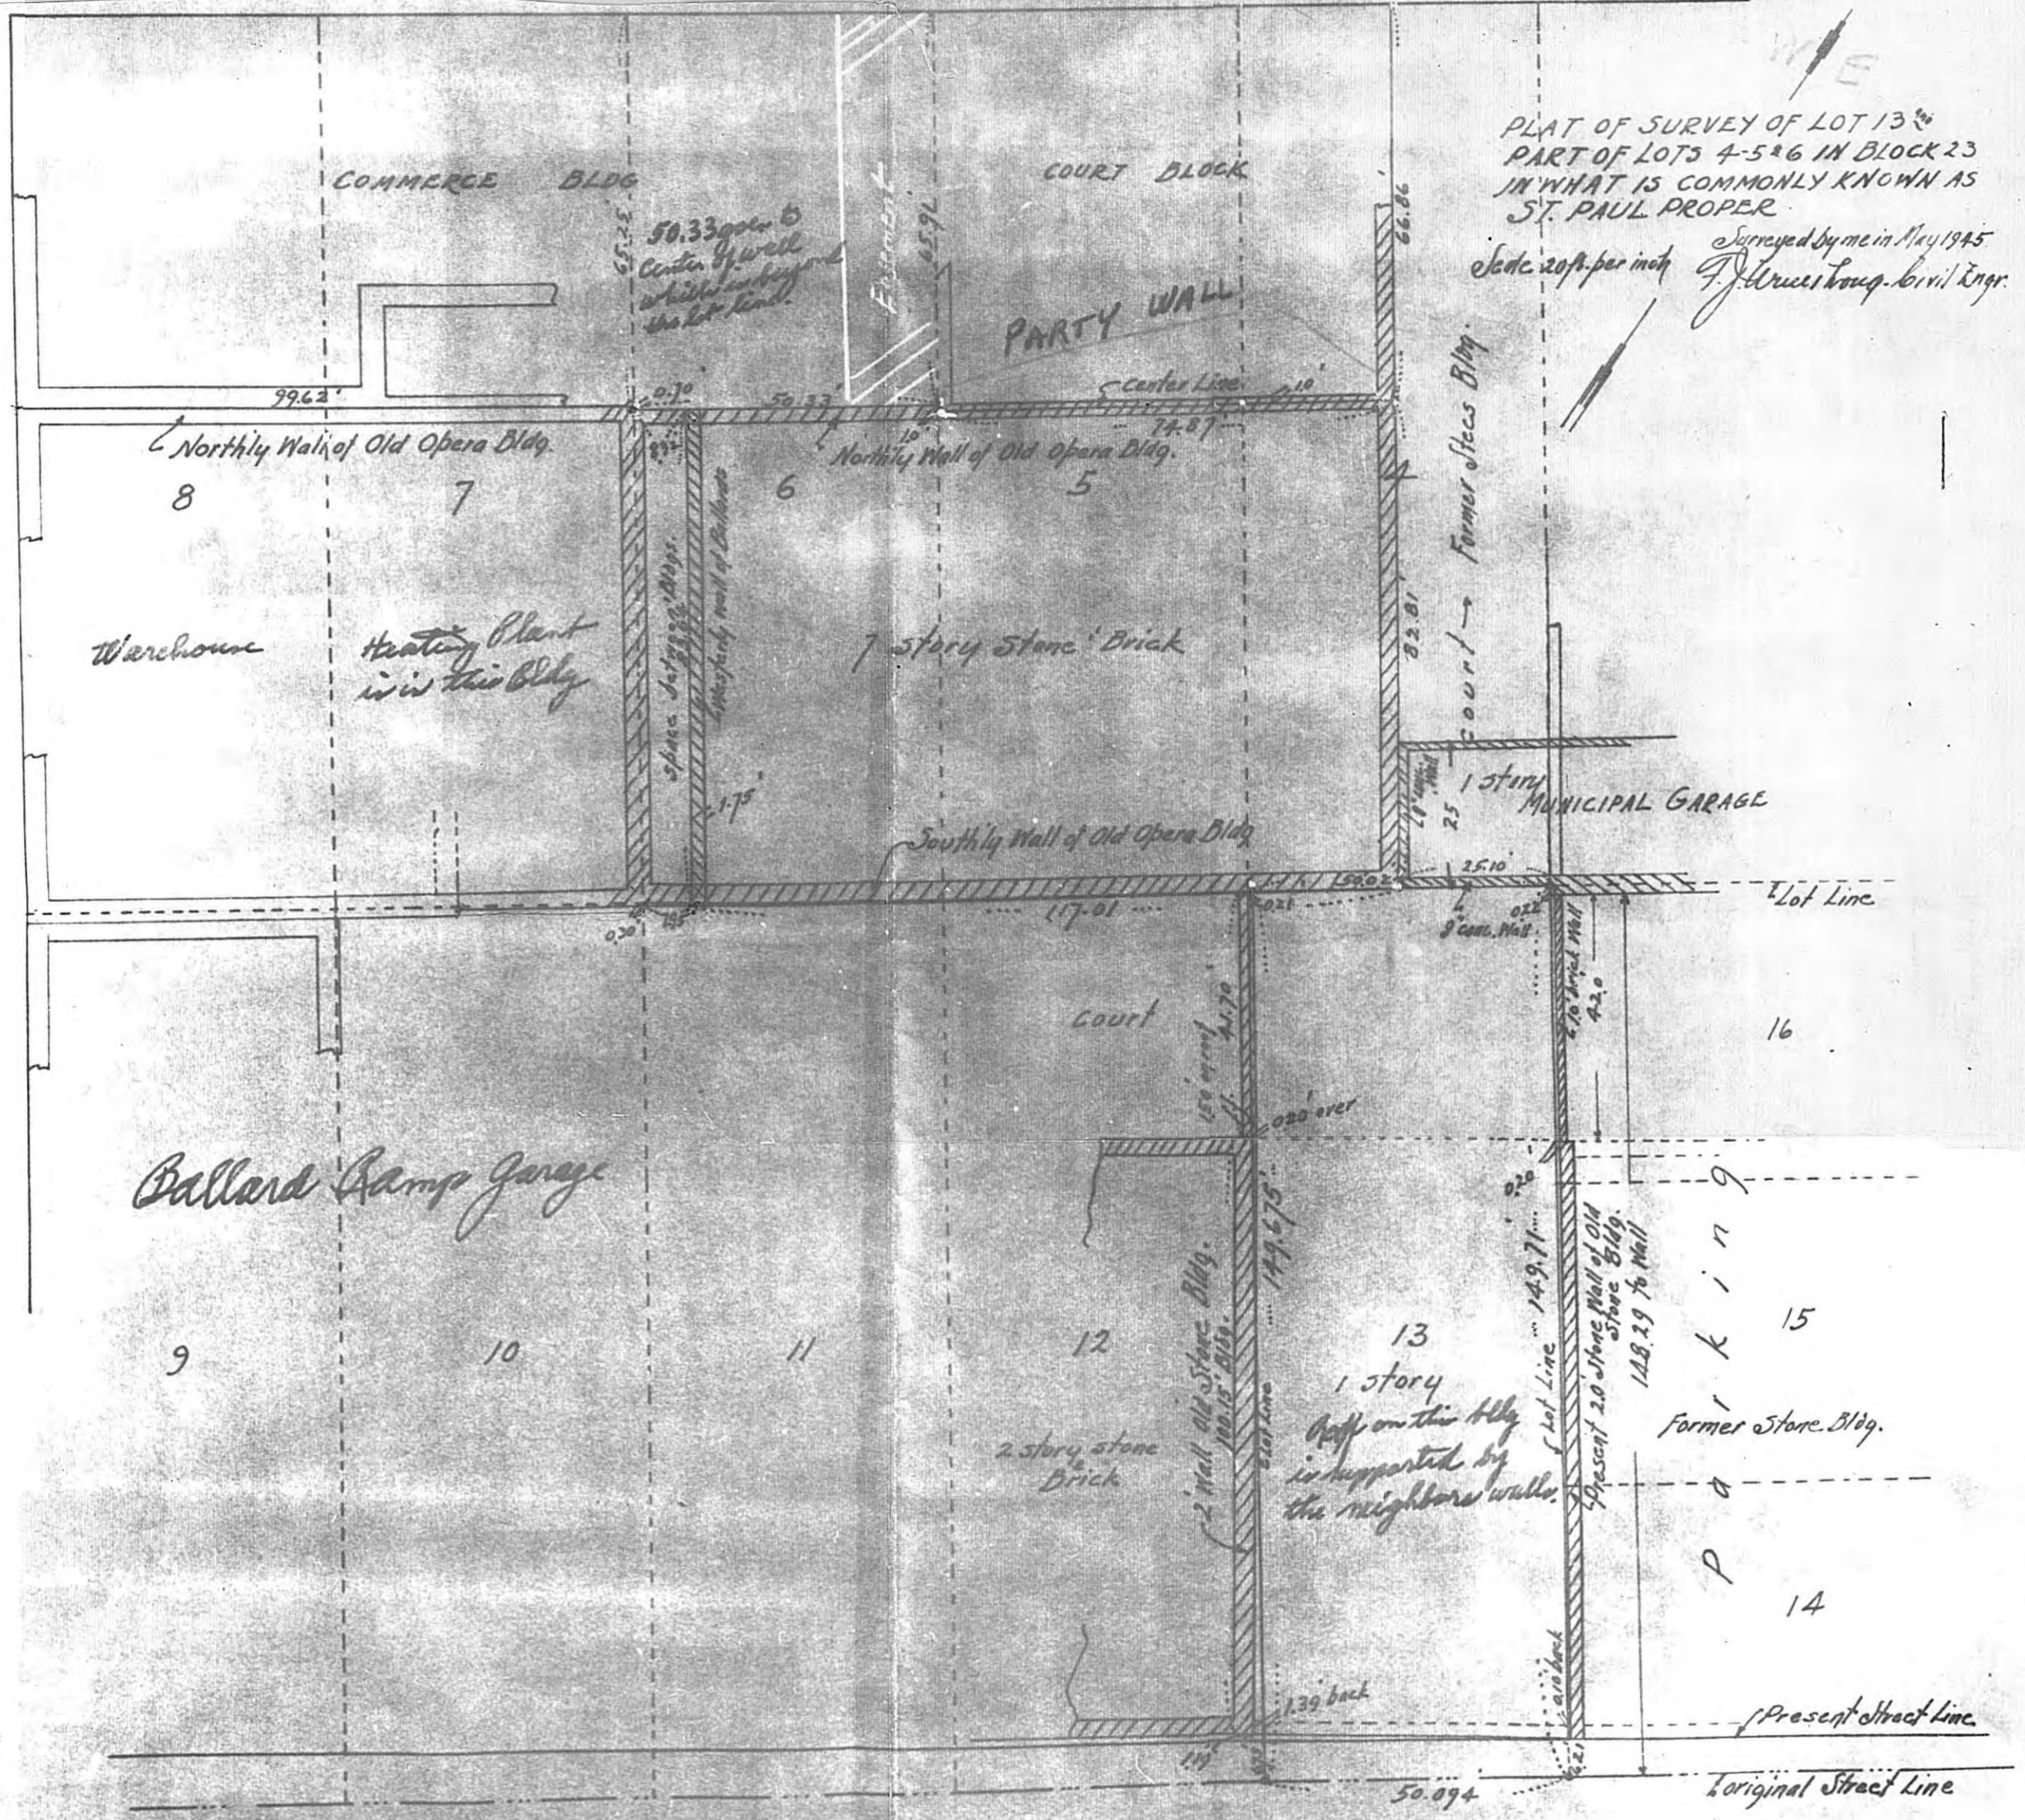

E. KELLOGG

BLVD.