file 10717

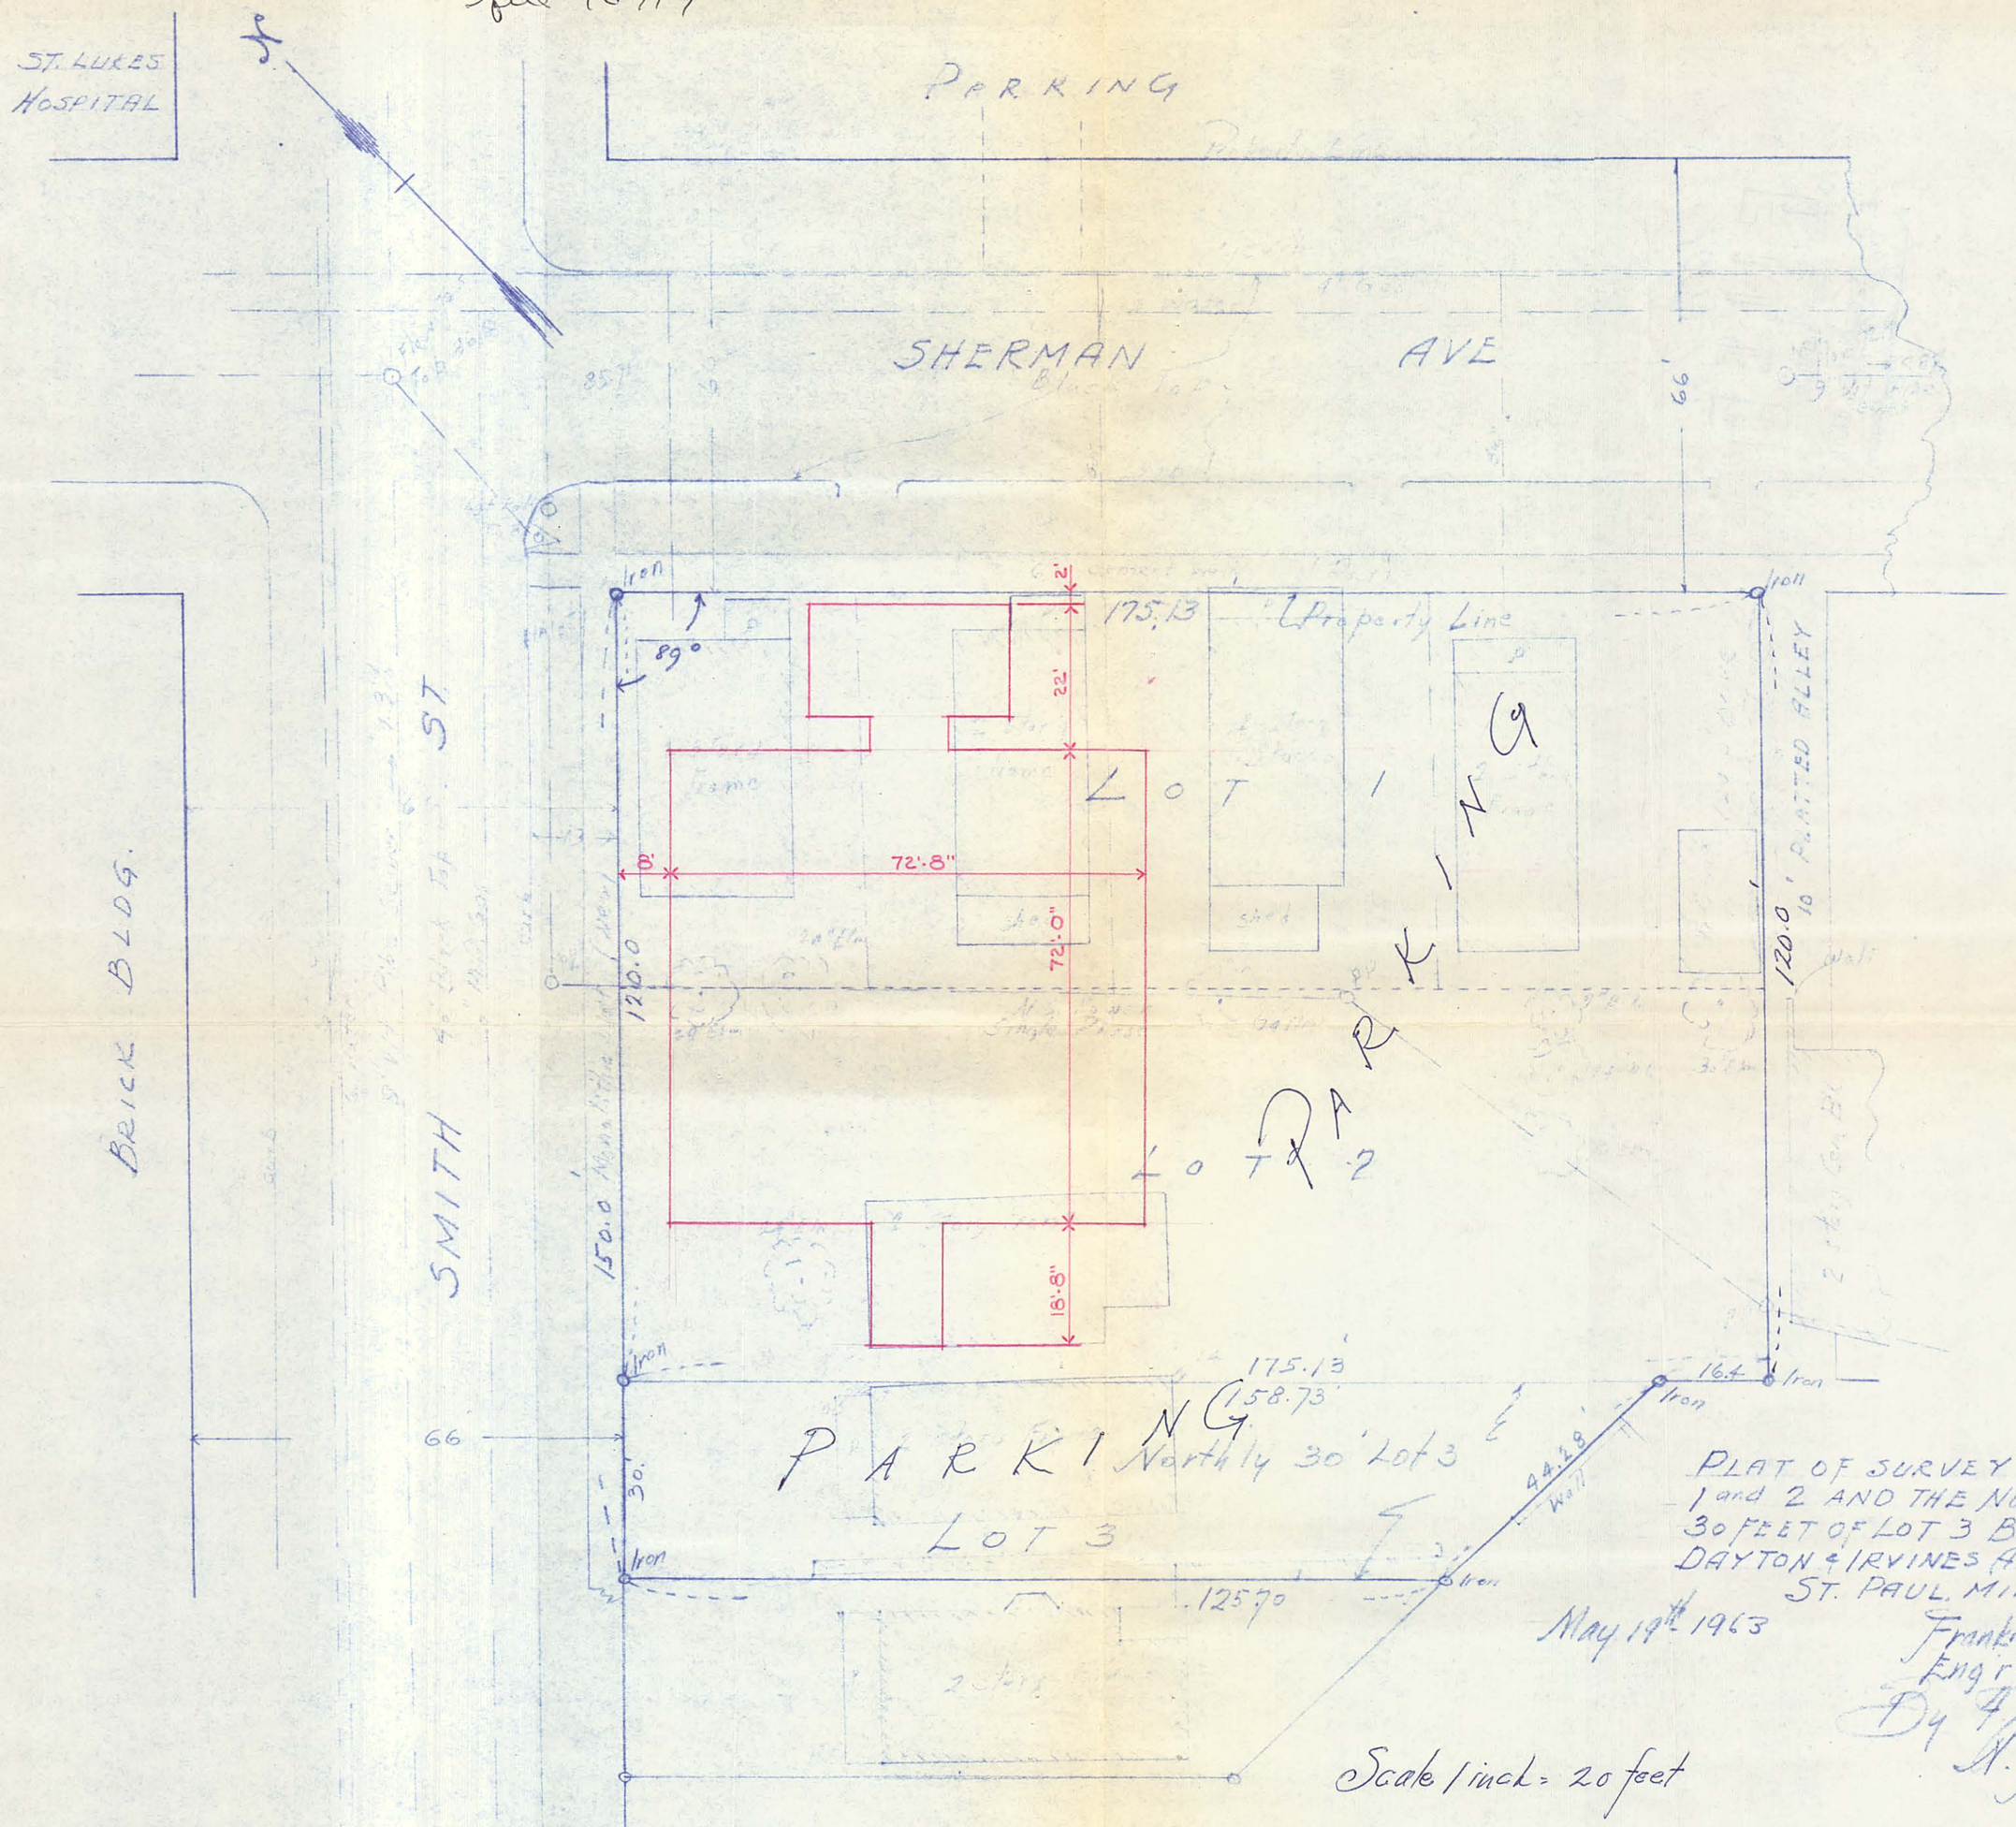

PLAT OF SURVEY OF LOTS 1 and 2 AND THE NORTHLY 30 FEET OF LOT 3 BLOCK 50 DAYTON & IRVINES ADDITION ST. PAUL, MINN.

May 19th 1963

Franklyn Armstrong Co.
Engrs & Surveyors
By F. J. Armstrong
N. York Bldg.

I hereby certify that th is plat correctly represents the property herein outlined, that the delineations ar e true and correct, that the iron monuments and distances thereon shown are true and correctly p laced.

Franklyn J. Armstrong
Surveyor

Subscribed and sworn ay of November, 1963.
to before me this 13th d

MAY 23 1963