


File 10800

NEURER'S ADD.

SCALE 100 FT TO THE INCH

Edward Hoerck Surveyor December 3 1881

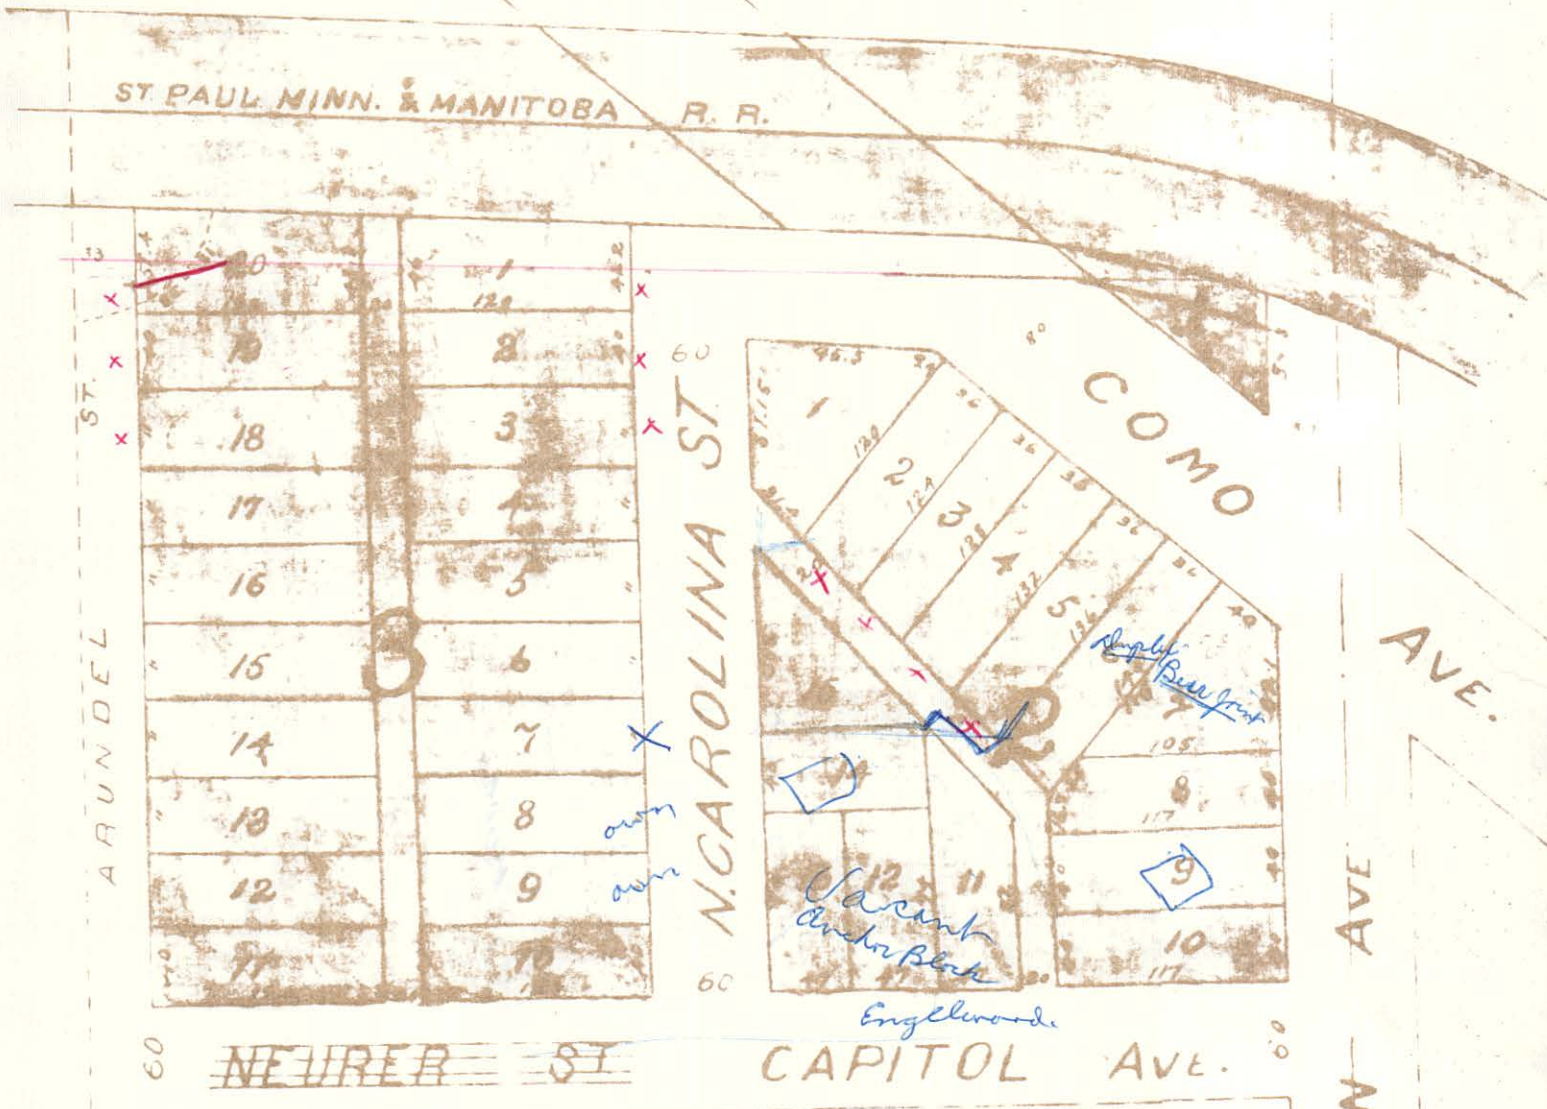

Lots 1-2-3 Block 3	11820	Sq ft
" 18-19-20 " 3	12370	" "
" 12-13-14 " 3	1470	" "
" 8-9 " 3	960	" "
Total Block 3	26620	
Lots 1-2-3 Block 2	25000	
1-15 " 2	4000	
Total	77350	" "

25
36

MINNEHaha ST