


RIVERVIEW INDU


STS. & 1
DUNWELL & 1
TO BR
LANGEVIN
LANGEVIN
HITCHCO
WALTON'S

VA
CITY
DEPT. 31
31

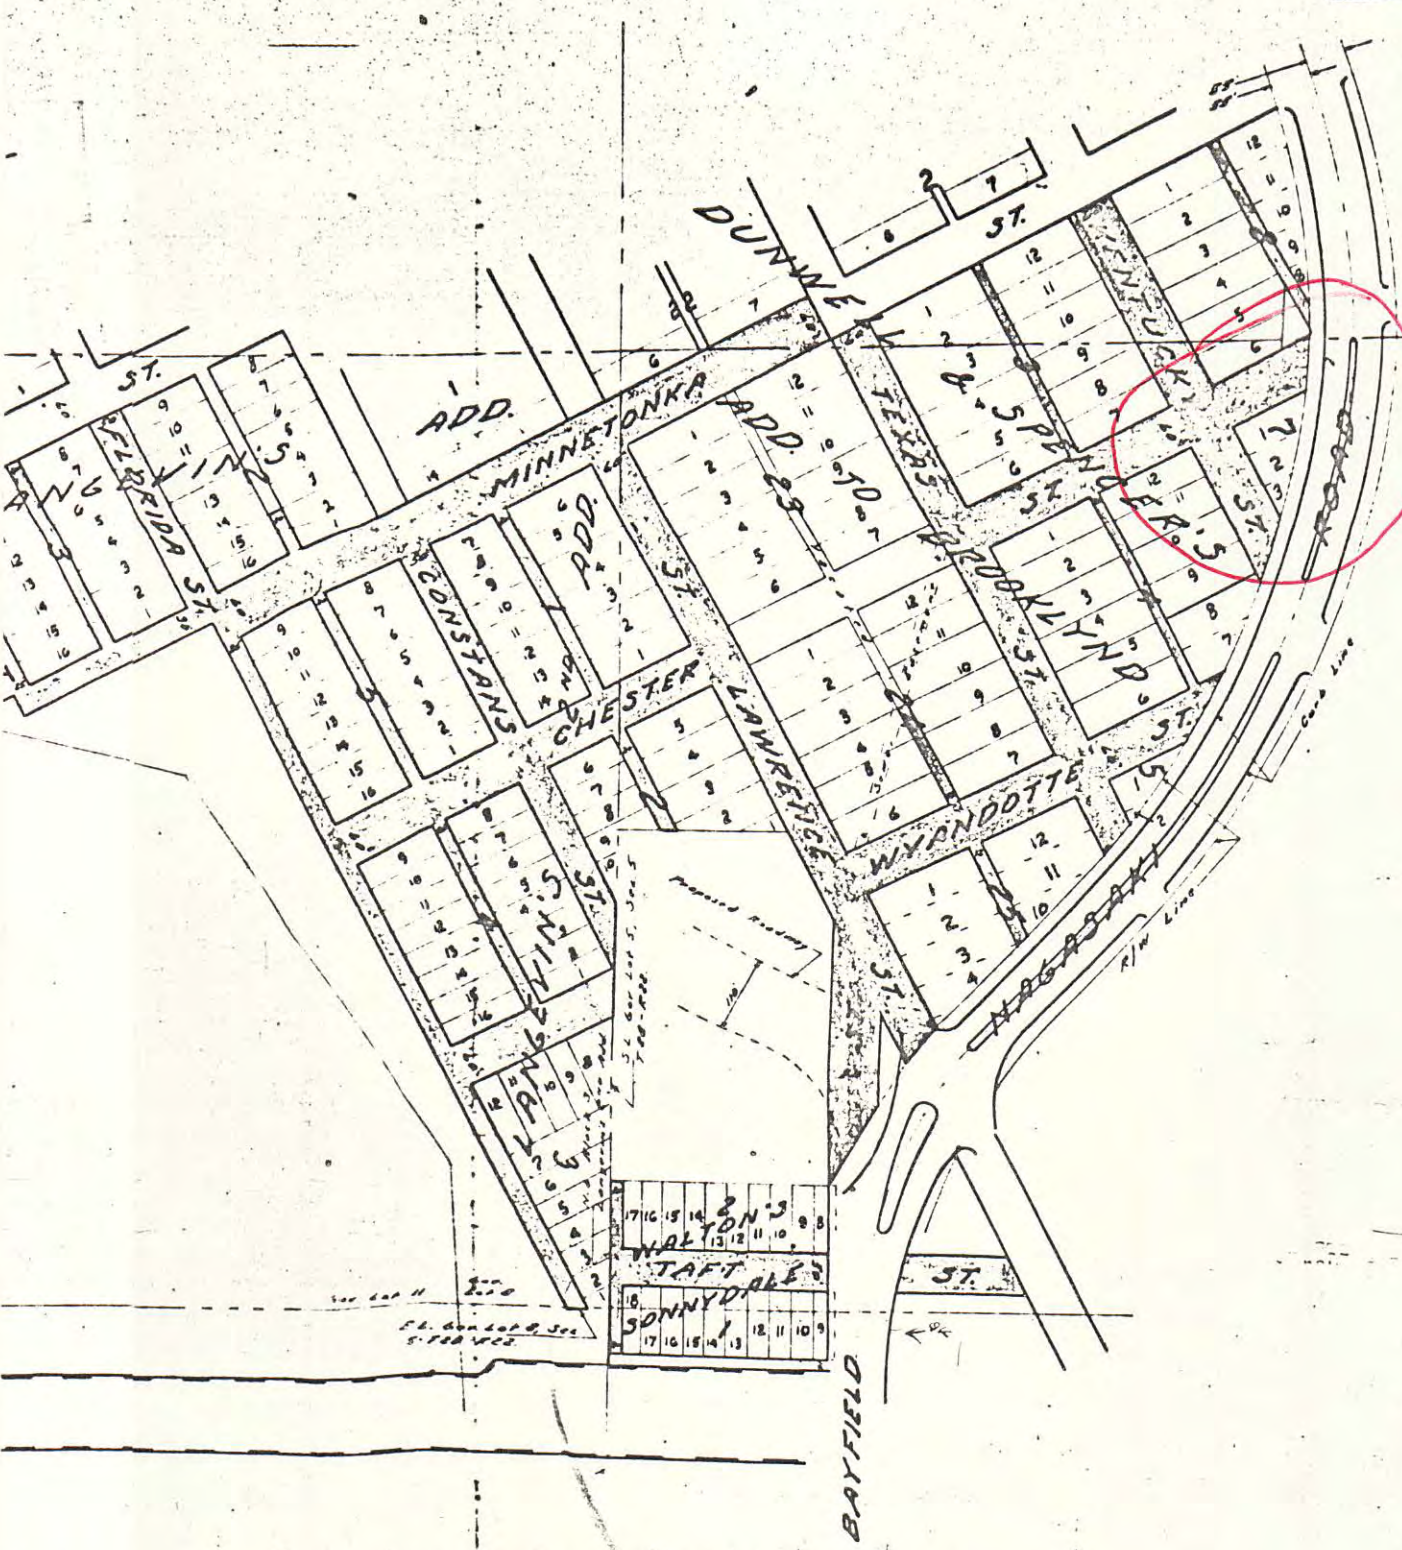

10885
R# 360

143769

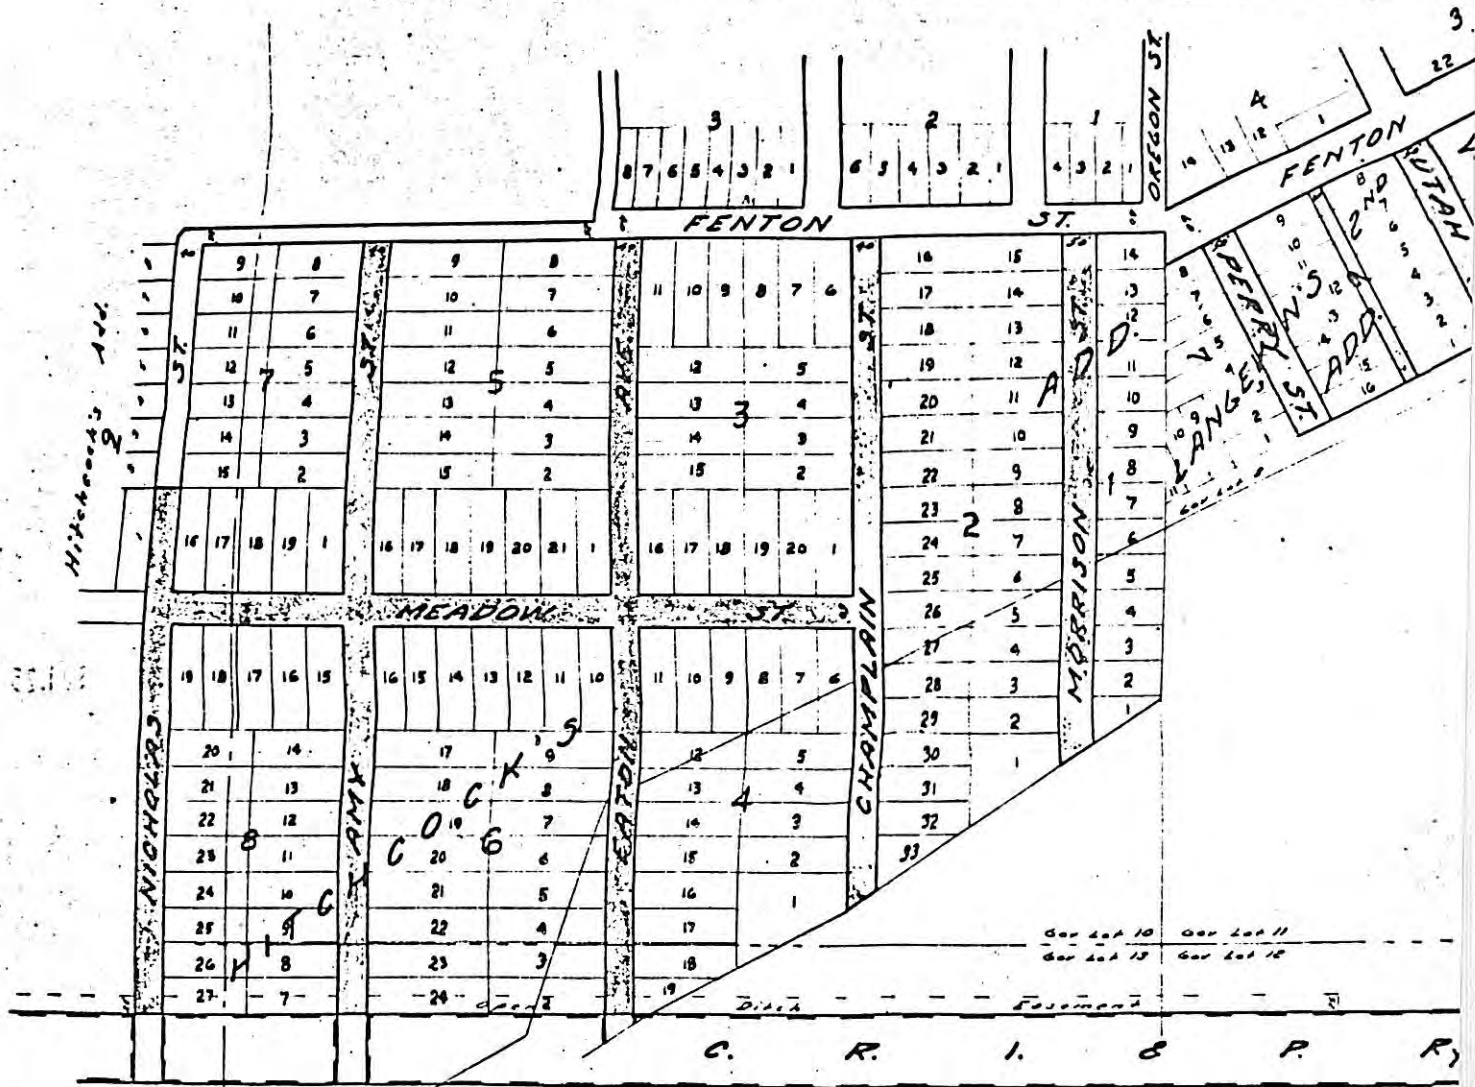

DIVERVIEW
D. PK. AREA
VACATION
Map No. 1742

10885

R# 360