SCALE: 1 INCH 20 FEET

THE E. B. McDONOUGH CO.
1953 UNIVERSITY AVE., SAINT PAUL 4
814 NATIONAL BUILDING, MINNEAPOLIS 2

TELEPHONES FE. 5-6611 MI. 6-6858 MI. 9-5072

PLAT OF SURVEY

OF PROPERTY OF Robert A. Menge - 321 Bates Ave. St. Paul

DESCRIBED AS FOLLOWS See attached for complete legal description

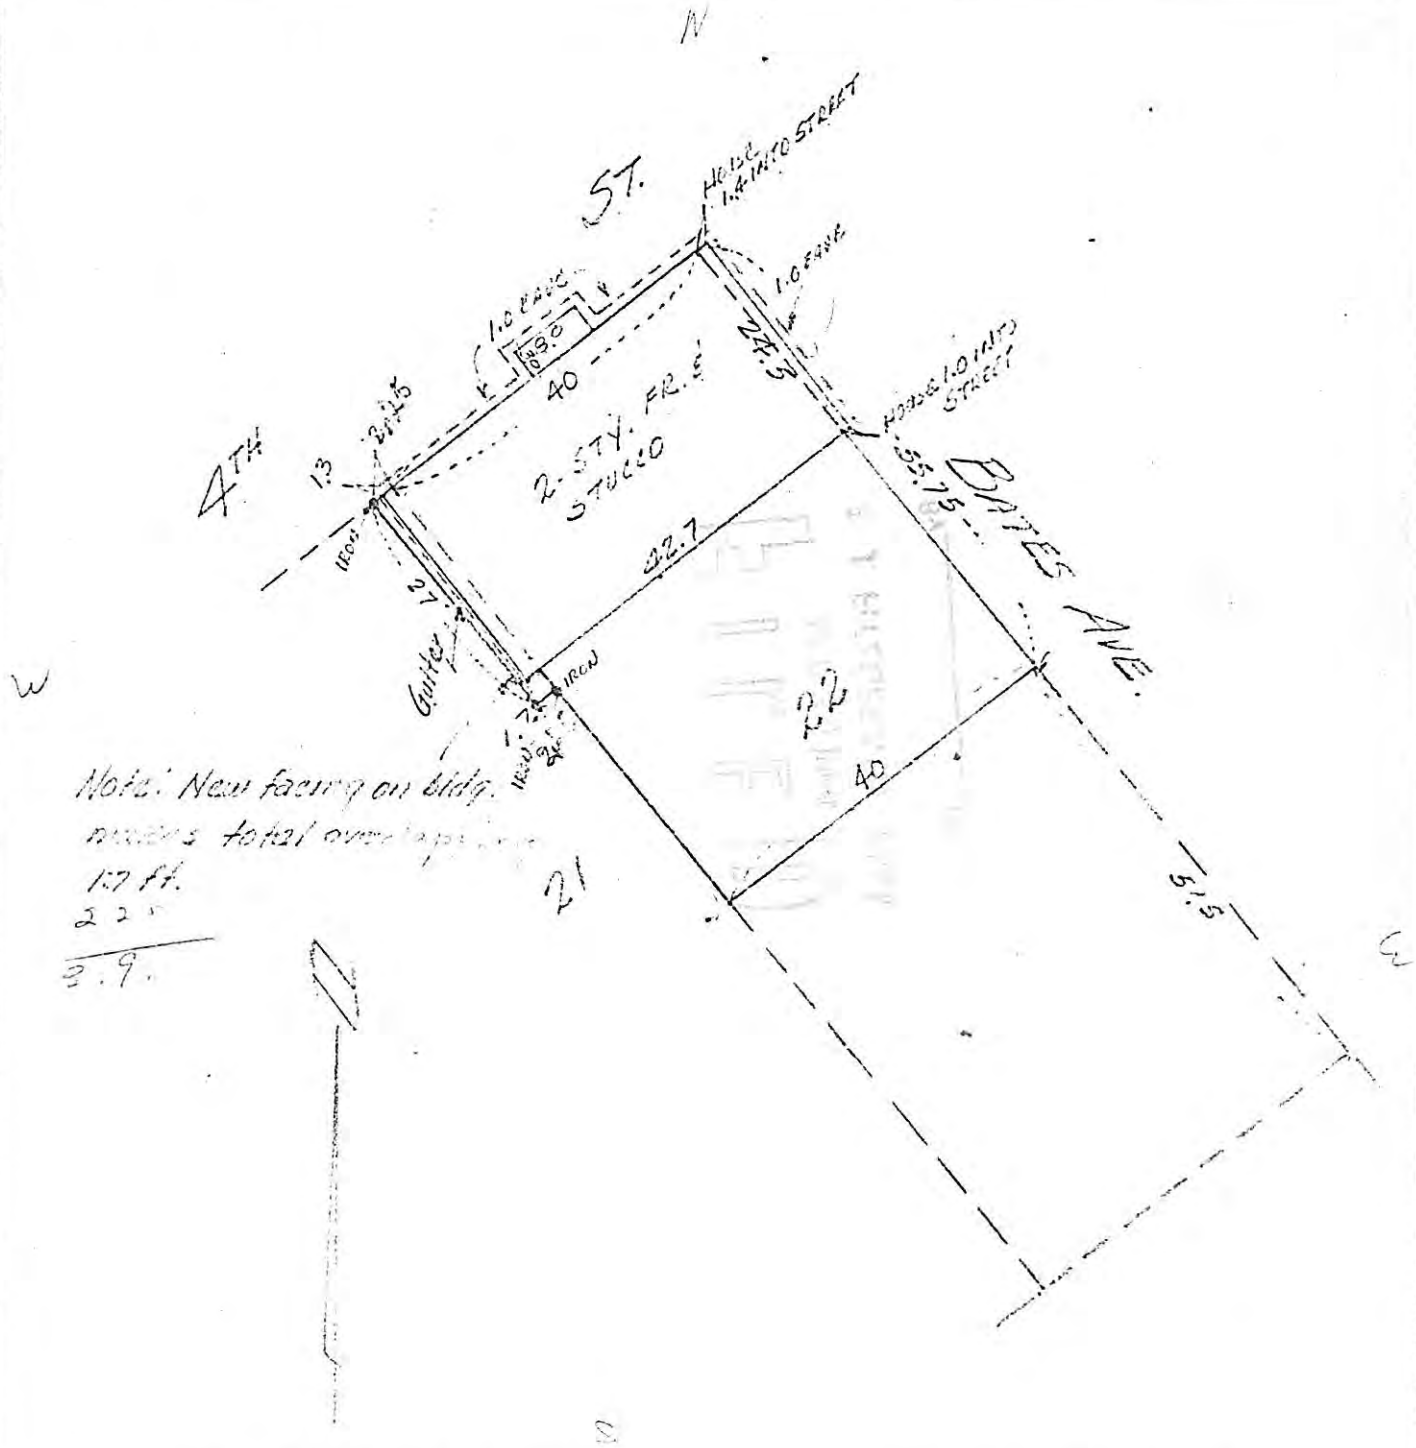

Note: New facing on bldg. makes total overlapping 1.7 ft.
2.2
3.9

CERTIFICATE OF LOCATION OF BUILDING

I hereby certify that on _____ 19__ I made a survey of the location of the building(s) on the above described property and that the location of said building(s) is correctly shown on the above plat.

E. B. McDonough

CERTIFICATE OF SURVEY

I hereby certify that on _____ 19__ I surveyed the property described above and that the above plat is a correct representation of said survey.

E. B. McDONOUGH, REGISTERED SURVEYOR. No. 1990
PAUL J. CRANE, " " No. 4449
JOHN J. RYAN, " " No. 4489

10890

R# 361

Form No. 133 25 McClain Hedman Schuldt Co.