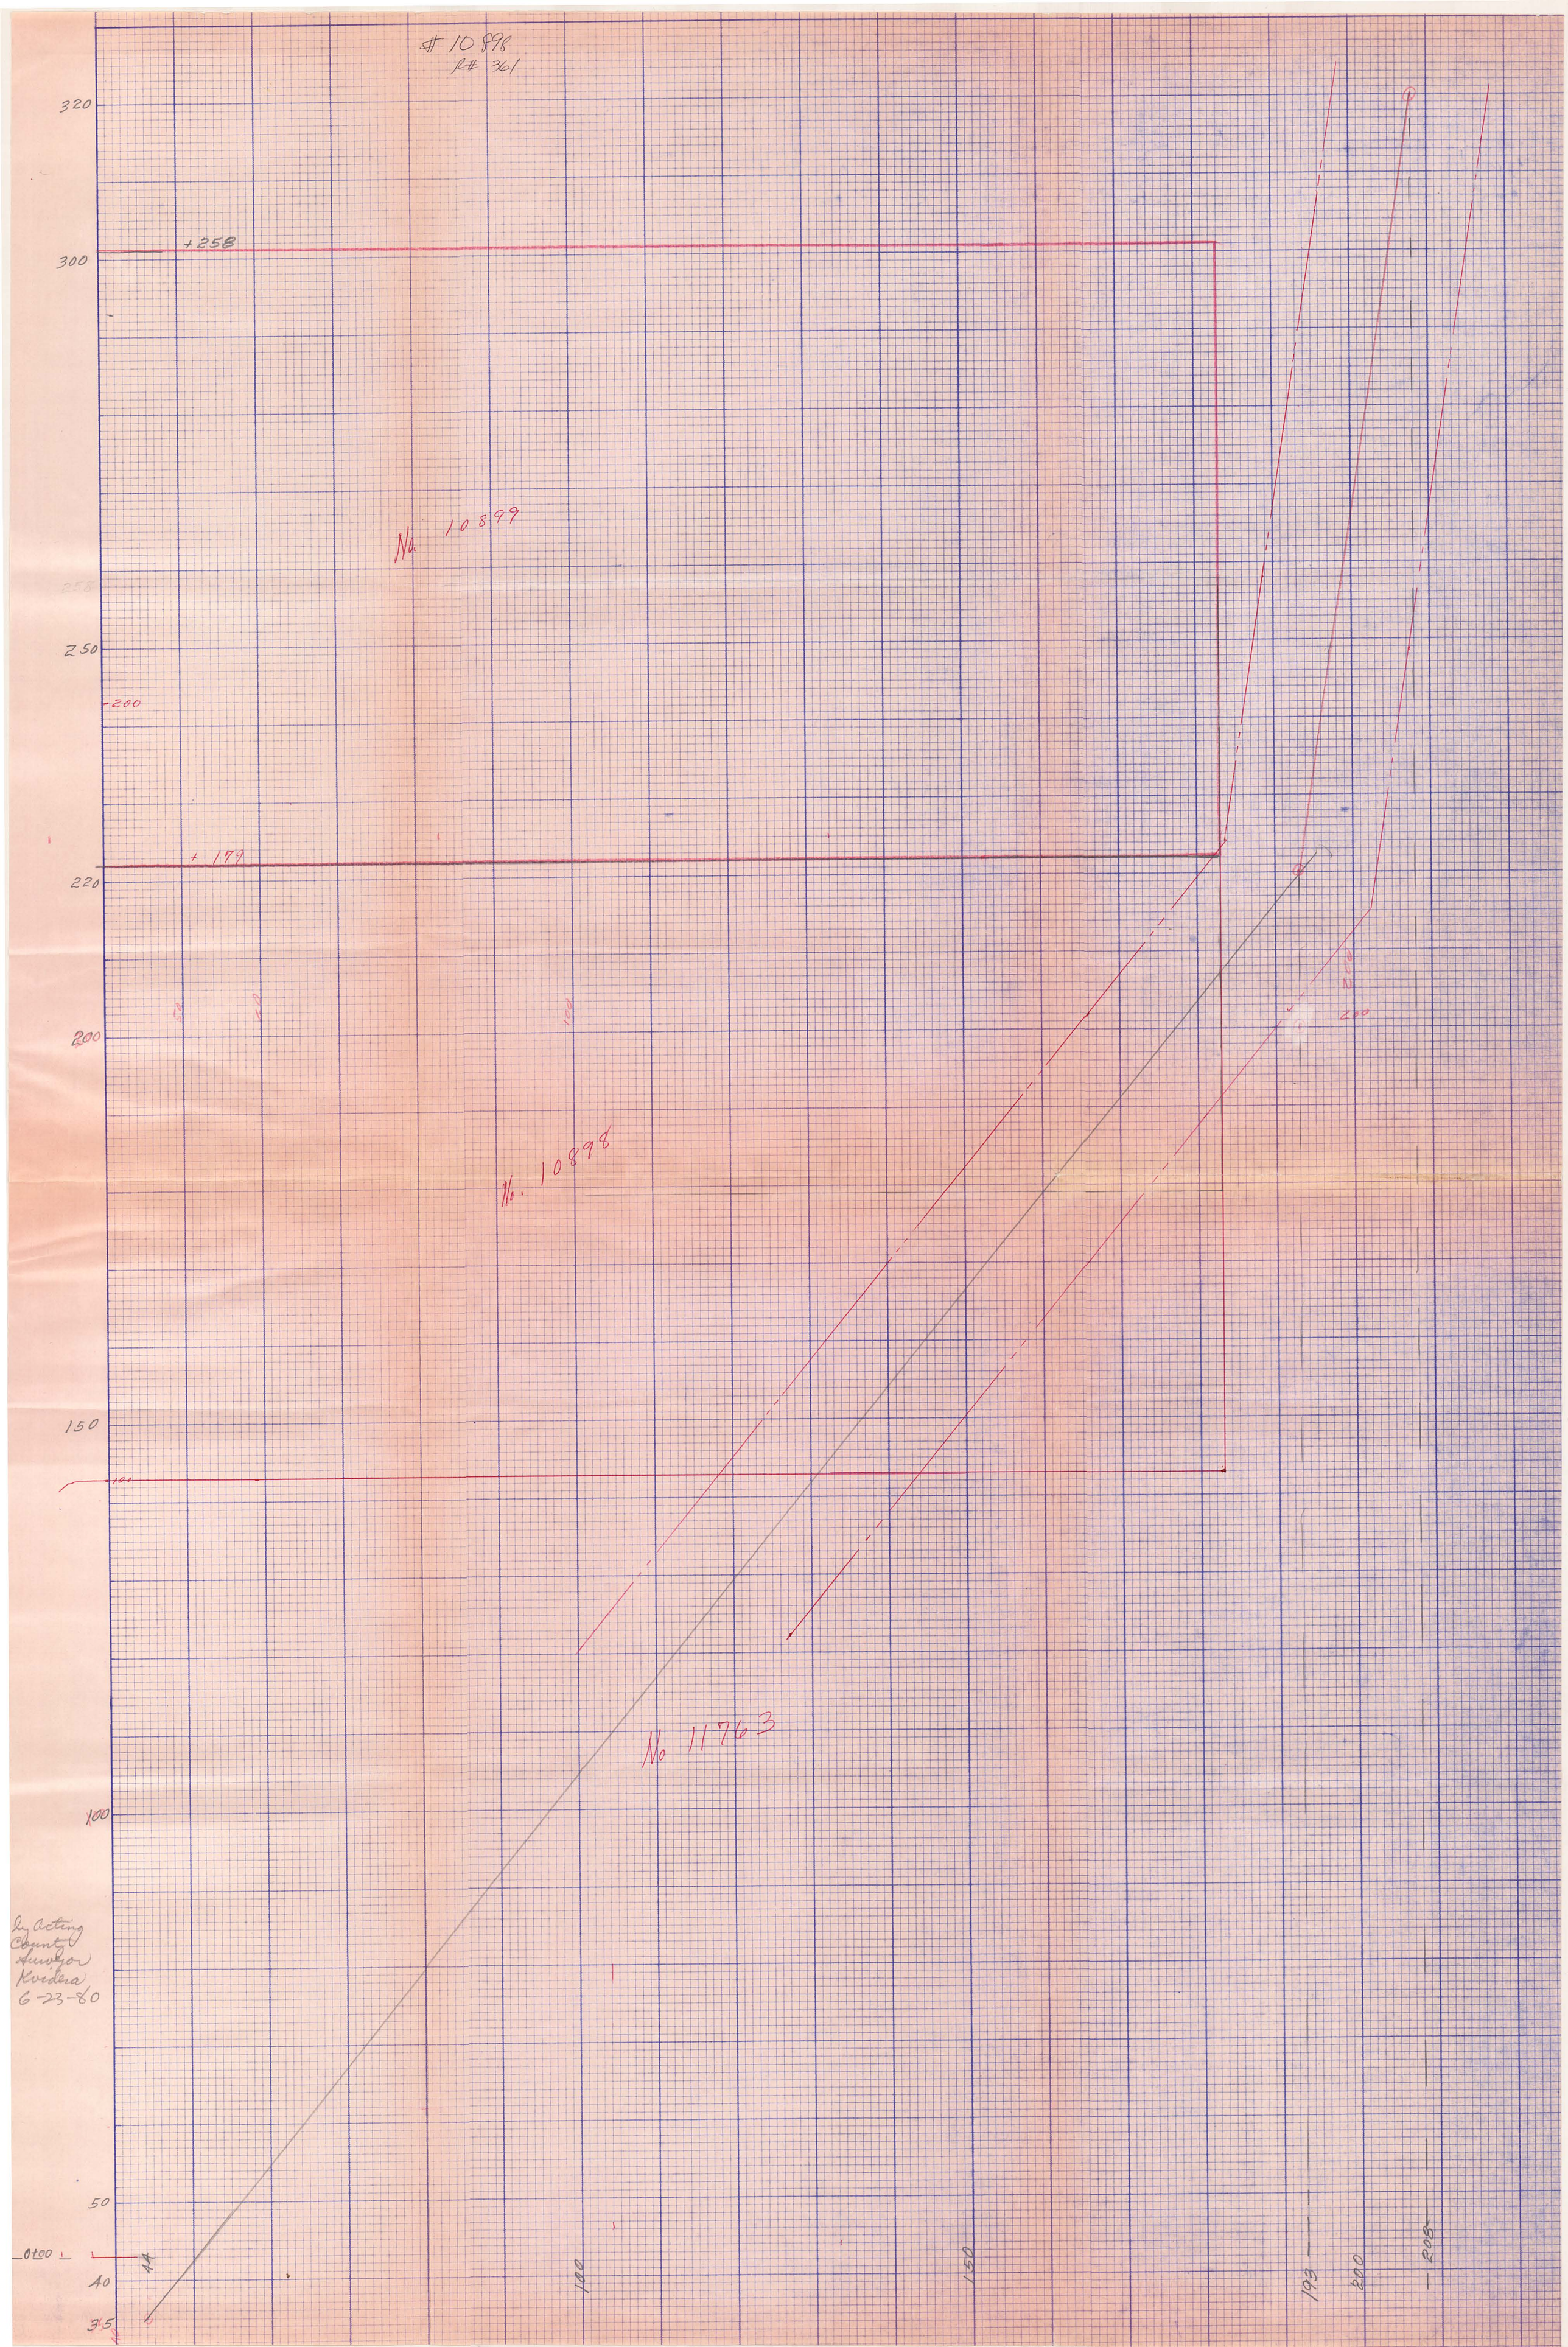
#10898
R# 361
320
300
+258
No. 10899
250
200
+179
220
200
No. 10898
150
100
No 11763
100
50
0+00
40
35
44
100
150
193
200
208
by Acting
County
Surveyor
Kvidera
6-23-80

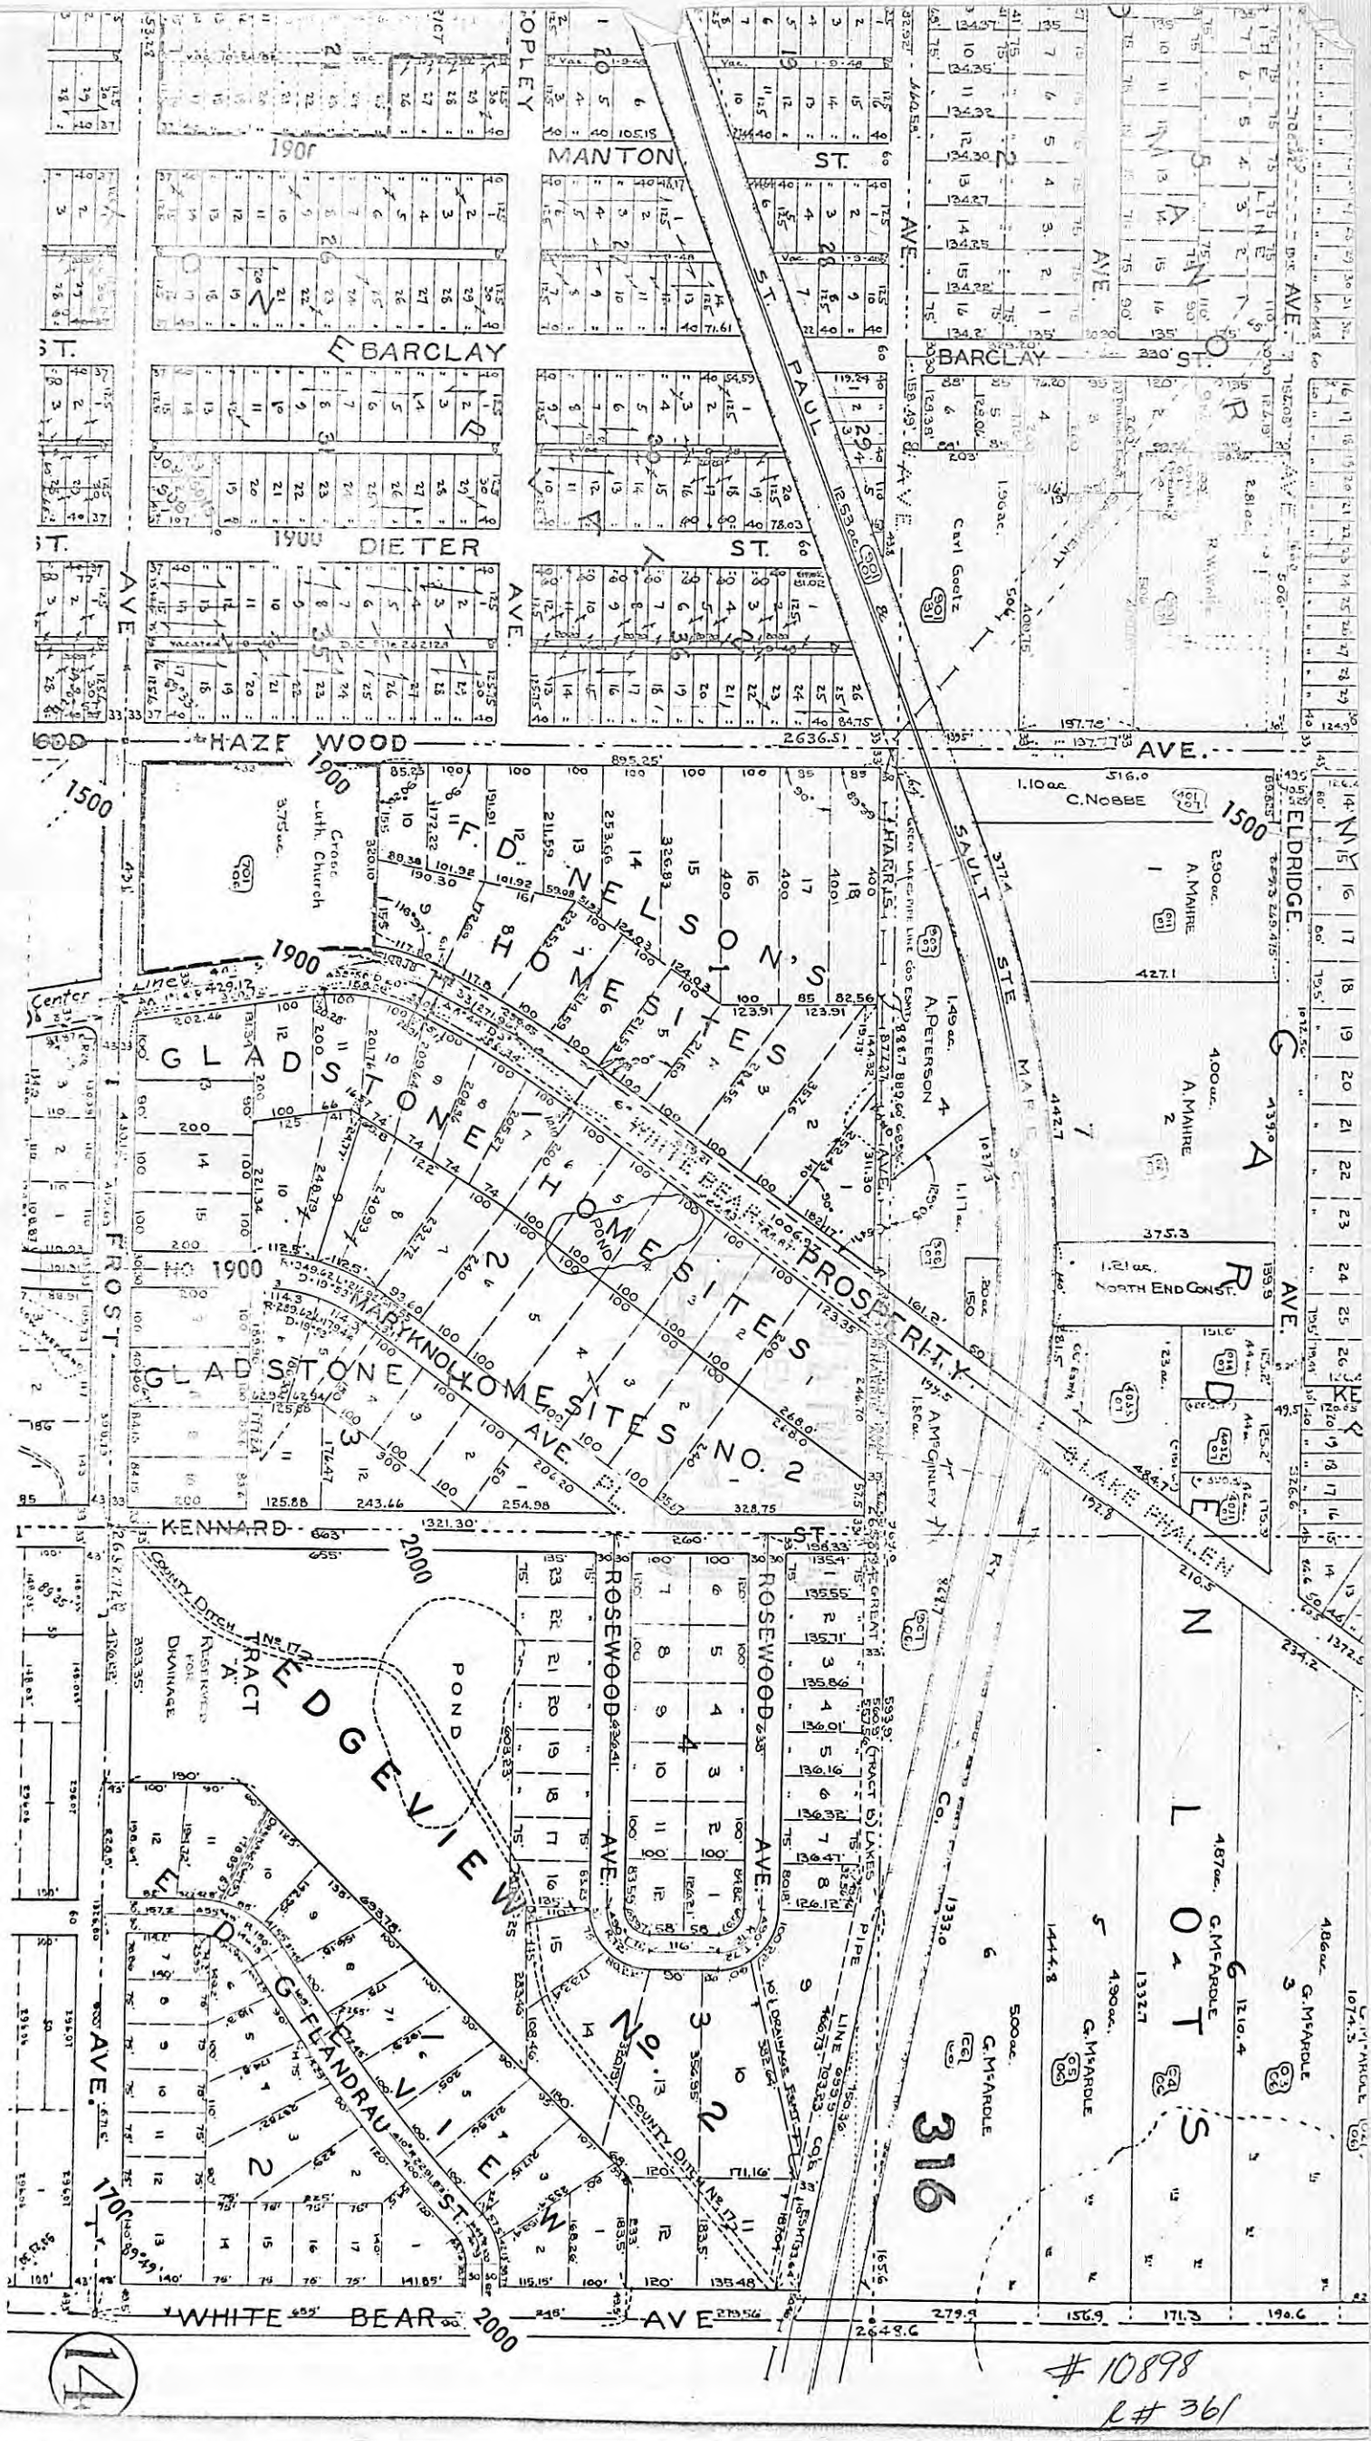
MANTON ST.
BARCLAY
DIETER ST.
HAZE WOOD AVE.
ST. PAUL AVE.
SAULT STE MARIE
ELDRIDGE AVE.
F. D. NELSON'S HOMESITES
GLADSTONE HOMESITES
GLADSTONE HOMESITES NO. 2
PROSPERITY
KENNARD ST.
ROSEWOOD AVE.
EDGEVIEW
EDGEFLANDRAU ST.
WHITE BEAR AVE
POND
Grace Luth. Church
C. NOBBE
A. MAIRE
A. PETERSON
NORTH END CONST.
A. McGINLEY
G. McARDLE
Carl Goetz
FROST AVE.
KEY AVE.
316

#10898
R# 361