Crew: R.M.
P.K
P.D.

March 20, 1980

COUNTY DITCH No 17

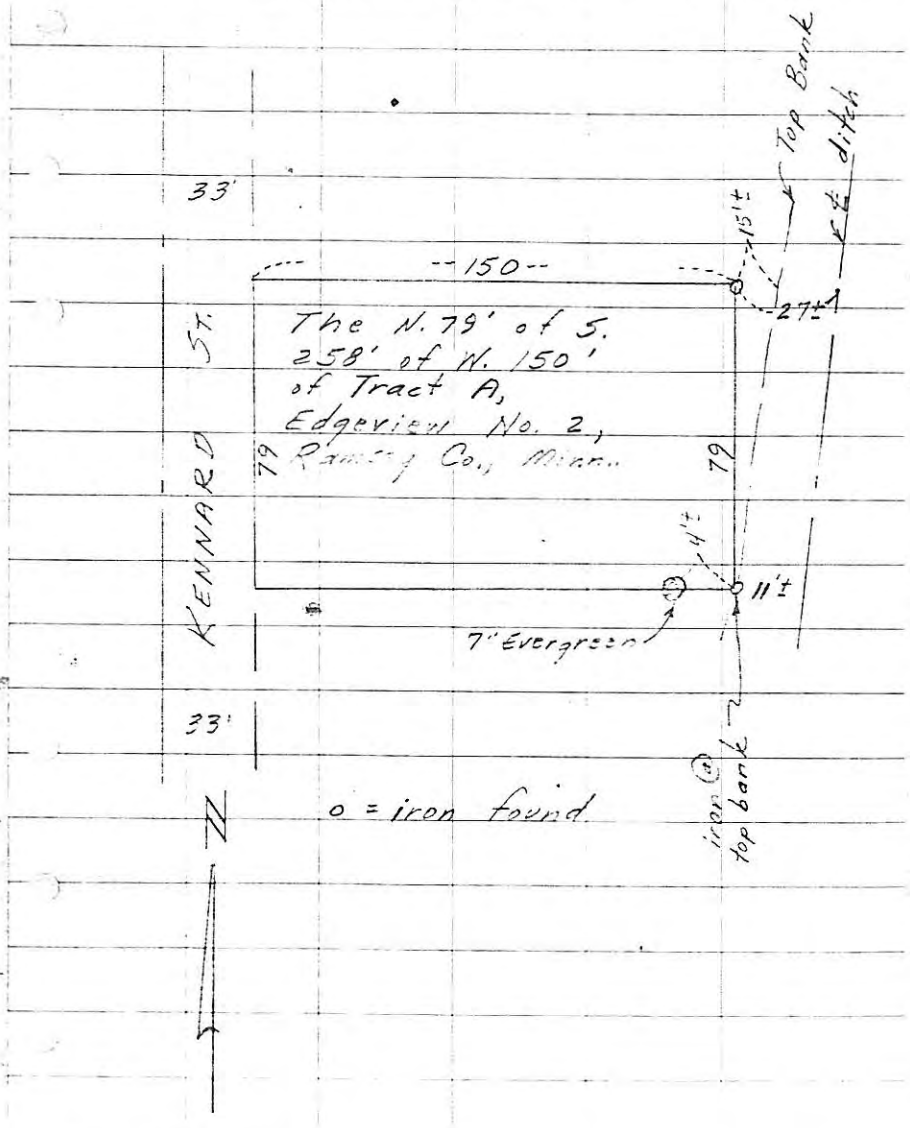

10899

R# 361