

1531 Wilson

*[Handwritten signature]*

# WARREN I. FORSBERG

Registered Land Surveyor


2060 E. 5th St.  
St. Paul 6, Minn.

## PLAT OF SURVEY

OF PROPERTY OF

as described follows, except the westerly 1.0 foot, measured at right angles, Lot 14 and the westerly 0.8 foot, measured at right angles, of Lot 15, Block 7, Wilson Street Addition No. 3, St. Paul, Minn.

# 11051  
RH 367

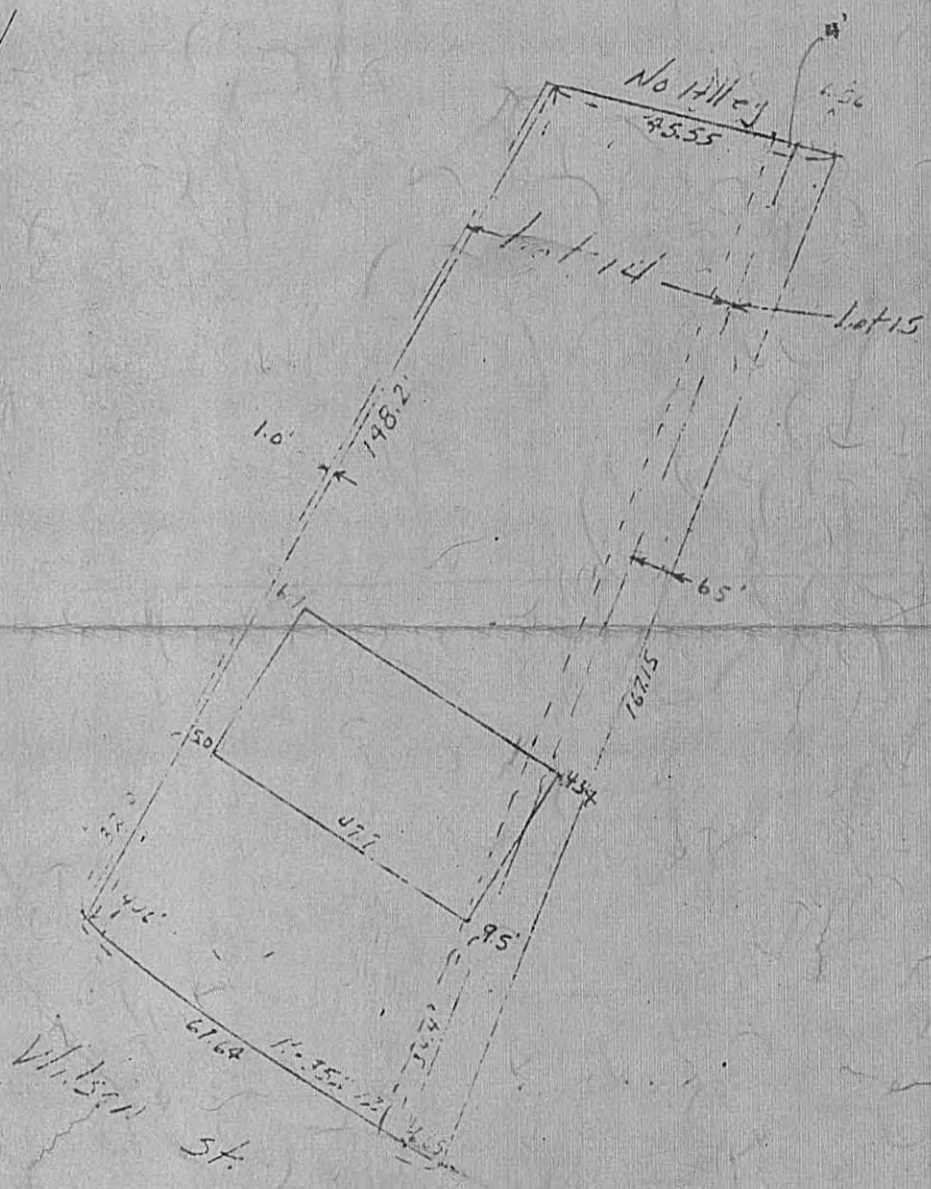

*Location*  
CERTIFICATE OF SURVEY

as described above and that the above plat is a correct representation of said survey.

O—Indicates Iron Monument.

*Warren I. Forsberg*

Plat 38