


FOR: RALPH STACKER  
M.J. Blomquist

# 11127  
R# 370

OR. 6872-A  
160-13  
Sec. 31-29-22.

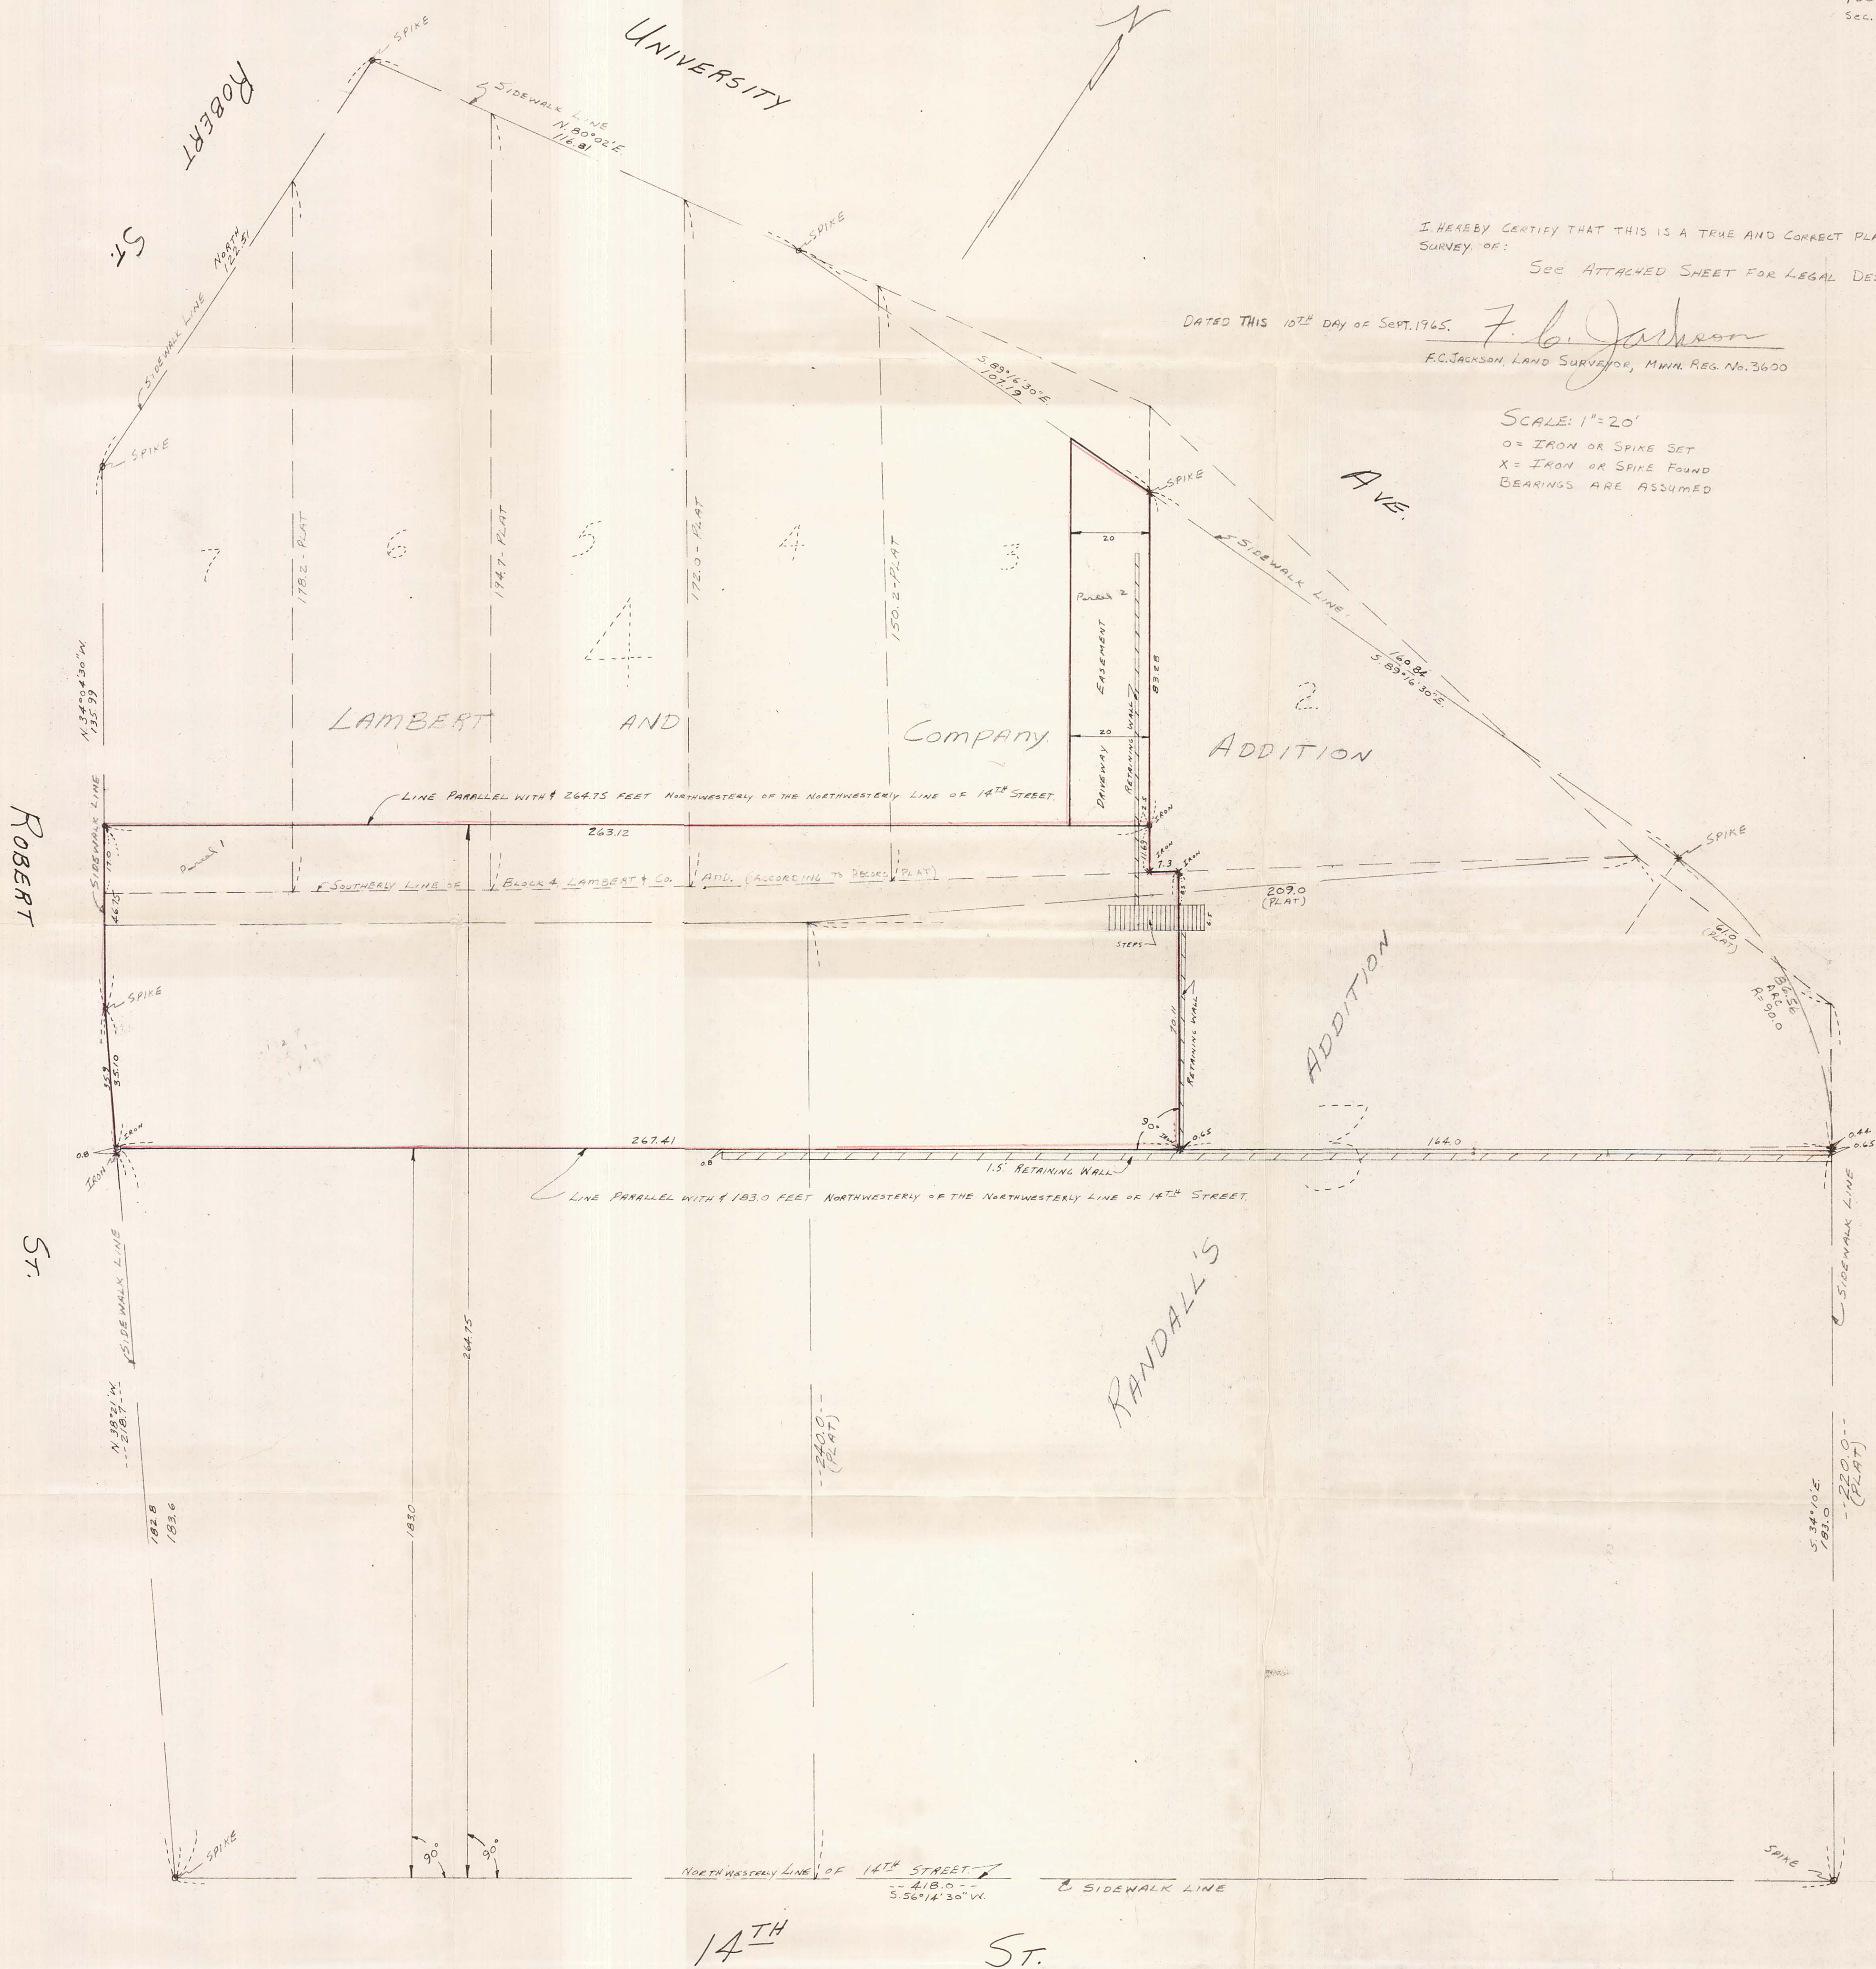

I HEREBY CERTIFY THAT THIS IS A TRUE AND CORRECT PLAT OF A SURVEY OF:  
SEE ATTACHED SHEET FOR LEGAL DESCRIPTION.

DATED THIS 10<sup>TH</sup> DAY OF SEPT. 1965. F. C. Jackson  
F.C. JACKSON, LAND SURVEYOR, M.W.M. REG. NO. 3600

SCALE: 1"=20'  
O = IRON OR SPIKE SET  
X = IRON OR SPIKE FOUND  
BEARINGS ARE ASSUMED