

INCORPORATED 1892

ABSTRACTS
 TORRENS REPORTS
 OWNERSHIP REPORTS
 TITLE INSURANCE FACILITIES

St. Paul Abstract AND TITLE Company

Guarantee

PHOTOCOPIES
 ESCROW SERVICE
 RECORDING SERVICE
 PROPERTY SEARCHES

24 EAST FOURTH STREET


ST. PAUL 1, MINN.

MEMBER
 THE MINNESOTA TITLE ASSOCIATION
 THE AMERICAN TITLE ASSOCIATION
 ST. PAUL BOARD OF REALTORS

12.) KELLOGG SCHOOL

#11159
 R#372

14

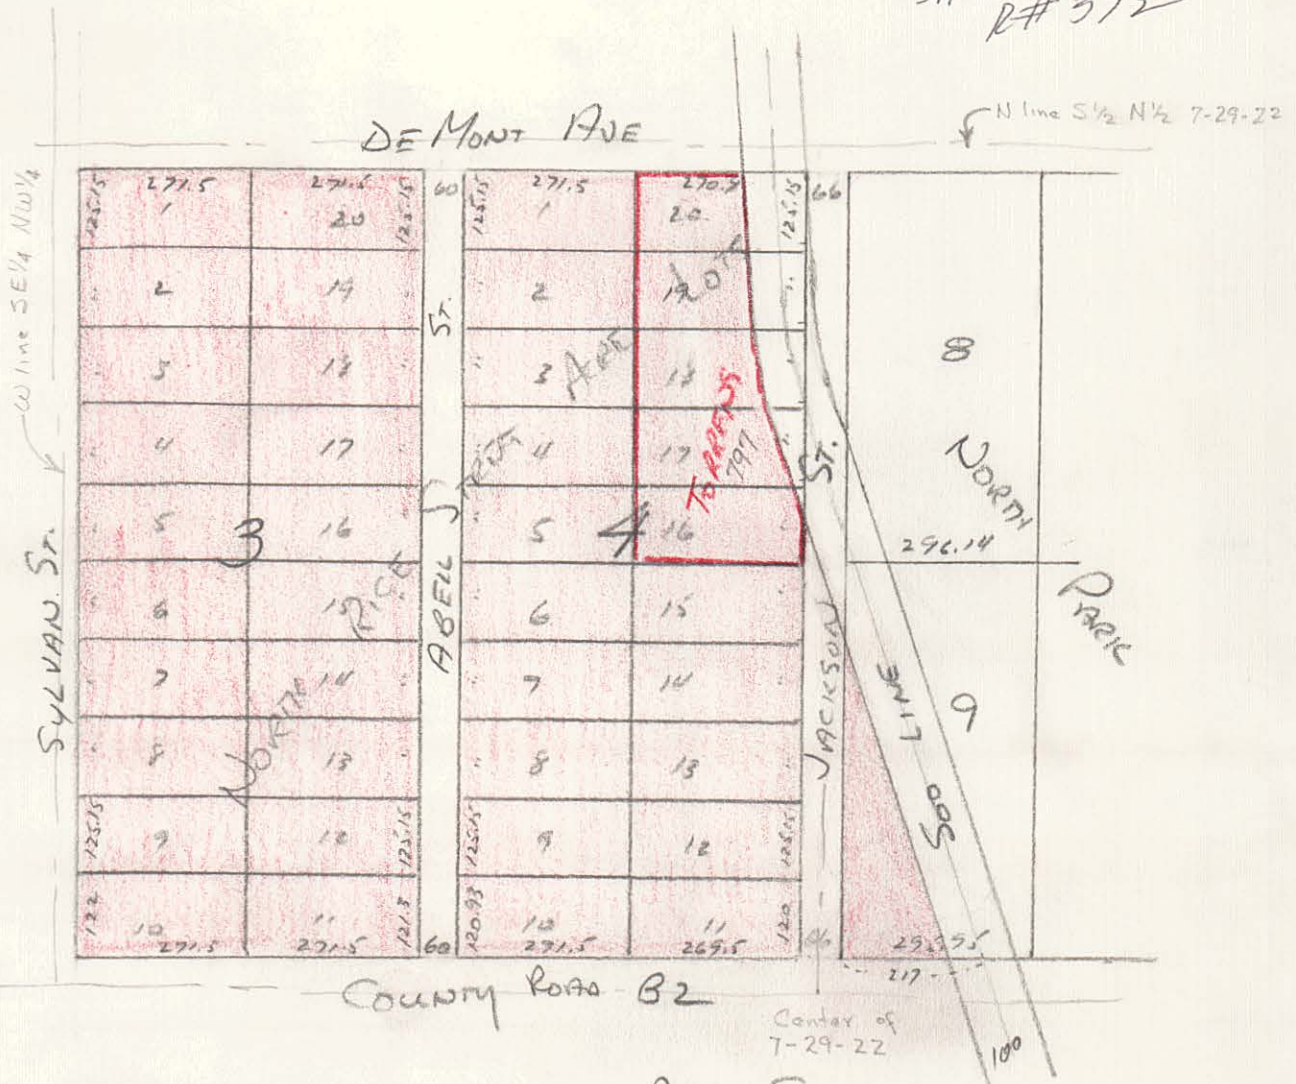

NOTE: IS THERE A VACATION OF ABELL ST AND JACKSON ST. ?

ABSTRACTS O.K.
 TORRENS O.D. O.K.

VA