


File 11174  
R# 373

S-13

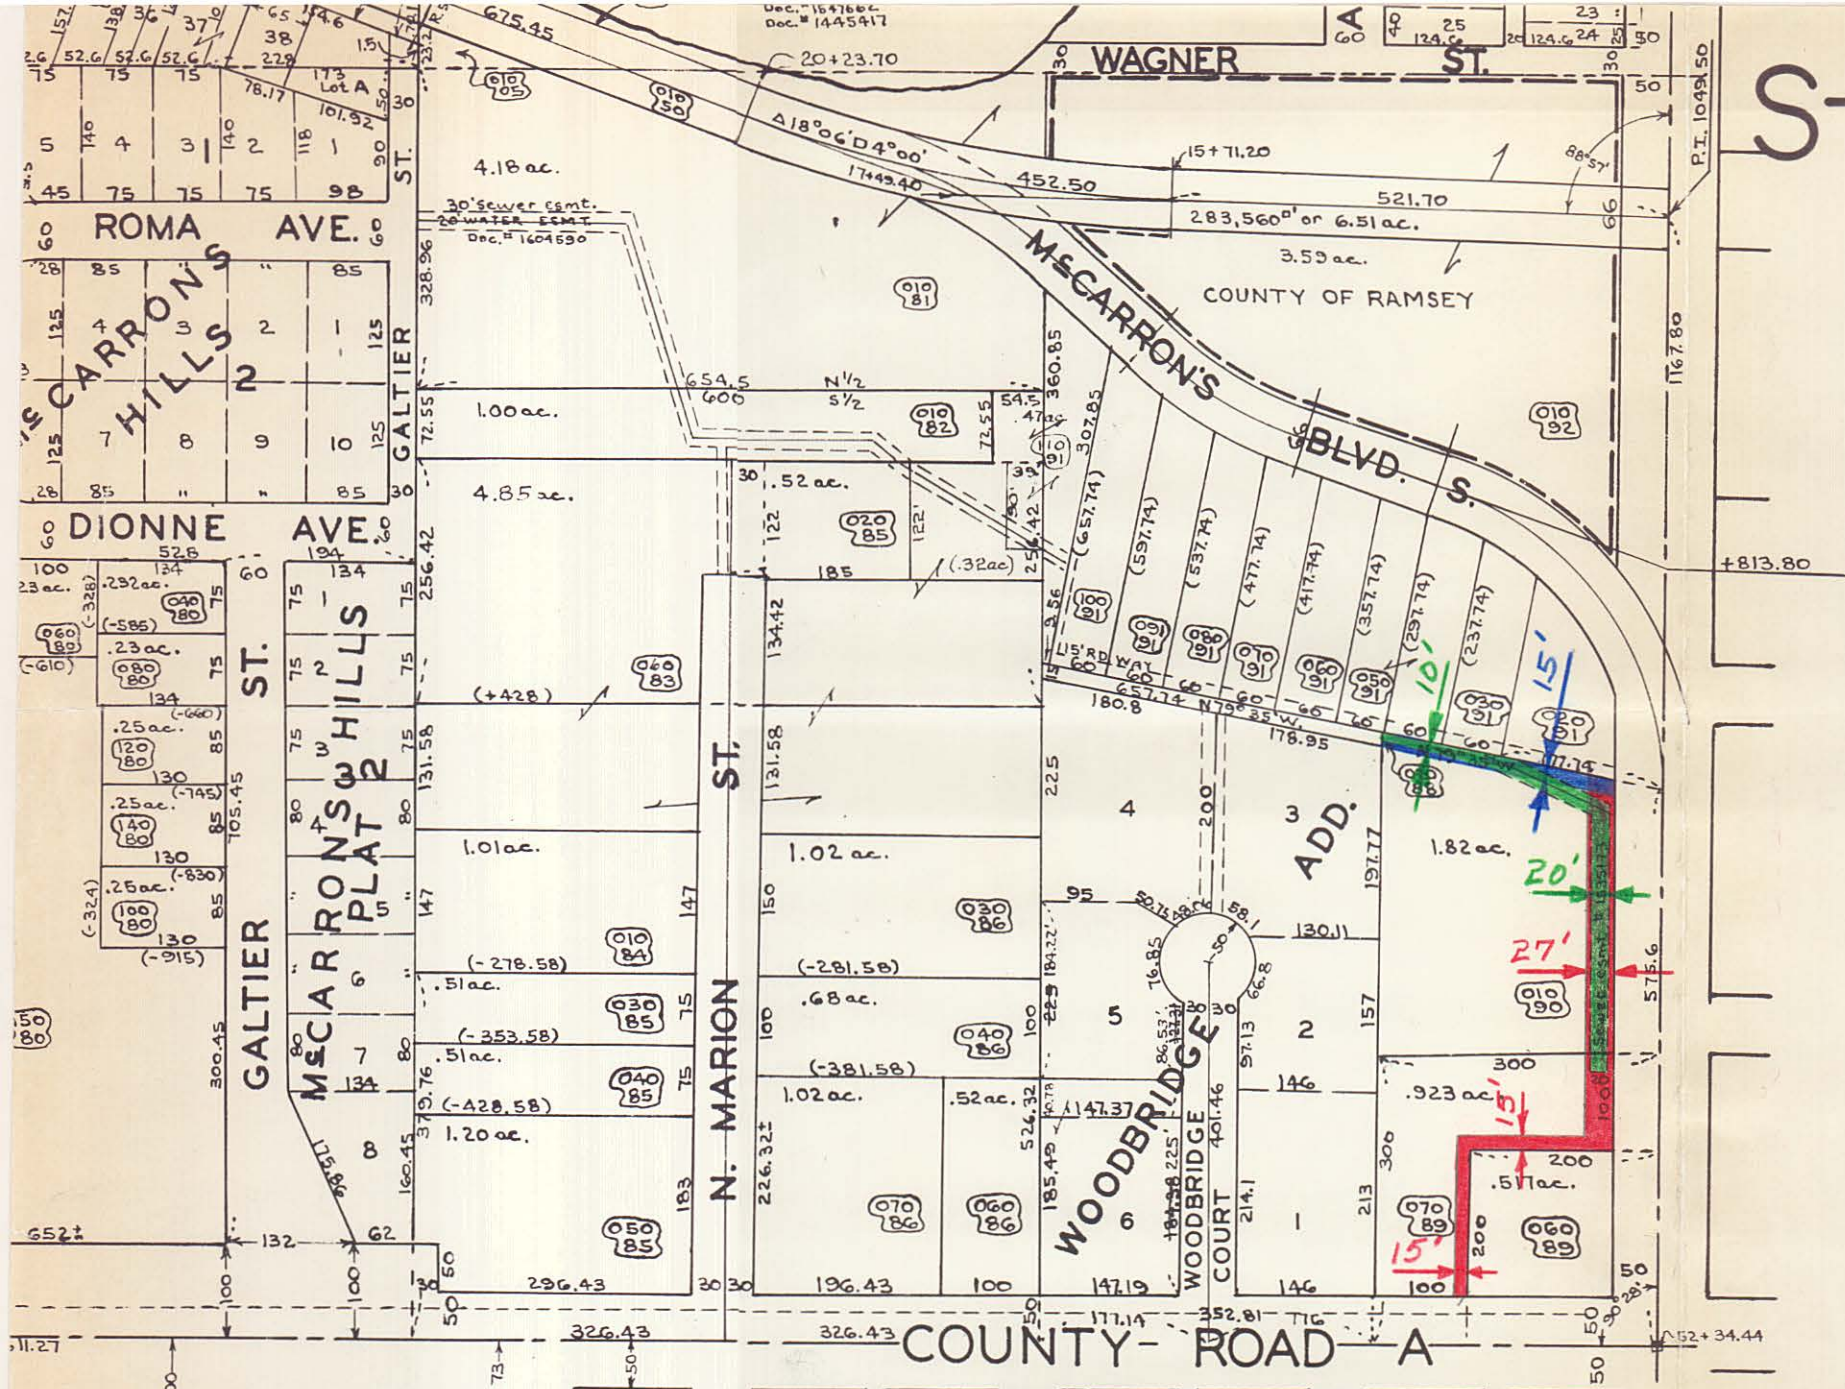

SANITARY SEWER MAIN easement in green  
WATER MAIN easement in blue  
New Utility easement in red

Prepared By:  
VILLAGE OF ROSEVILLE  
Engineering Department  
*W.A.S.*

Dated: March 21, 1966

OUTLOTS

RICE

ST.

VILLAS

Last Cor 11-16-64  
" " 10-27-65 RG

13-29-23

DEPARTMENT OF ASSESSOR  
RAMSEY COUNTY  
R.G.G. 8-21-64  
SCALE = 1" 200'

#11174  
R#-373

NEG. 8  
Jacob Schmidt Brewing Co.  
Pt. S.E. 1/4 Sec. 13-29-23  
0.03 Ac.

NEG. 10  
Fred H. Kaufhold  
Pt. S.E. 1/4 Sec. 13-29-23  
0.11 Ac.

NEG. 9  
Evan Bridges  
Pt. S.E. 1/4 Sec. 13-29-23  
0.06 Ac.

NEG. 11  
Anton Soller et al  
Pt. S.E. 1/4 S.E. 1/4 Sec. 13-29-23  
0.05 Ac.


NEG. 12 (By Option)  
County of Ramsey  
Pt. E. 1/2 S.E. 1/4 S.E. 1/4 Sec. 13-29-23  
Lots 1 to 24 Incl. Blk. 4 Wagners 2<sup>nd</sup> Add.  
To St. Paul  
R/W 0.45 Ac.  
S.E. 0.02 "(Exp. 12-1-51)

BEG. & WIDTH ORDER NO. 17340  
SLOPE EASE ORDER NO. 17341  
POR. 6214 (49 = 126) 901

Stone Mon. Inp.  
Flush with Pavt.



# McCarron's Lake

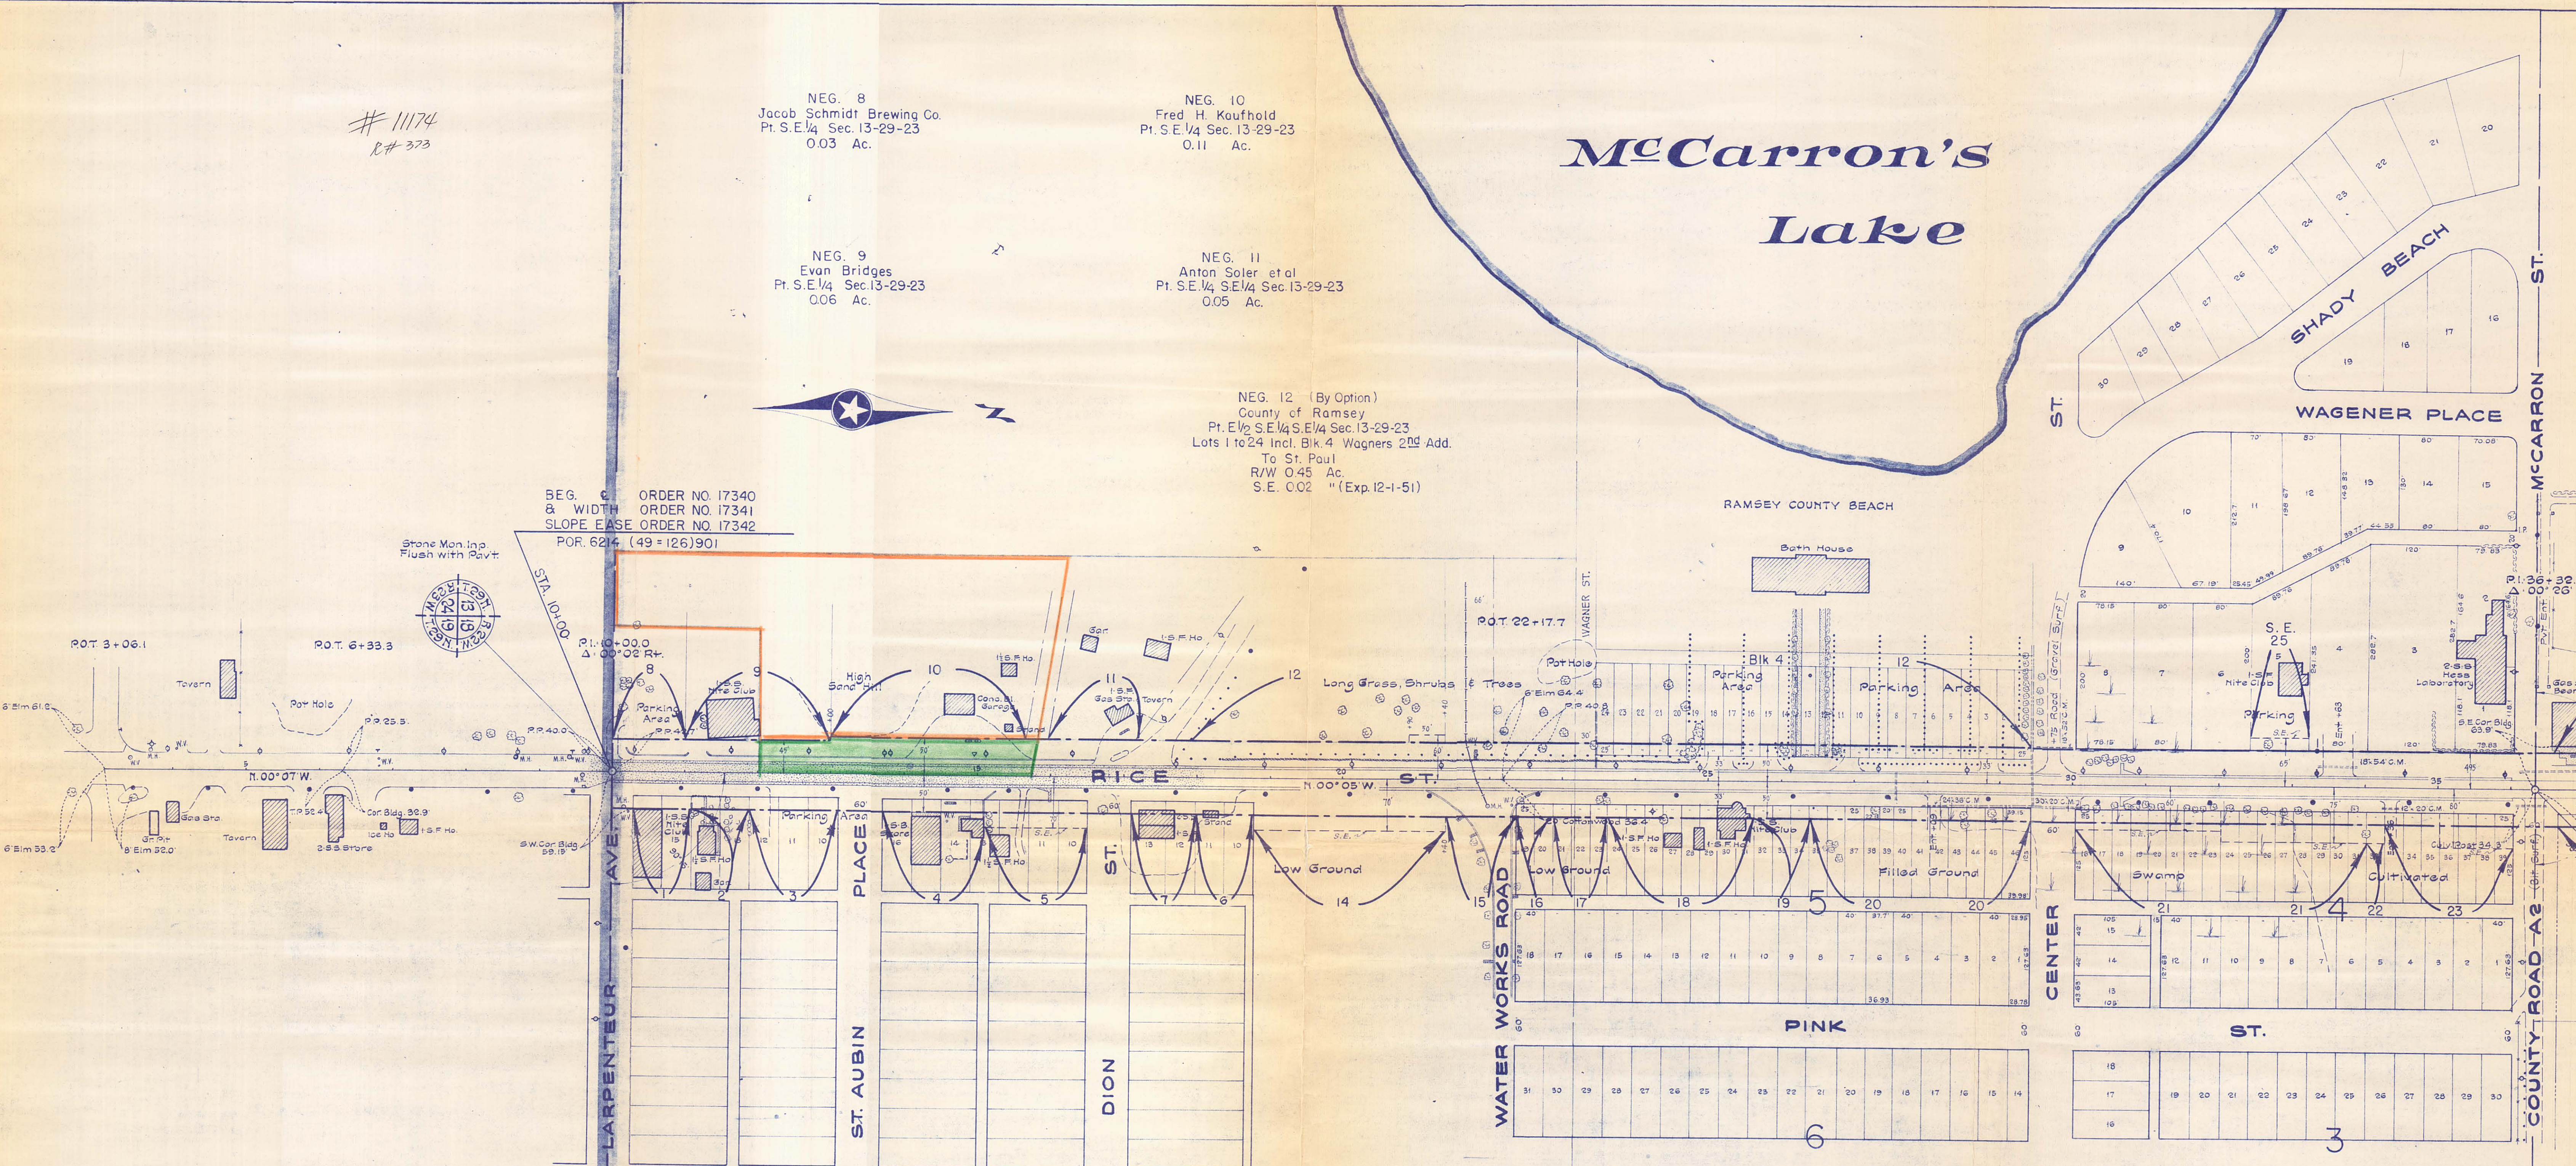

ST. AUBIN & DIONS RICE ST. ADDITION TO CITY OF ST. PAUL

NEG.	OWNER	BLOCK	LOTS
1	Harry Quatman et al	8	15 & 16
2	Roy O. Palmer et al	8	13 & 14
3	Theodore L. Laber et al	8	10, 11 & 12
4	Theodore L. Laber et al	7	16, 15, 14 & 13
5	Kathryn Silver	7	10, 11, 12 & 13
7	Frank Mazzara et al	6	12 & 13
6	Fred Dietze	6	10 & 11

NEG. 14 (By Option)  
Board of Water Commissioners  
City of St. Paul  
Pt. S.W. 1/4 Sec. 18-29-22  
R/W 0.10 Ac.  
S.E. 0.12 "(Exp. 12-1-51)  
For agreement see Neg. 14 file

NEG. 15  
City of St. Paul  
Pt. S.W. 1/4 Sec. 18-29-22  
0.04 Ac.

EISENMENGER & ZASPELS LAKE PARK

NEG.	OWNER	BLOCK	LOTS
16	Board of Water Commissioners (City of St. Paul)	5	19 & 20
17	City of St. Paul (A Municipal Corporation)	5	21, 22 & 23
18	Samuel Allen	5	24 to 31 Incl.
19	Harriet B. Allen	5	32, 33 & 34
20	City of St. Paul	5	35 to 46 Incl.
21	Anthony J. Thommes	4	16 to 31 Incl.
22	Frank J. Unger	4	32
23	Astor George Zaspel	4	33 to 39 Incl.

PARCEL 9 - EVAN BRIDGES  
PARCEL 10 - FRED H. KAUFOLD

SP 6214 (49 = 126)  
RAMSEY COUNTY