11199
R# 374

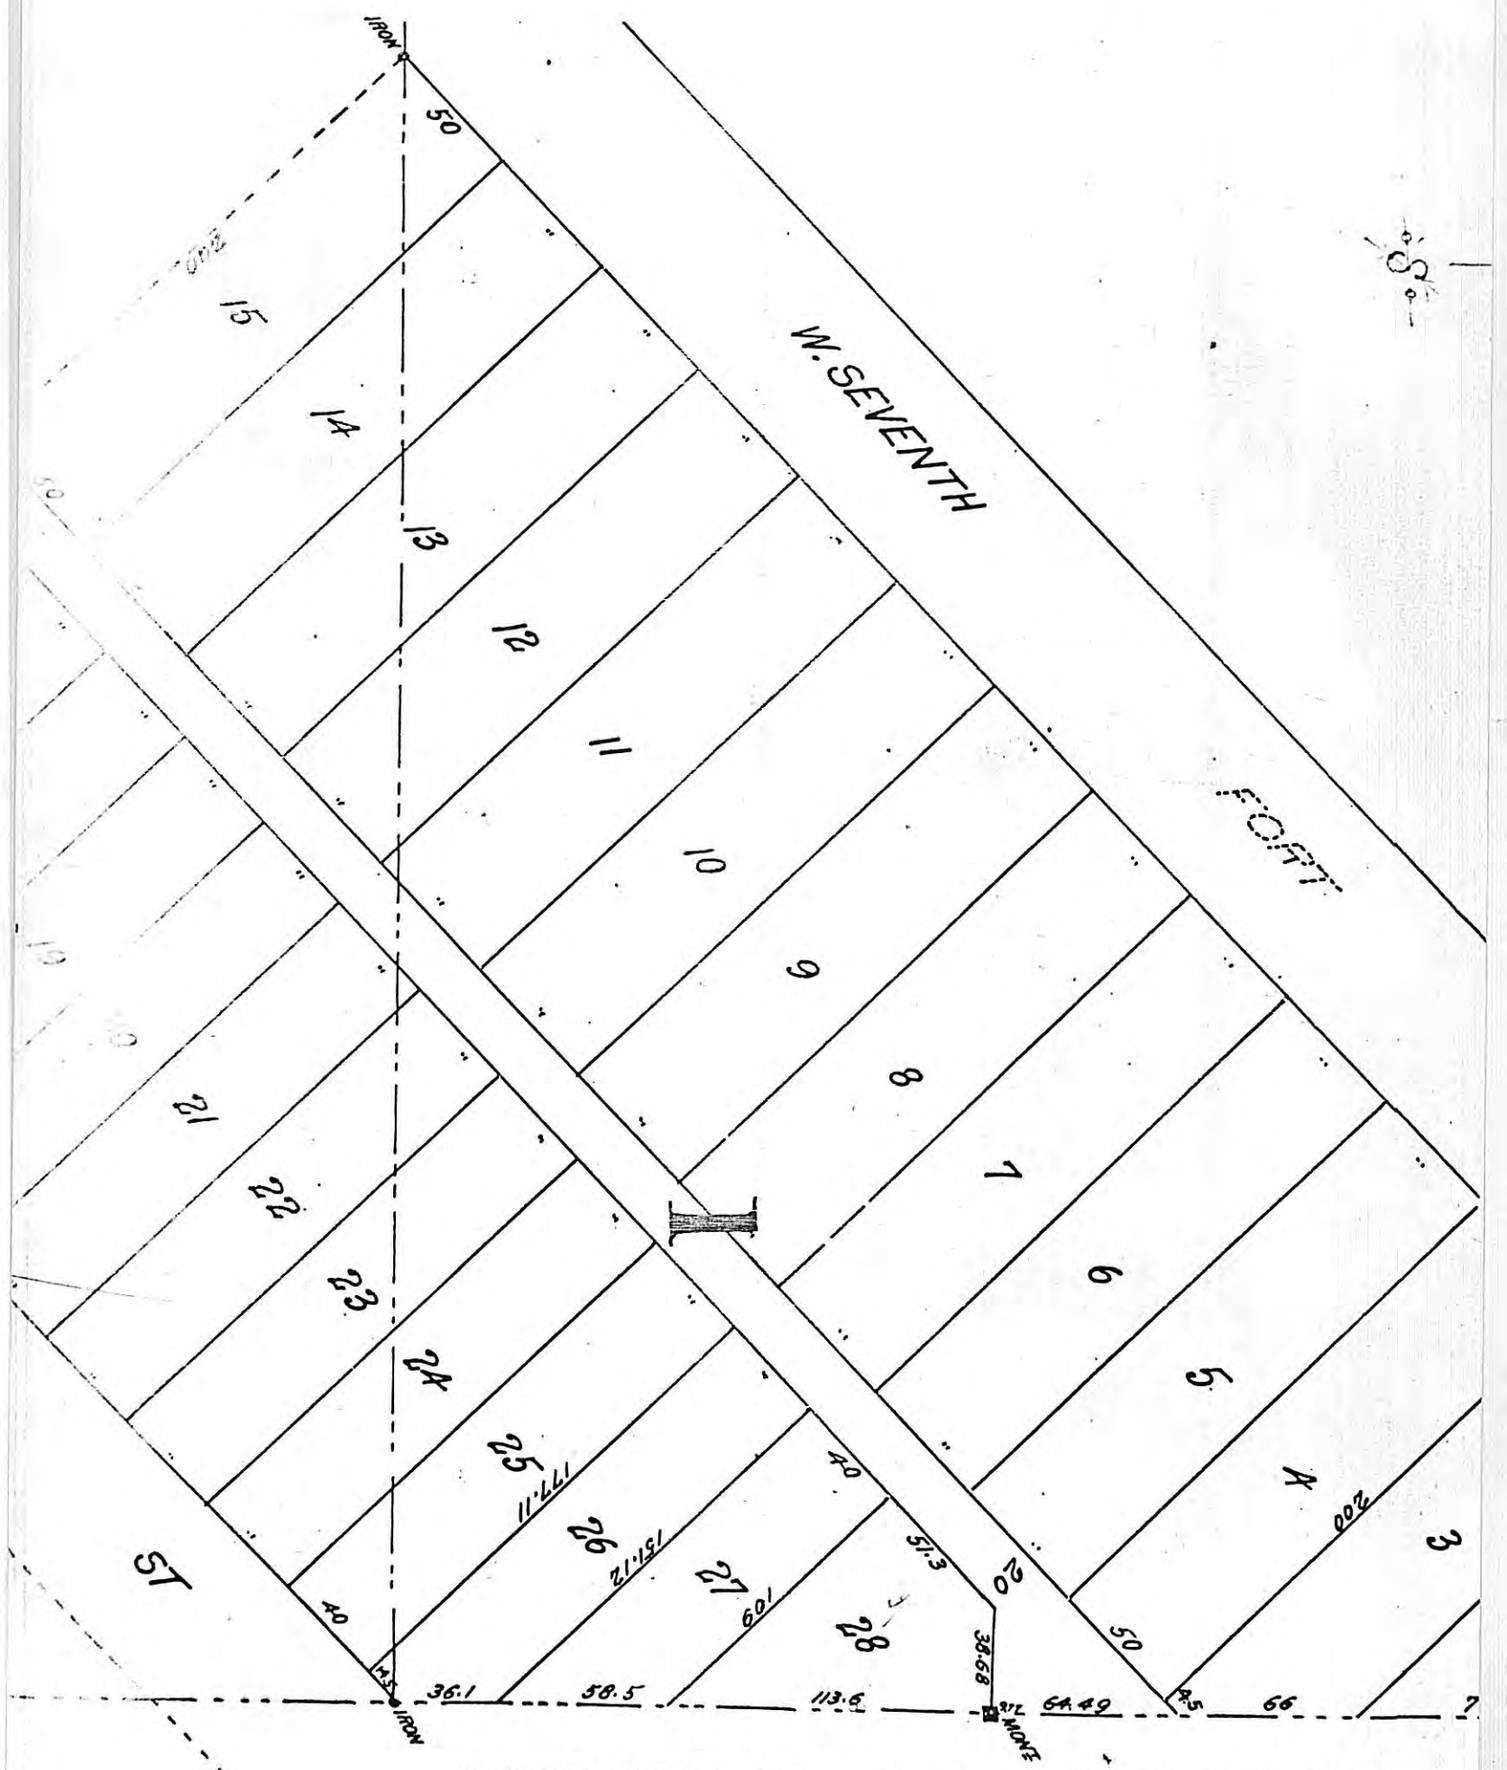

DESCRIPTION: COMMENCING AT THE S.E. CORNER OF T
OF SEC. 14 T. 28 R. 23, THENCE N. ALONG TI
550.51' TO THE S.E. LINE OF FORT ST. TA
NAMED LINE 796.5' THENCE SOUTHEASTE
TO LAST NAMED LINE 400' THENCE NORT.
WITH THE S.E. LINE OF FORT ST. TO