

Stringer, Donnelly & Sharood

# 11236

Roll 377

THE E. B. McDONOUGH CO.

1953 UNIVERSITY AVENUE, ST. PAUL 55104  
742 BUILDERS EXCHANGE BLDG., MINNEAPOLIS 55402


TELEPHONES { 646-6858  
333-6476

SCALE: 1 INCH 50 FEET

# PLAT OF SURVEY

OF PROPERTY OF St. Paul Goodwill Industries

DESCRIBED AS FOLLOWS Lots 3, 4, 5 and 7, Aud. Sub. No. 24, St. Paul, Minn.

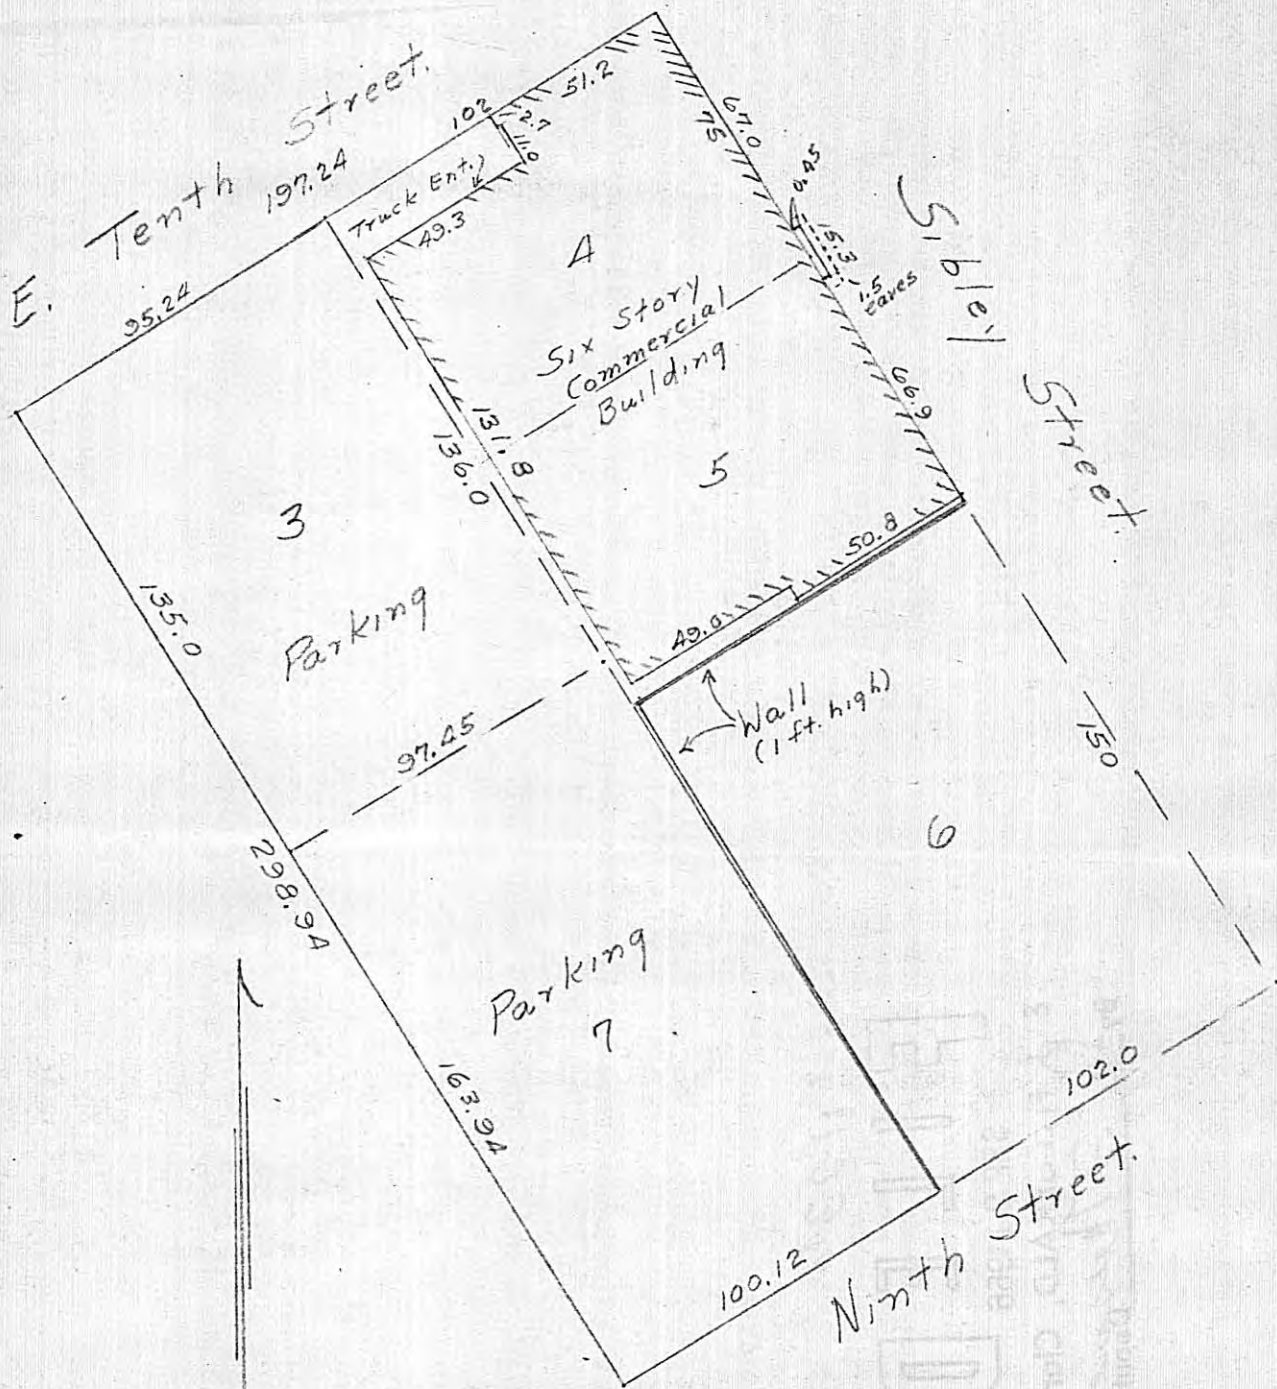

### CERTIFICATE OF LOCATION OF BUILDING

I hereby certify that on 8-4 1966  
I made a survey of the location of the building(s) on the  
above described property and that the location of said  
building(s) is correctly shown on the above plat.

*E. B. McDonough*

### CERTIFICATE OF SURVEY

I hereby certify that on \_\_\_\_\_ 19\_\_\_\_  
I surveyed the property described above and that the above  
plat is a correct representation of said survey.

E. B. McDONOUGH, REGISTERED SURVEYOR, No. 1990  
PAUL J. CRANE, " " No. 4449  
JOHN J. RYAN, " " No. 4489