

VI. 4-4492

# WARREN I. FORSBERG

2060 E. 5th St.  
St. Paul 6, Minn.


Registered Land Surveyor

# 11284  
R# 379

## PLAT OF SURVEY

OF PROPERTY OF B.J. Perry

described as follows: Lots 8, 9, and 10, Block 23 of Bazille & Robert's Add. to West St. Paul, and Lot 16 of Auditors Sub. #39. The above described now located in the City of St. Paul, Ramsey County.

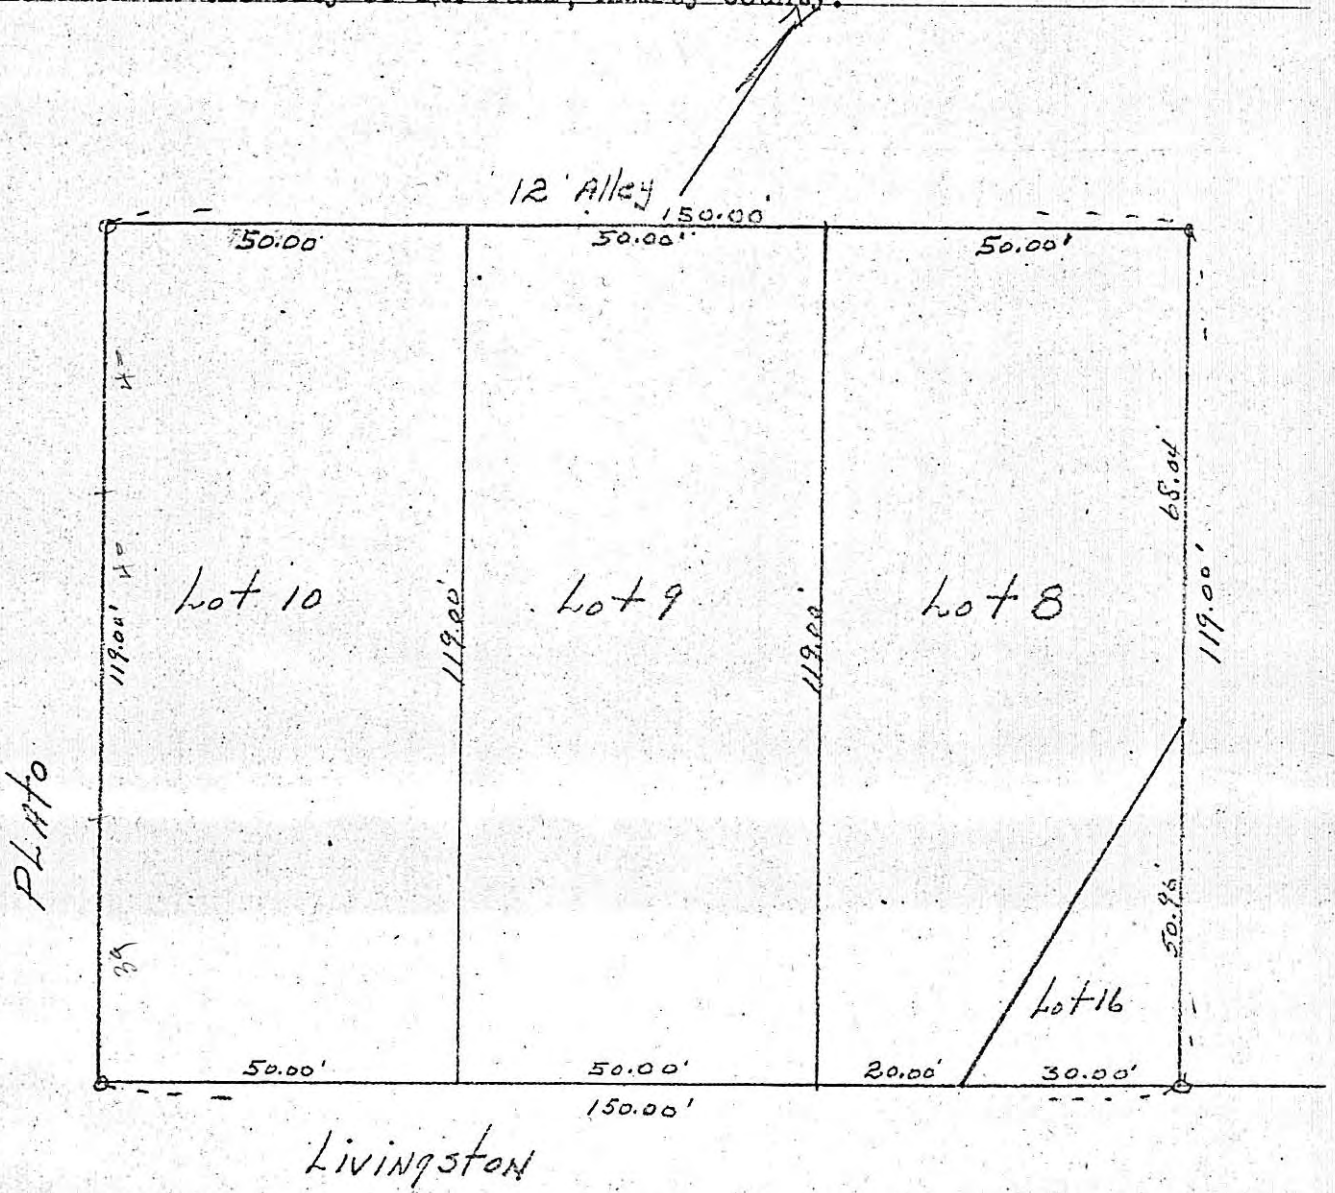

### CERTIFICATE OF SURVEY

I hereby certify that on Nov 11, 1954 I surveyed the property described above and that the above plat is a correct representation of said survey.

Scale: 1 inch 25 feet.

O—Indicates Iron Monument.

*Warren I. Forsberg*