


file # 11318

KETTERING AND CONSTANS' ADD. WEST ST. PAUL

SCALE: 200 FT TO THE INCH.

Von Minden & Wipperfurth Surveyors 185

6/25/22

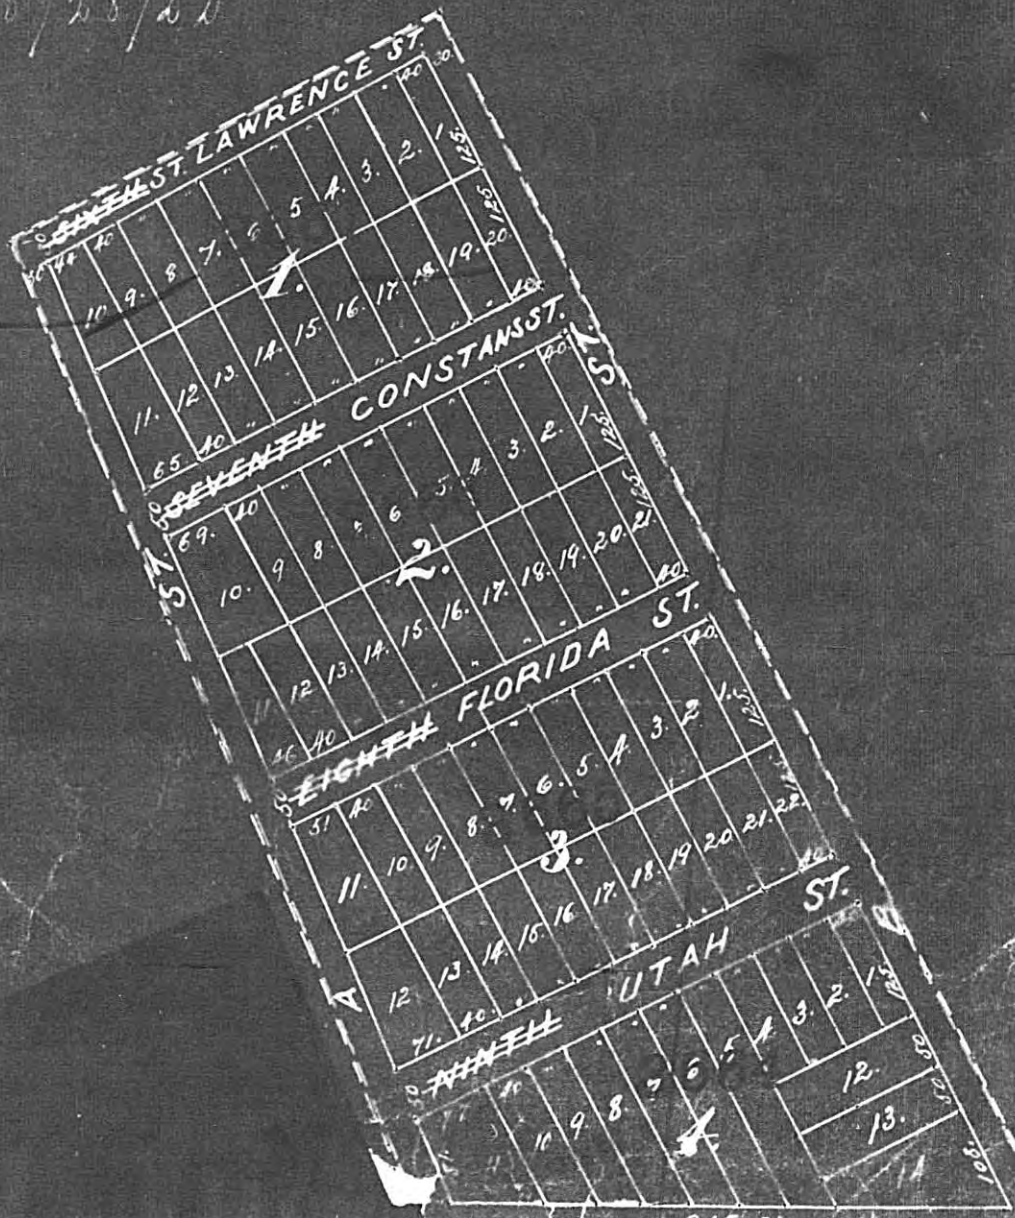

615 01