


#11326

PROCEEDING NO. 45

BL 2 POTTS ADDITION

BL 4 MORRISONS

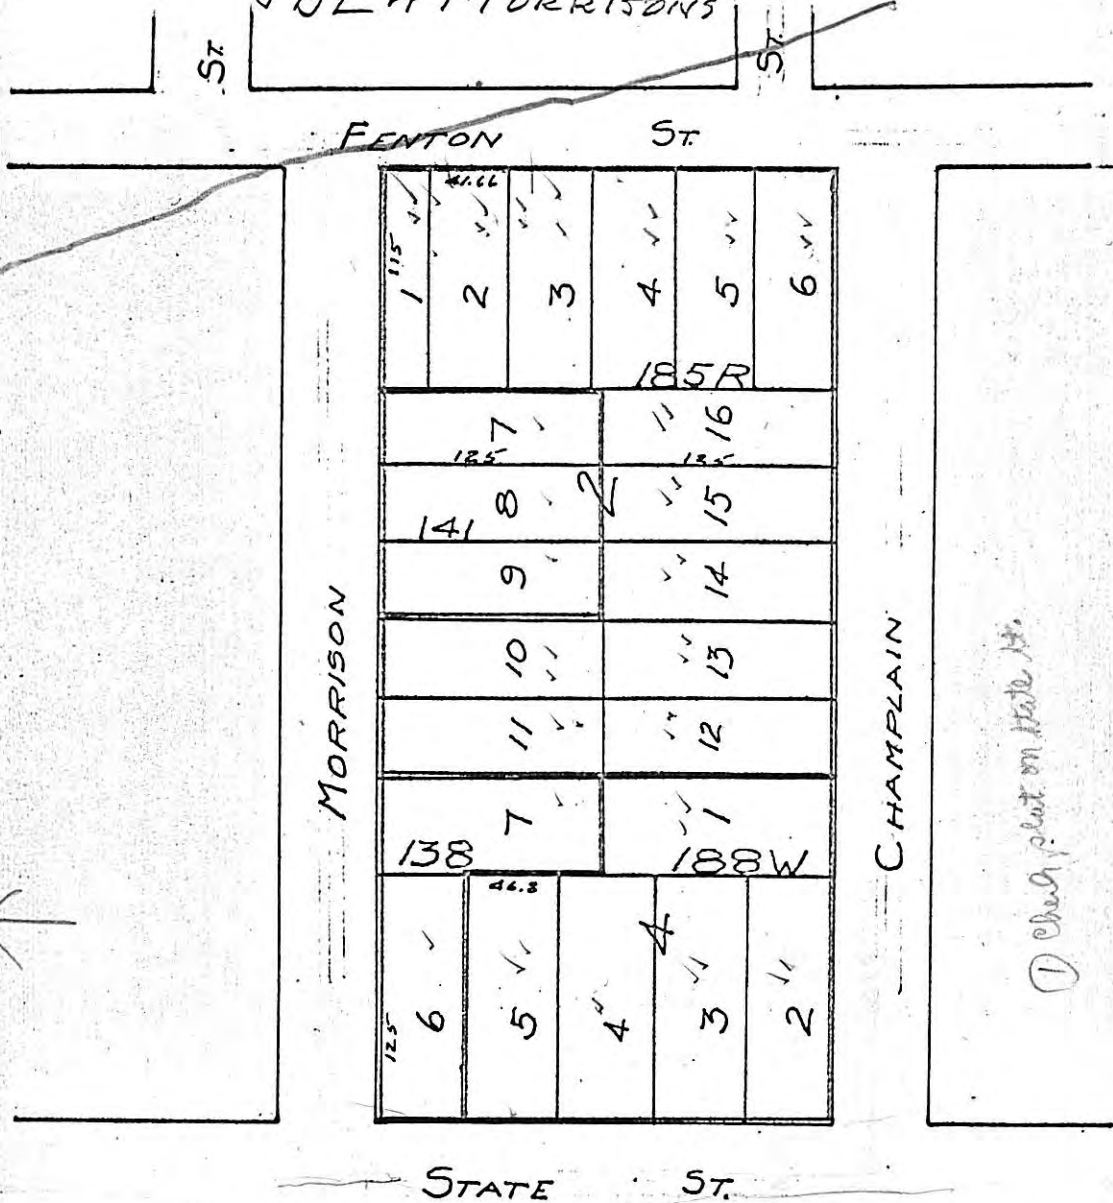

LEGEND

- PARCEL BOUNDARY
- 141 PARCEL NUMBER

PORT AUTHORITY OF THE

CITY OF ST. PAUL

RIVERVIEW INDUSTRIAL PARK

SCALE 1" = 100'

*Creation of parcel number*