


PROCEEDING NO. 54

HITCHCOCK'S ADDITION

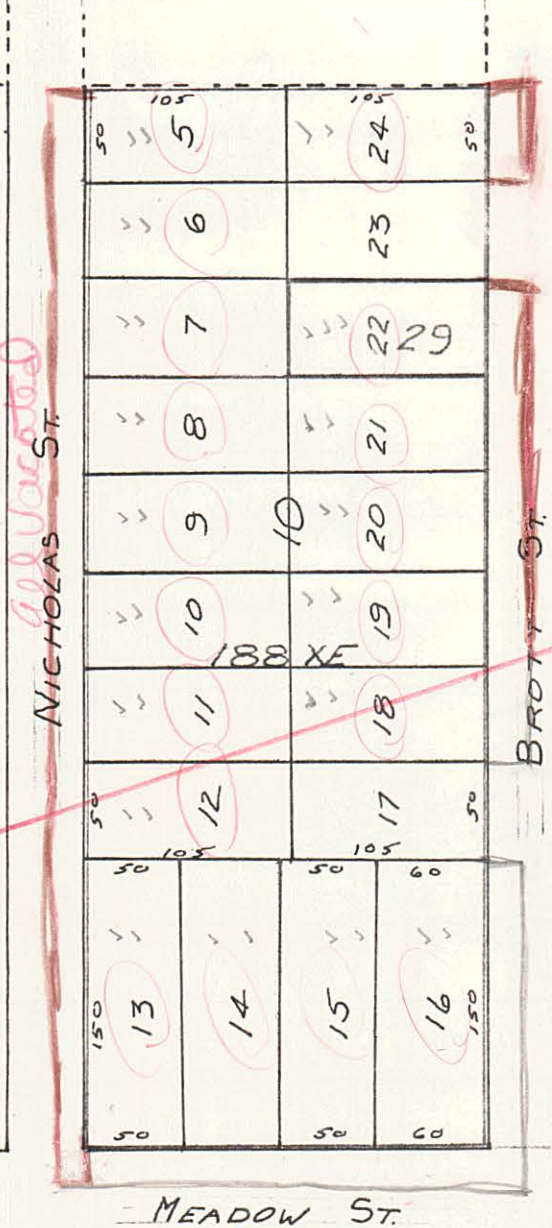

LEGEND

- PARCEL BOUNDARY
- 29 PARCEL NUMBER

PORT AUTHORITY  
OF THE  
CITY OF ST. PAUL  
RIVERVIEW INDUSTRIAL PARK  
SCALE 1" = 100'