



# PLAT OF SURVEY

JOHN J. RYAN COMPANY


**FILED**  
JAN 30 1968

F. J. WHEATON, Clerk  
By *[Signature]* Deputy

PROPERTY OF: ST. PAUL GOODWILL INDUSTRIES

DESCRIPTION: LOTS 1, 2, 3, 4, 5, 7, AND THE NORTHLY 35.0 FT. OF LOT 6  
AUDITORS SUBDIVISION NO. 24, RAMSEY COUNTY

★ B.M. HYDRANT  
ASSUMED ELEV. 100. FEET

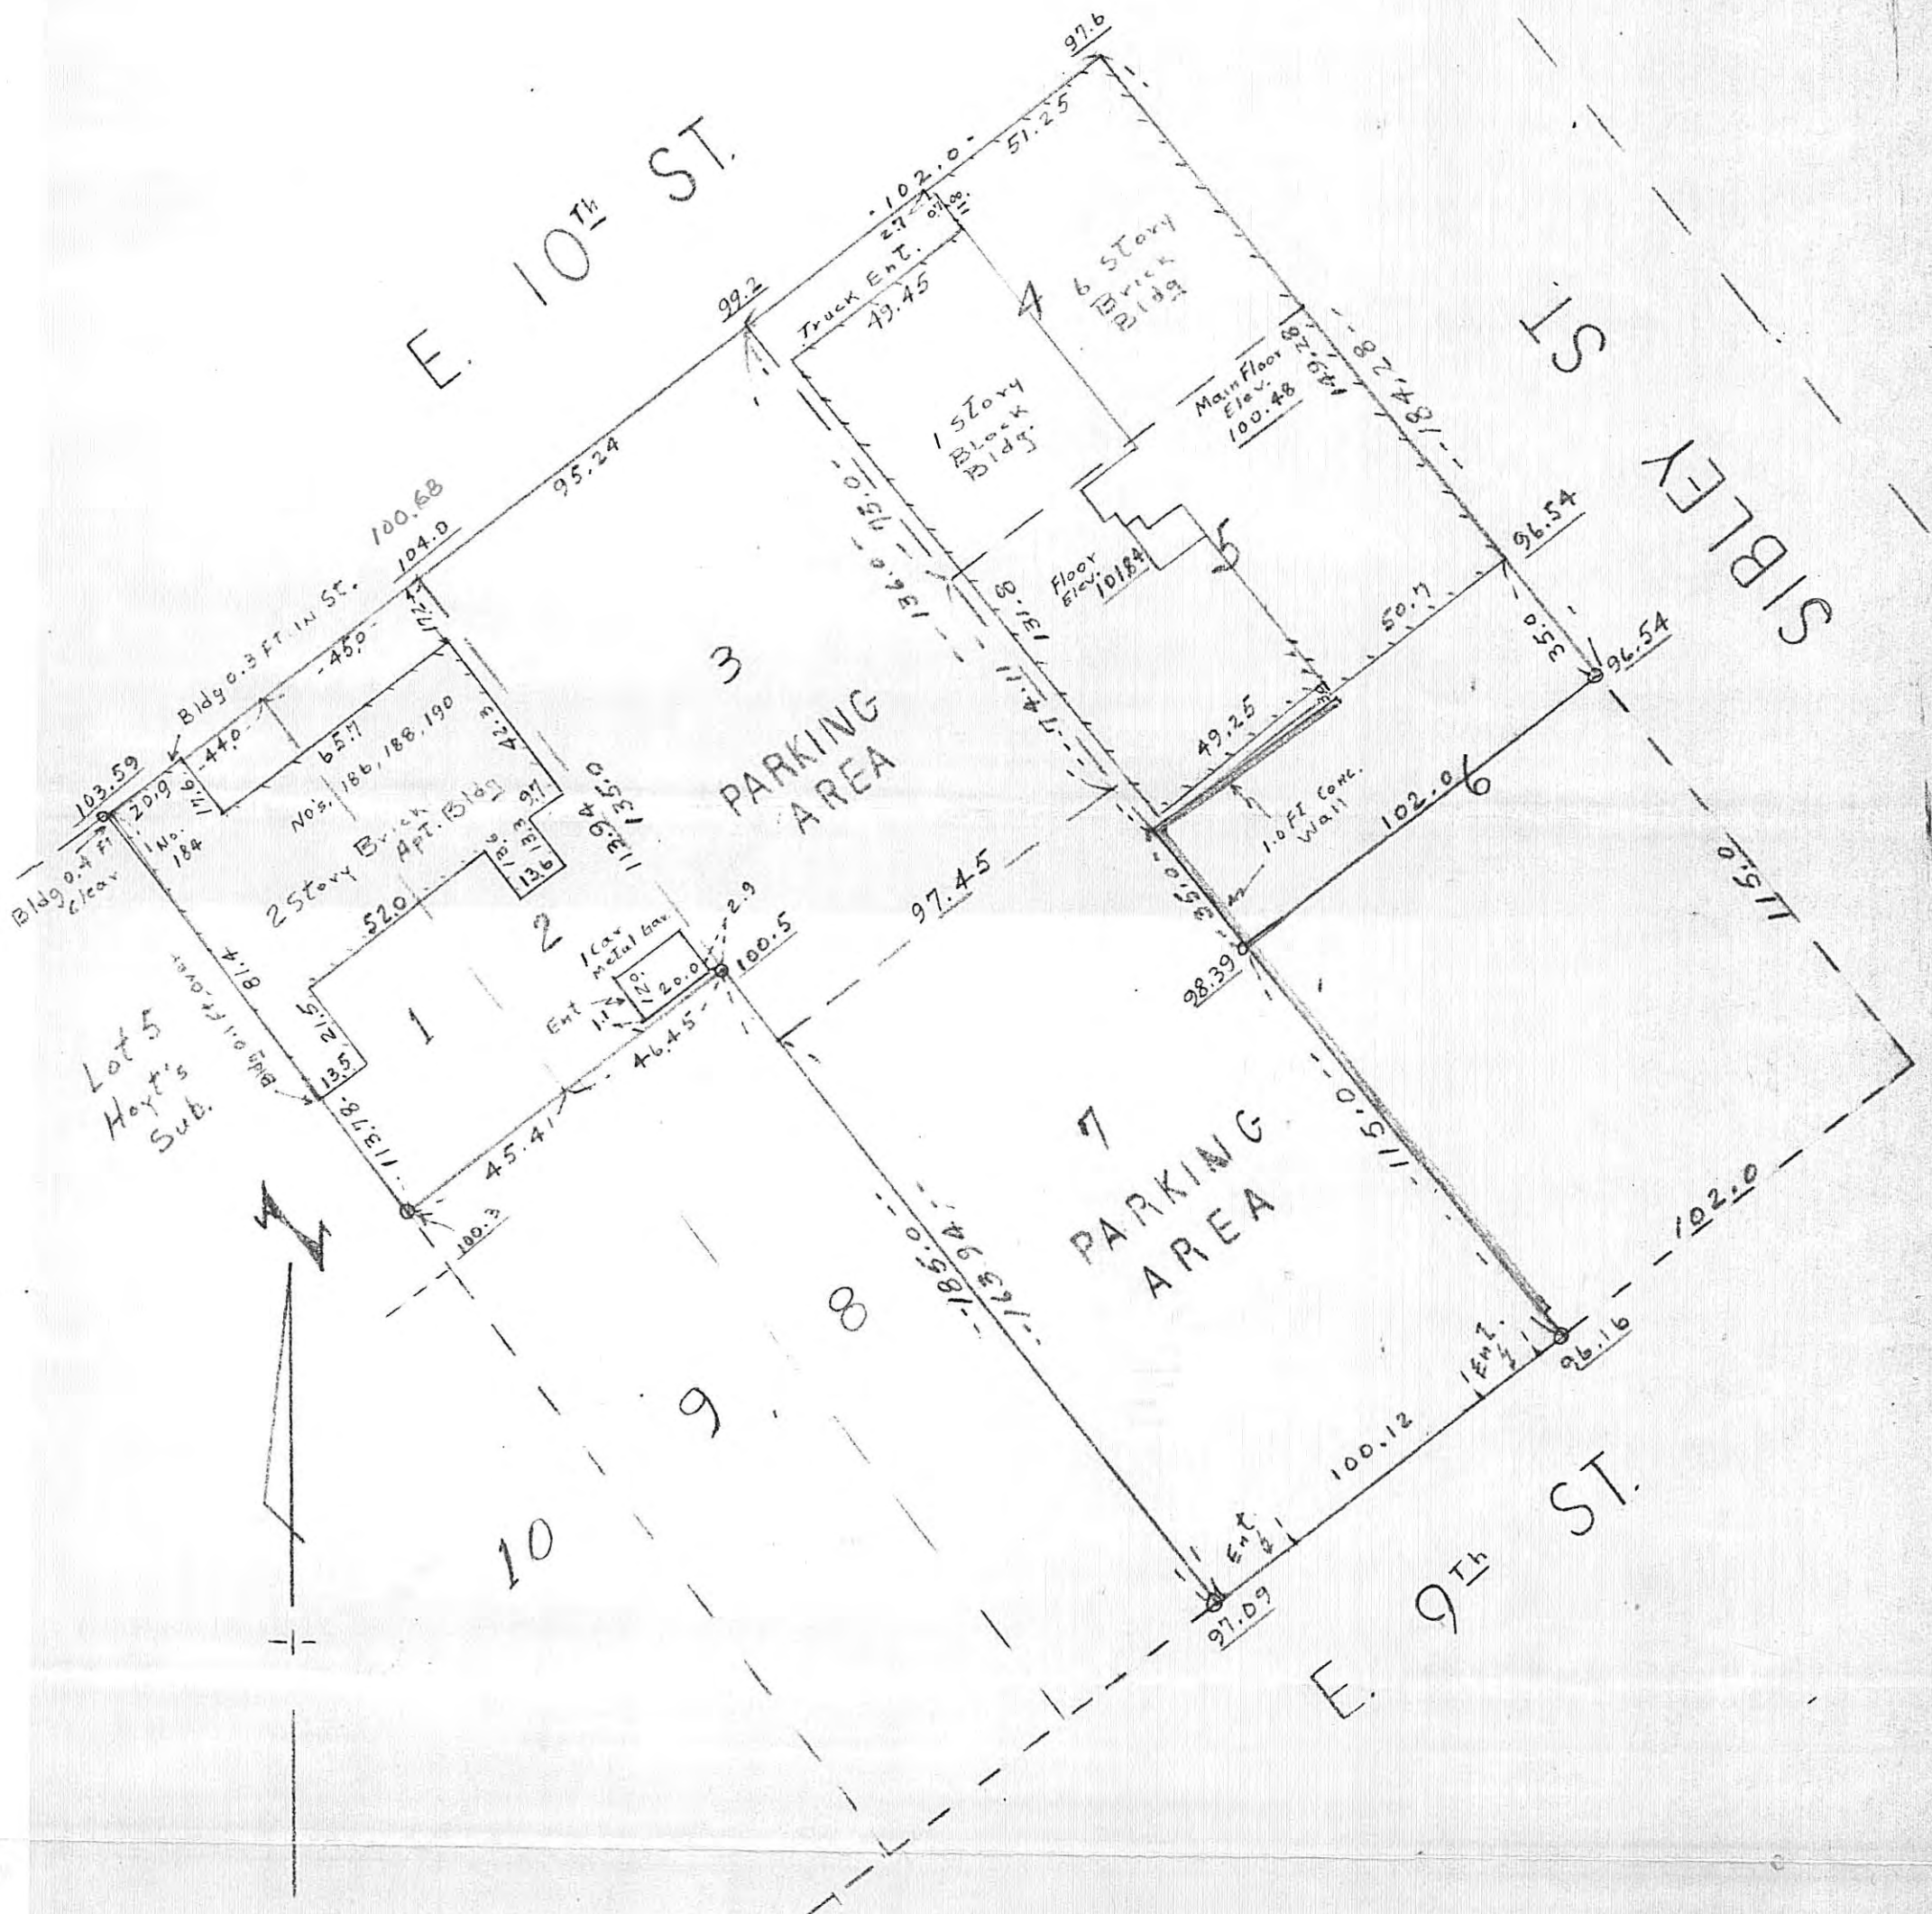

SCALE: 1 INCH = 40 FEET

◦ INDICATES IRON STAKE

CERTIFICATE OF SURVEY: I HEREBY CERTIFY THAT ON OCTOBER 31, 1966, I SURVEYED THE PROPERTY DESCRIBED ABOVE AND THAT THE ABOVE PLAT IS A CORRECT REPRESENTATION OF SAID SURVEY.

*John J. Ryan*  
JOHN J. RYAN

REGISTERED SURVEYOR NO. 4489