


#11425

INDIANA AVE.

FOWBL  
CIVIL ENGINEER  
ST. PAUL  
PLAT P.

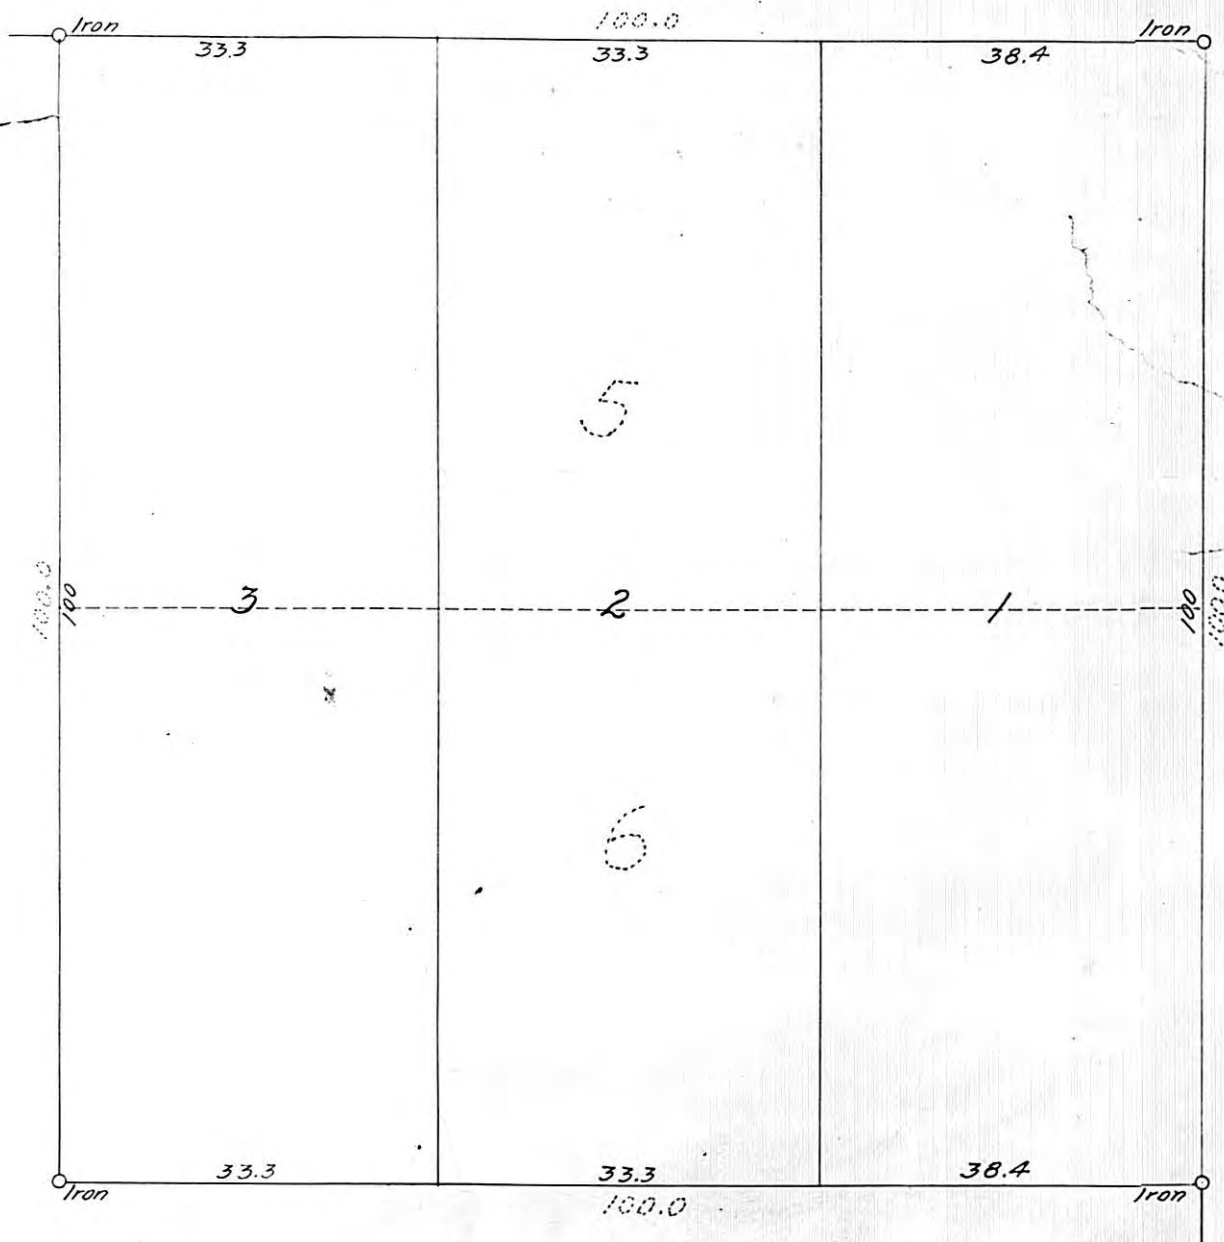

Lots 5 & 6, Block 15 Marshall's Addition to West St. Paul.

