


#11480

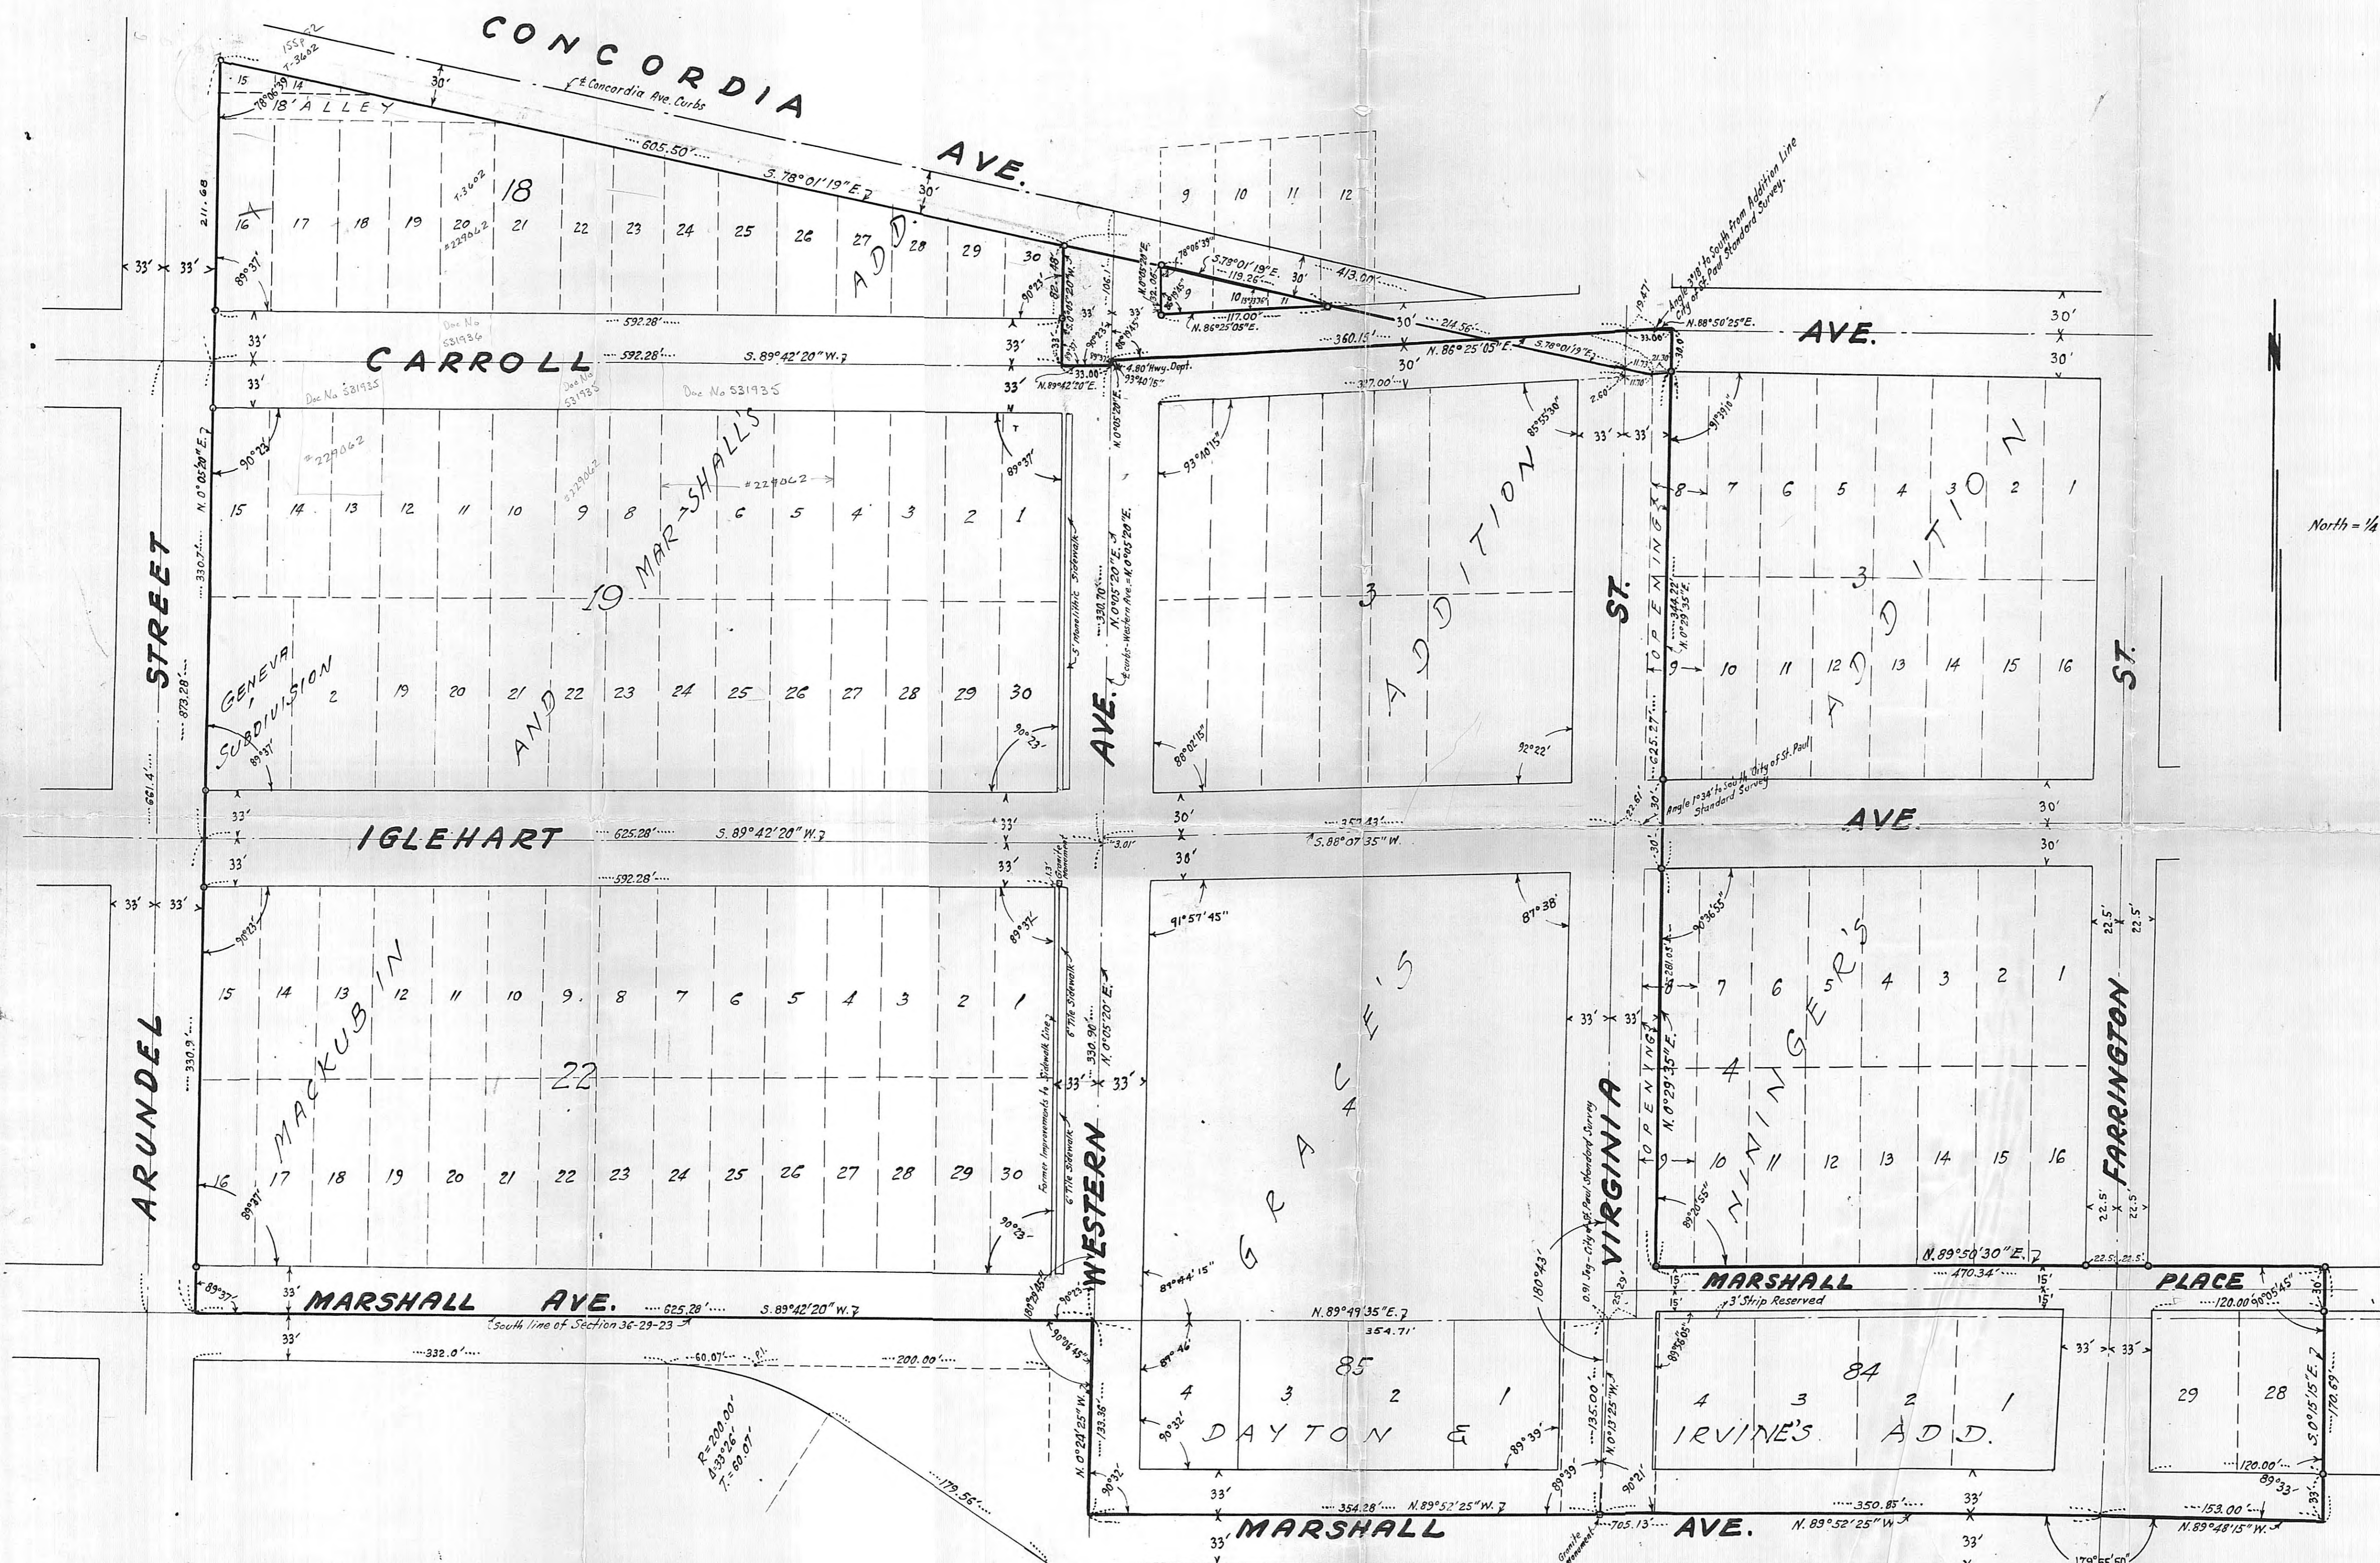

North = 1/4 Line on Western Avenue

~ LEGEND ~
 ○ Denotes Iron.
 □ Denotes Monument.

I hereby certify that in July and August 1965 I made a survey of the property shown on this map and that this map is a correct delineation of said survey.

Thomas J. Welch
 T. J. WELCH
 Registered Surveyor
 Minnesota Certificate No. 555.

PROPERTY LINE MAP
 CATHEDRAL AREA URBAN RENEWAL PROJECT
 HOUSING AND REDEVELOPMENT AUTHORITY
 OF THE CITY OF SAINT PAUL, MINNESOTA.
 THOMAS J. WELCH
 SCALE: 1" = 60'
 November 1965

Thomas J. Welch
 THOMAS J. WELCH, Registered Surveyor
 Minnesota Certificate No. 555