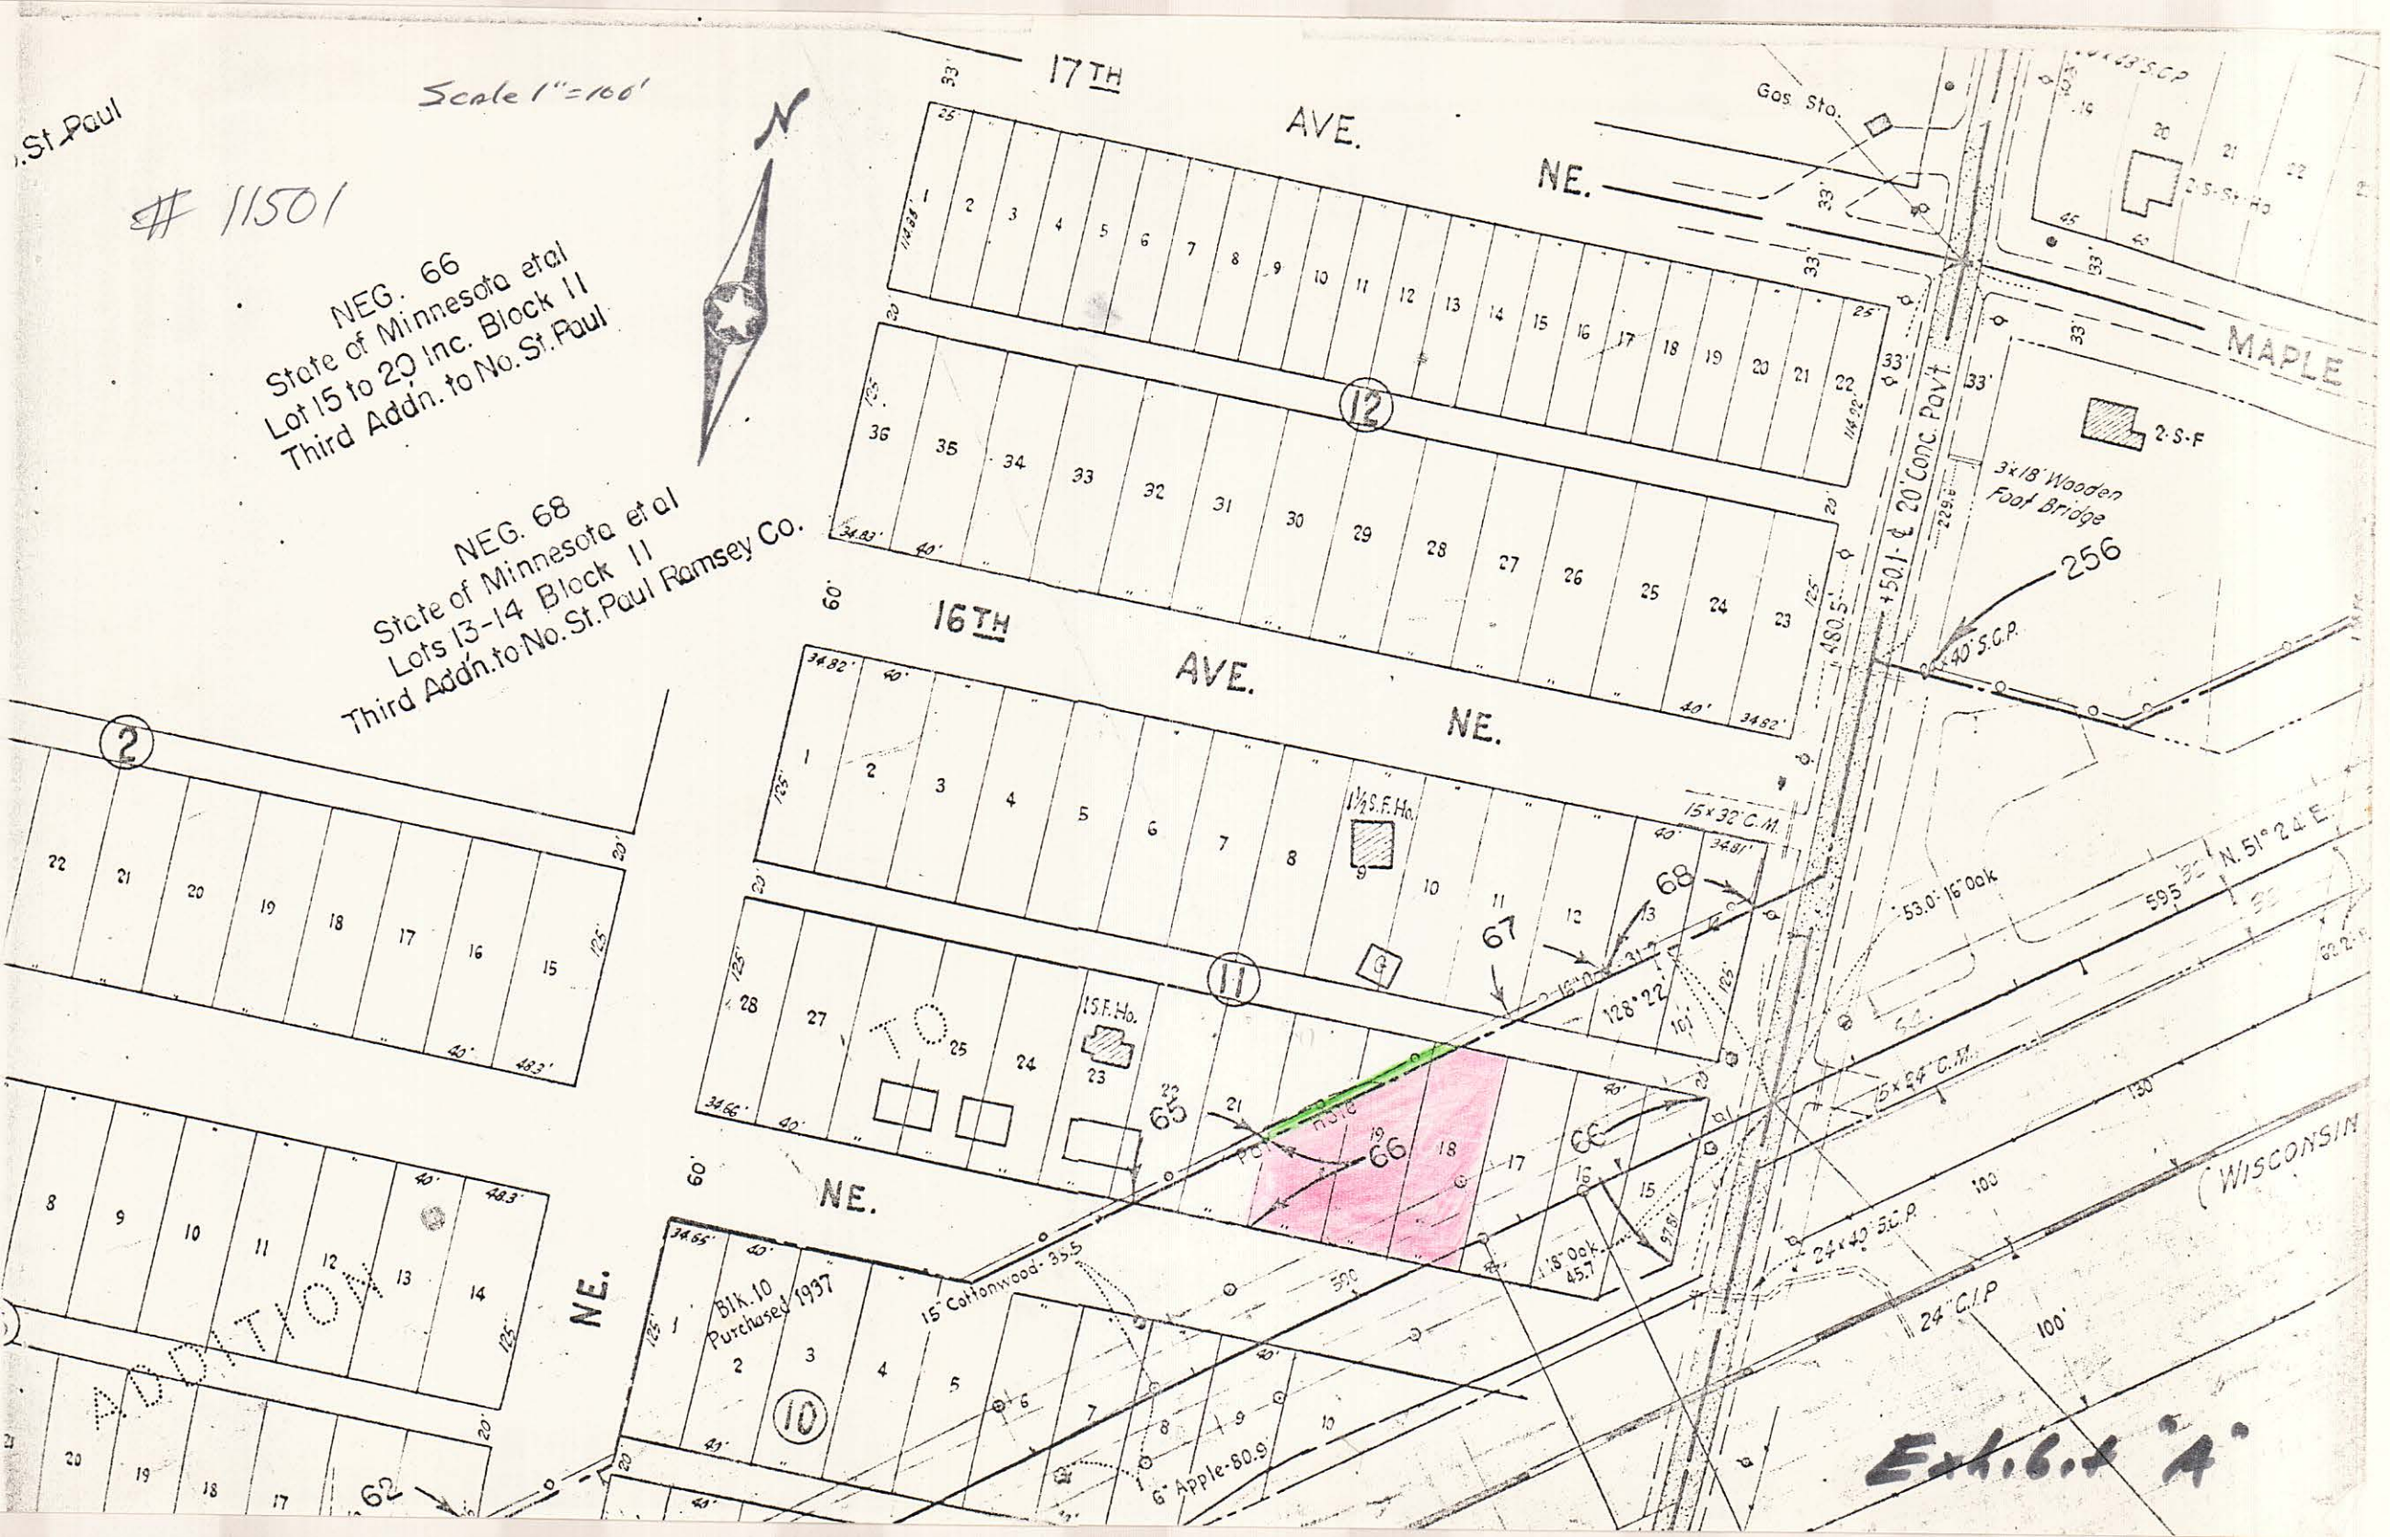

.St Paul
Scale 1"=100'
11501
NEG. 66
State of Minnesota et al
Lot 15 to 20 Inc. Block 11
Third Addn. to No. St. Paul
NEG. 68
State of Minnesota et al
Lots 13-14 Block 11
Third Addn. to No. St. Paul Ramsey Co.
N
17TH AVE. NE.
16TH AVE. NE.
NE.
MAPLE
Gas Sta.
2-S-St-Ho
2-S-F
3x18' Wooden Foot Bridge
+50.1-℄ 20' Conc. Pav't.
256
40' S.C.P.
15x32' C.M.
1½ S.F. Ho.
15 F. Ho.
TO
ADDITION
Blk. 10 Purchased 1937
15" Cottonwood-35.5
6" Apple-80.9
18" Oak 45.7
24x40' S.C.P.
24" C.I.P.
15x24' C.M.
53.0' 16" Oak
N. 51° 24' E.
WISCONSIN
Exhibit "A"