

#11505

GERVAIS LAKE



GOVT LOT 4

GERVAIS

CHANN

SECTION LINE

PART OF GOVT LOT 4

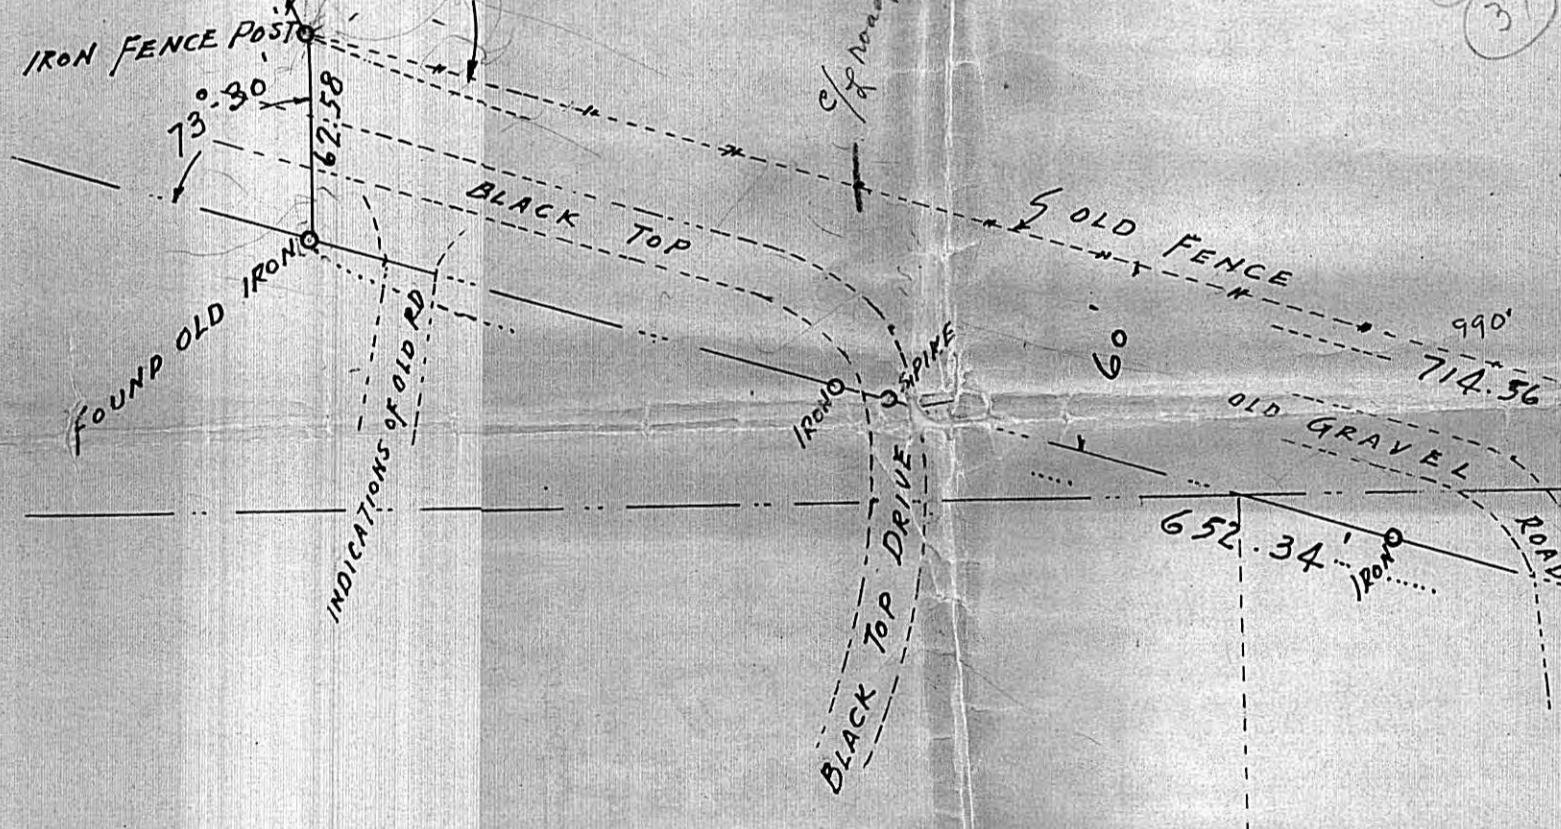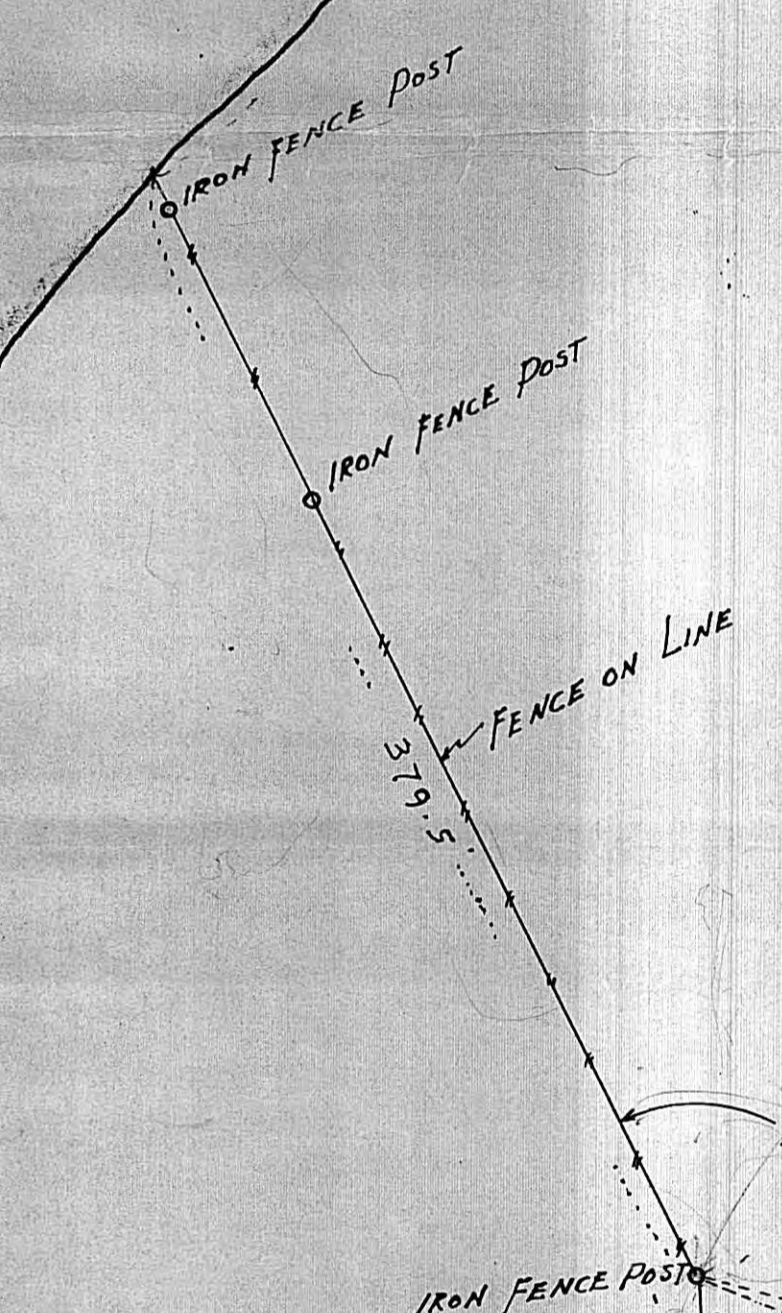

E 1/2 OF N.E. 1/4 OF S.E. 1/4

8 9 ST. MONUMENT AT CORNER

ARCADE 6600

COUNTY ROAD B?

PLAT OF SURVEY OF PART OF GOVT LOT 4 AND PART OF THE E. 1/2 OF THE N.E. 1/4 OF THE S.E. 1/4 OF SECTION 8; PART OF THE S.W. 1/4 OF THE N.W. 1/4 OF SECTION 9 ALL IN TOWNSHIP 29-RANGE RAMSLEY COUNTY, MINN.

H. J. ...
Civil Engineer & Surveyor

Sept 5 - 67

SCALE 1 INCH = 60 FEET.

#11505