


#11506

#11506

LOT PARKING

AVE.

N

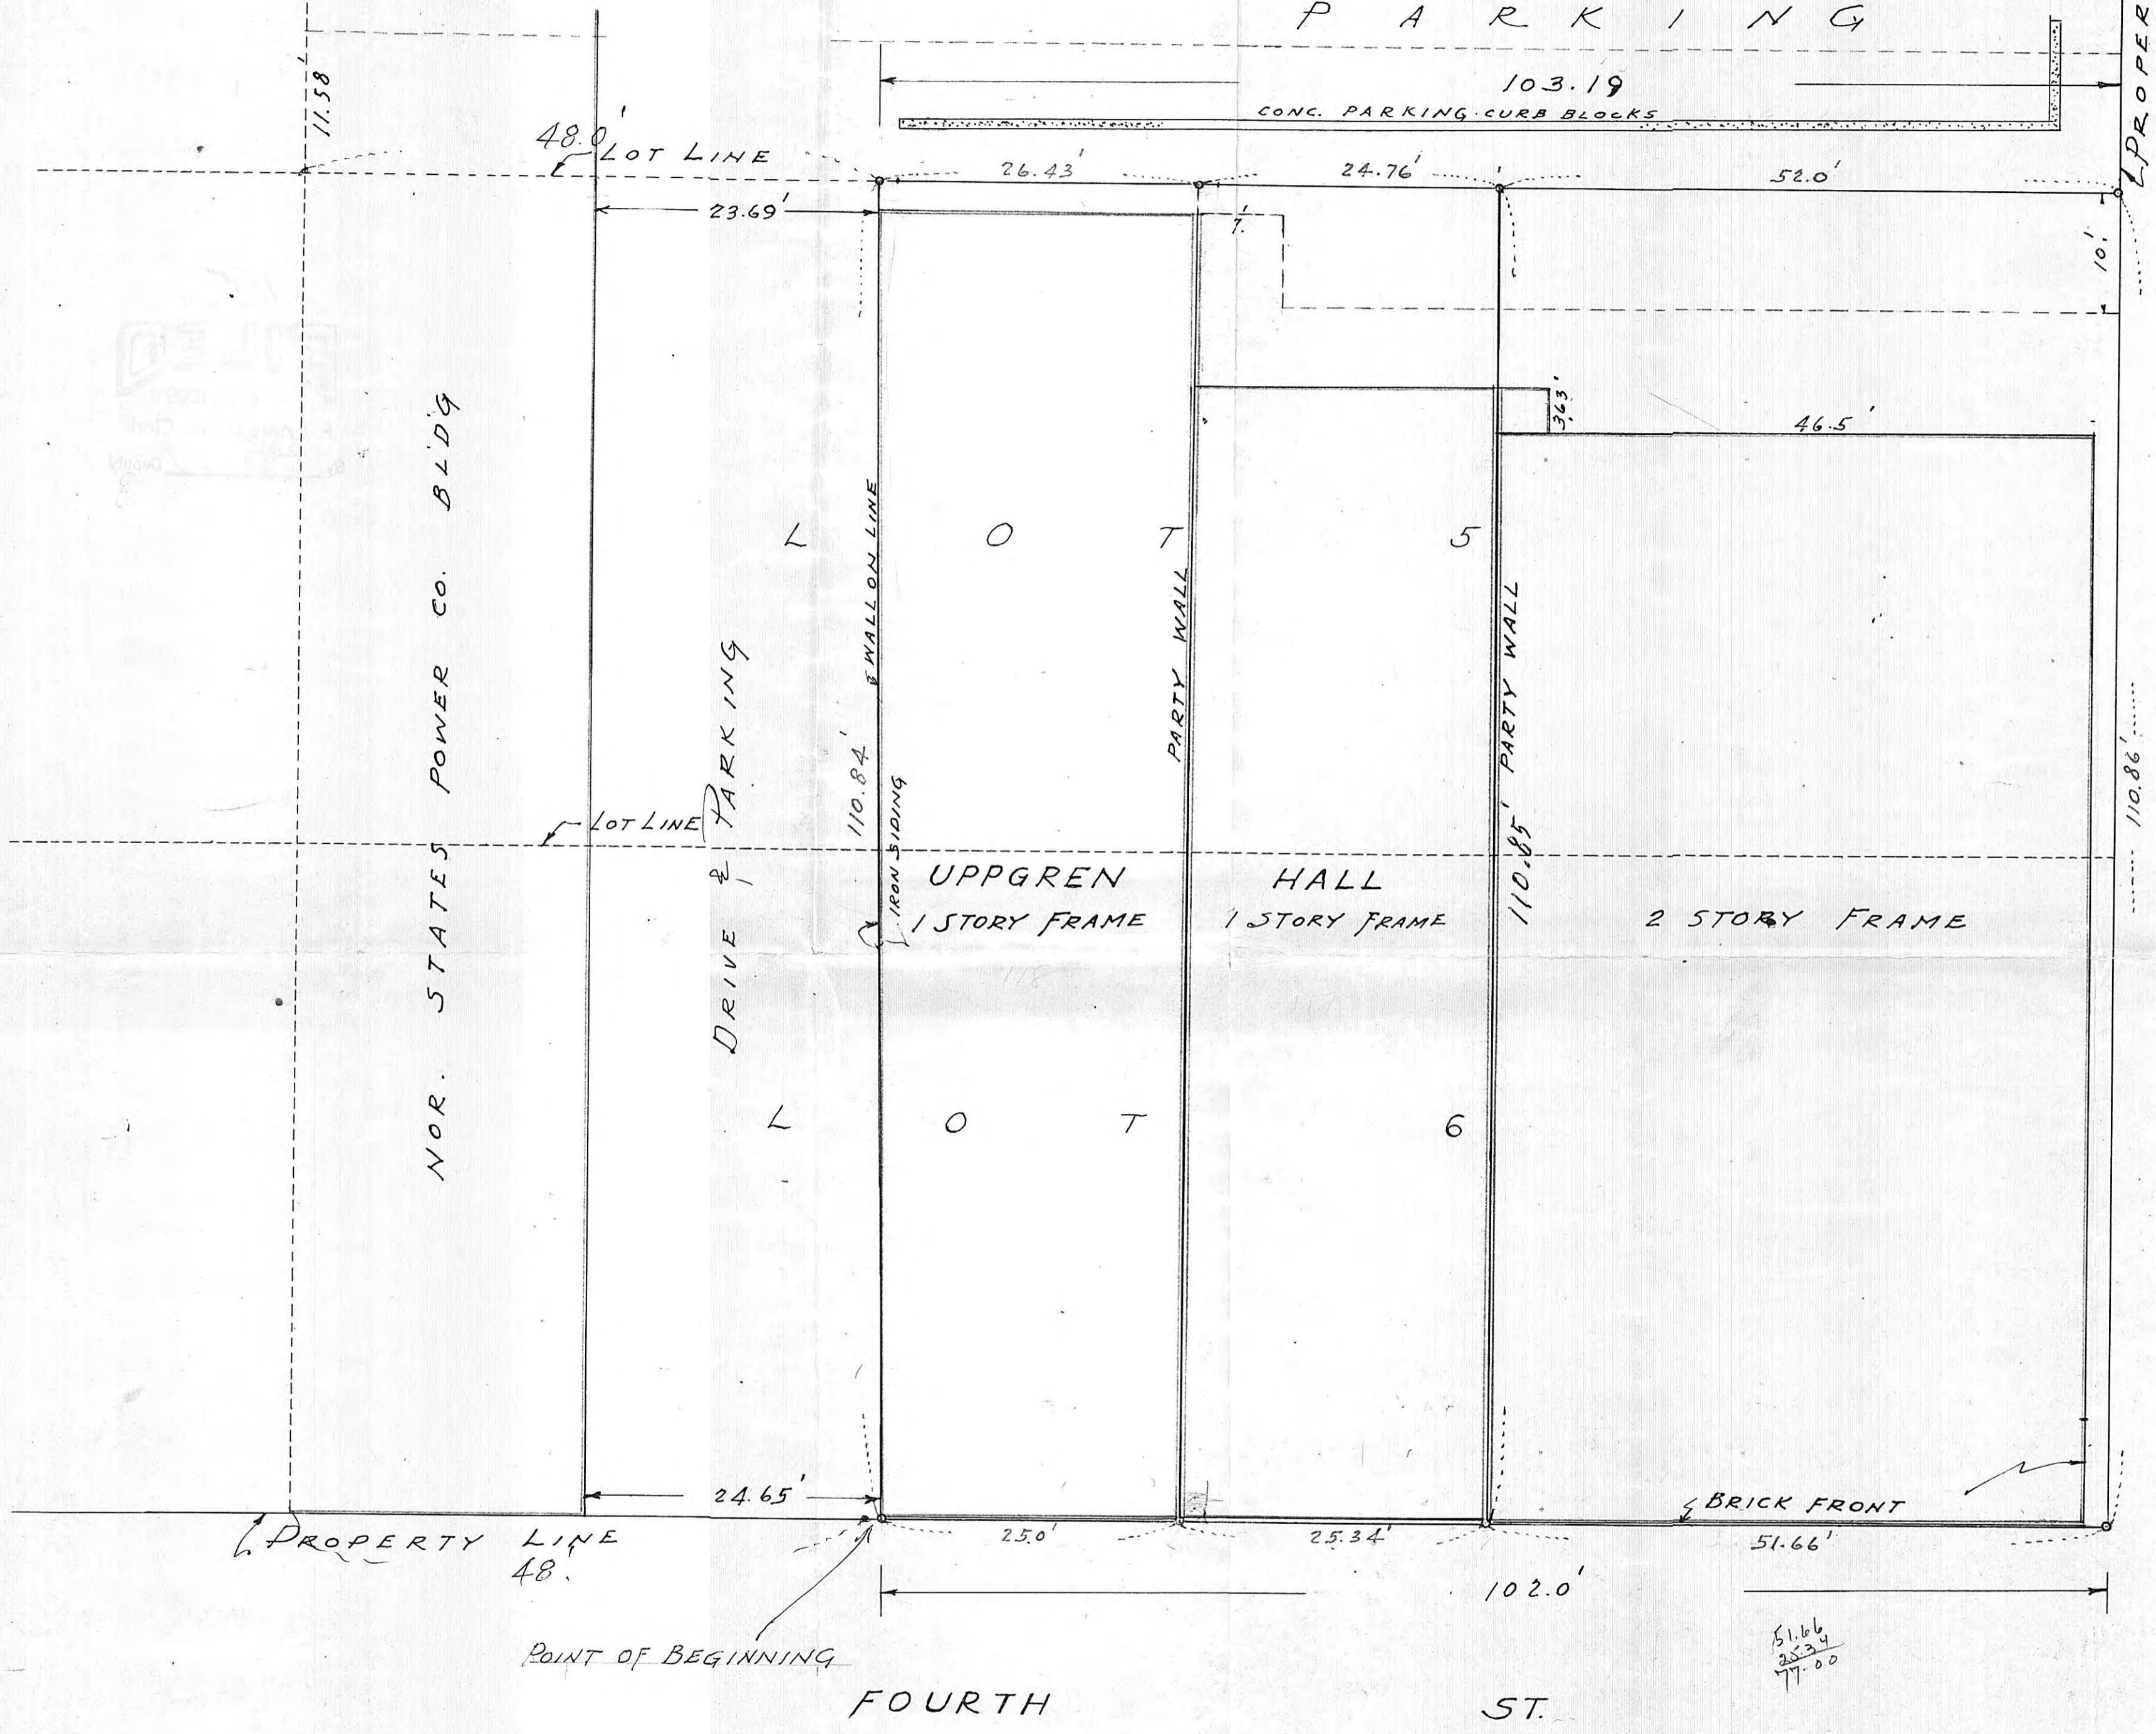

52
24.76
26.43
103.19

51.66
25.34
77.00

SCALE 10 FEET PER INCH

PLAT OF SURVEY OF PART OF
 LOTS 5 & 6 BLOCK 52 PLAT OF
 WHITE BEAR - WHITE BEAR LAKE.
 April 14 1969
 J. Armstrong
 Engr & Surveyor