

11625

11625

Phone 735-4343

WARREN I. FORSBERG


2141 E. 5th Street
St. Paul, Minn.
55119

Registered Land Surveyor


SURVEY FOR: **PETER LINDER**

PKY.

described as: **LOT 16 AND 21, EXCEPT PART TAKEN FOR WHELOCK PARKWAY, BLOCK 5, RICE ST. VILLAS, ST. PAUL, MINN.**

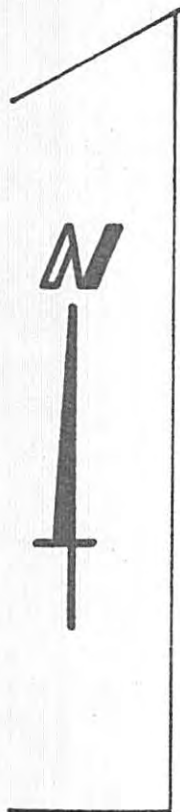

GALTIER ST.
55'

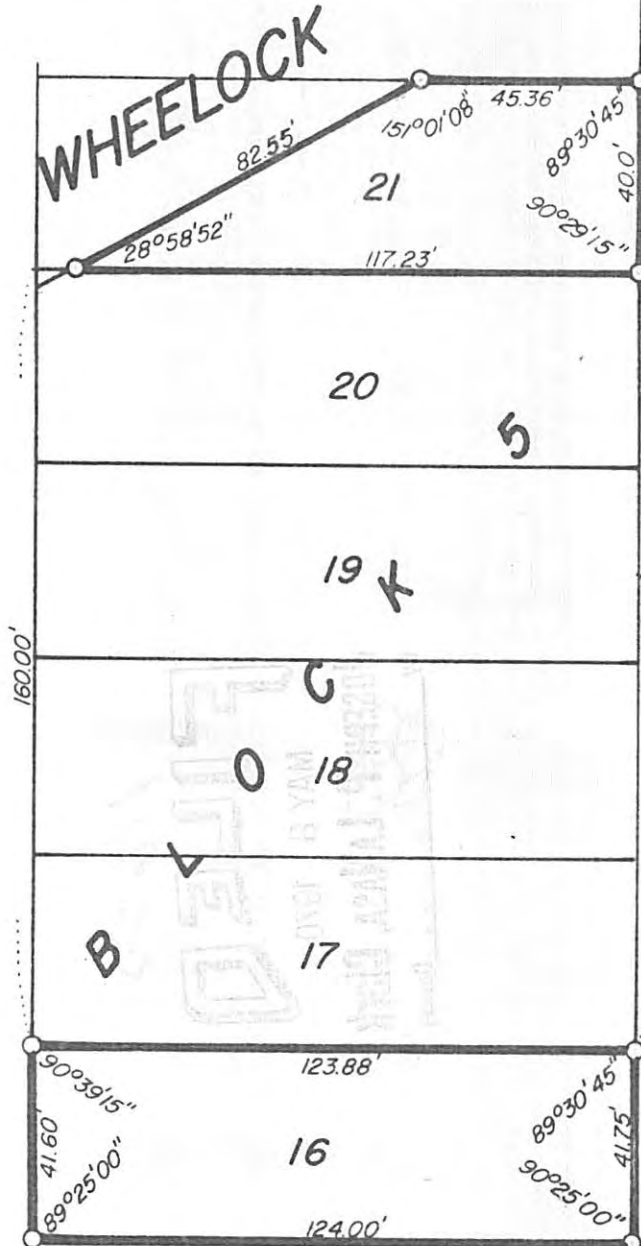

CERTIFICATE OF SURVEY

I hereby certify that on MARCH 24, 1970 I surveyed the property described above and that the above plat is a correct representation of said survey

GRANITE MONUMENT
N.W. CORNER BLOCK 11

Scale: 1 inch = 40 feet

O — Indicates Iron Monument

Signed