


○ Indicates Irons
Scale: 1" = 60'

Plat Of Survey
Sept. 11, 1956

K. Anker—Surveyor
Reg. No. 2042

Description: Lots 28, 29, 30 and 31, Block 7, and Lots 4, 5, 6, 7, 8 and 9, Block 10,
Palasade Addition to St. Paul.


11649

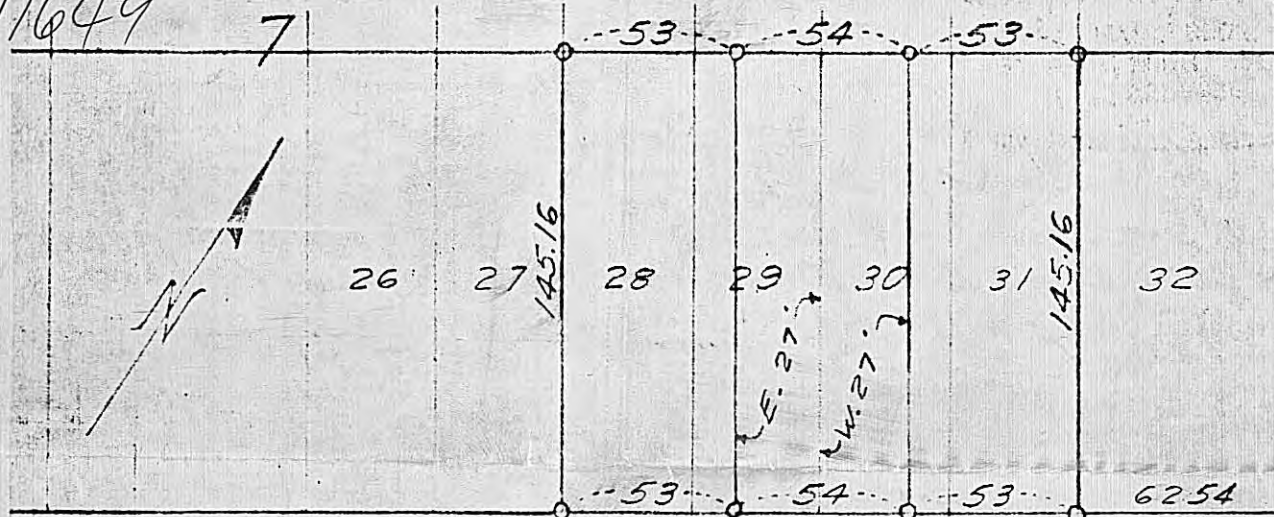

ROCKWOOD

AVE.

60

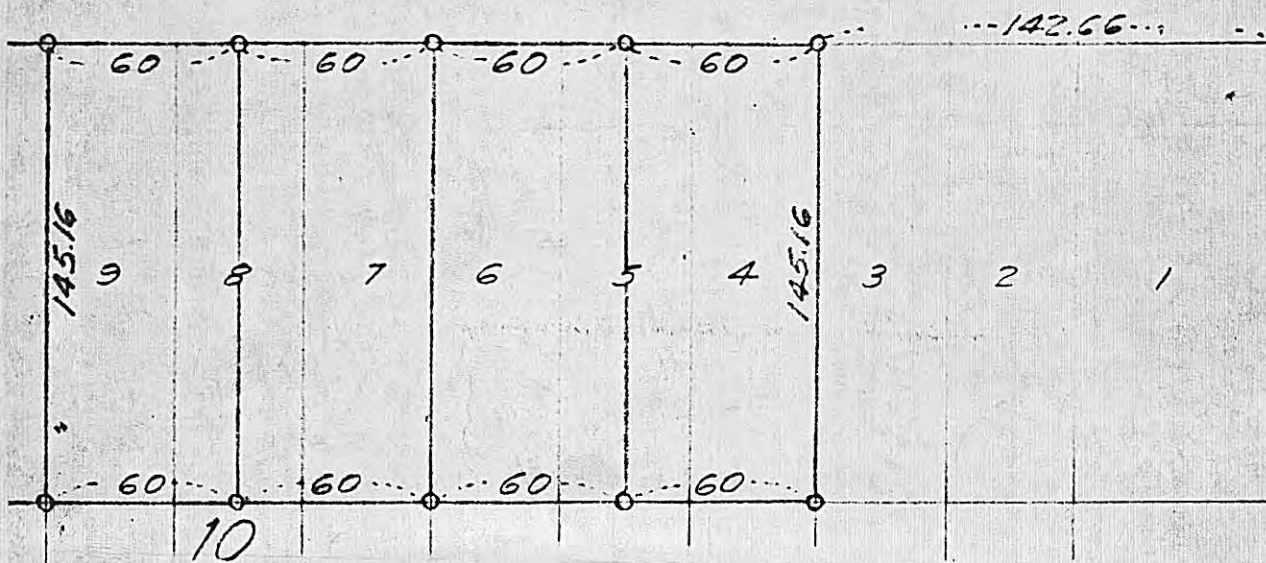

MADISON ST.

Description of parcels in Block 7;

Lot 28 and Lot 29 except the Easterly 27 feet thereof.

The Easterly 27 feet of Lot 29 and the Westerly 27 feet of Lot 30.

Lot 30 except the Westerly 27 feet thereof and all of Lot 31.

Description of parcels in Block 10;

Lot 4 and the Easterly $\frac{1}{2}$ of Lot 5.

The Westerly $\frac{1}{2}$ of Lot 5 and all of Lot 6.

Lot 7 and the Easterly $\frac{1}{2}$ of Lot 8.

The Westerly $\frac{1}{2}$ of lot 8 and all of Lot 9.

Exhibit 1

#11649

SIBLEY MANOR

