PLAT OF SURVEY

JOHN J. RYAN CO.

REITER - 353 MICHIGAN ST.

THE EAST 3/4 OF LOT 10
BLOCK 11 WINSLOW ADDITION

SCALE: 1" = 30'

#11730

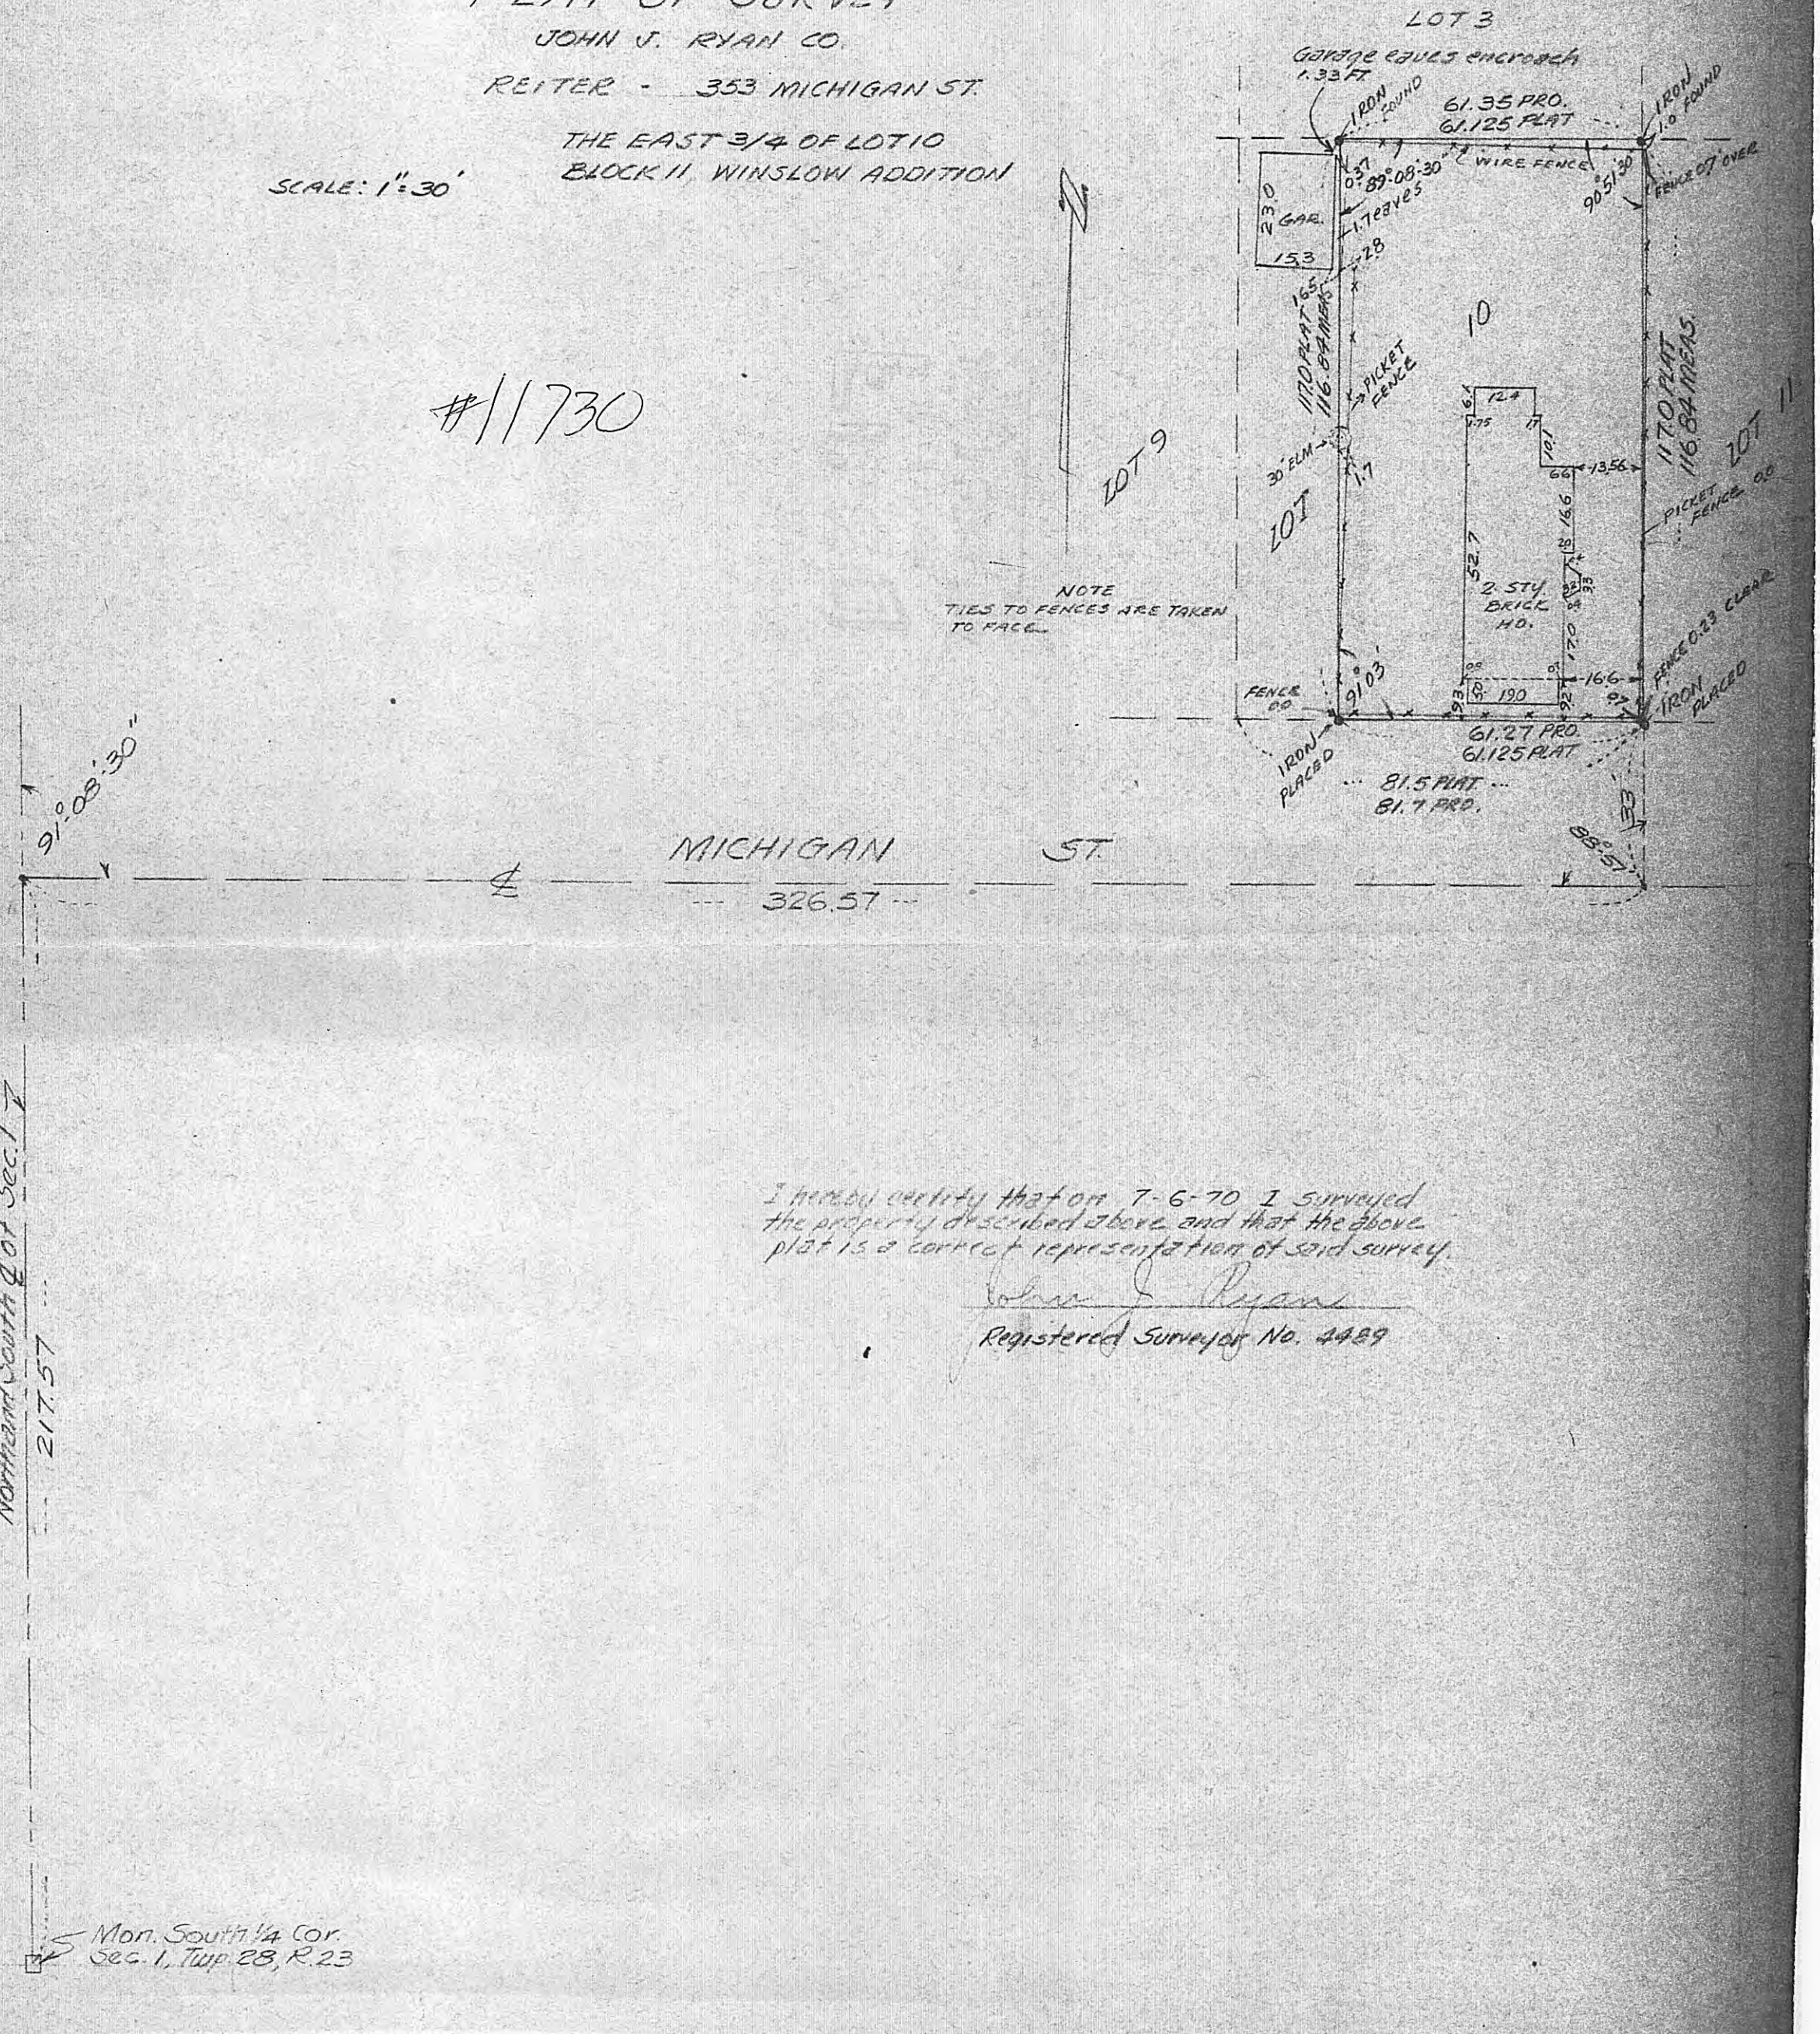

NOTE
TIES TO FENCES ARE TAKEN TO FACE

I hereby certify that on 7-6-70 I surveyed the property described above and that the above plat is a correct representation of said survey.

John J. Ryan

Registered Surveyor No. 1429