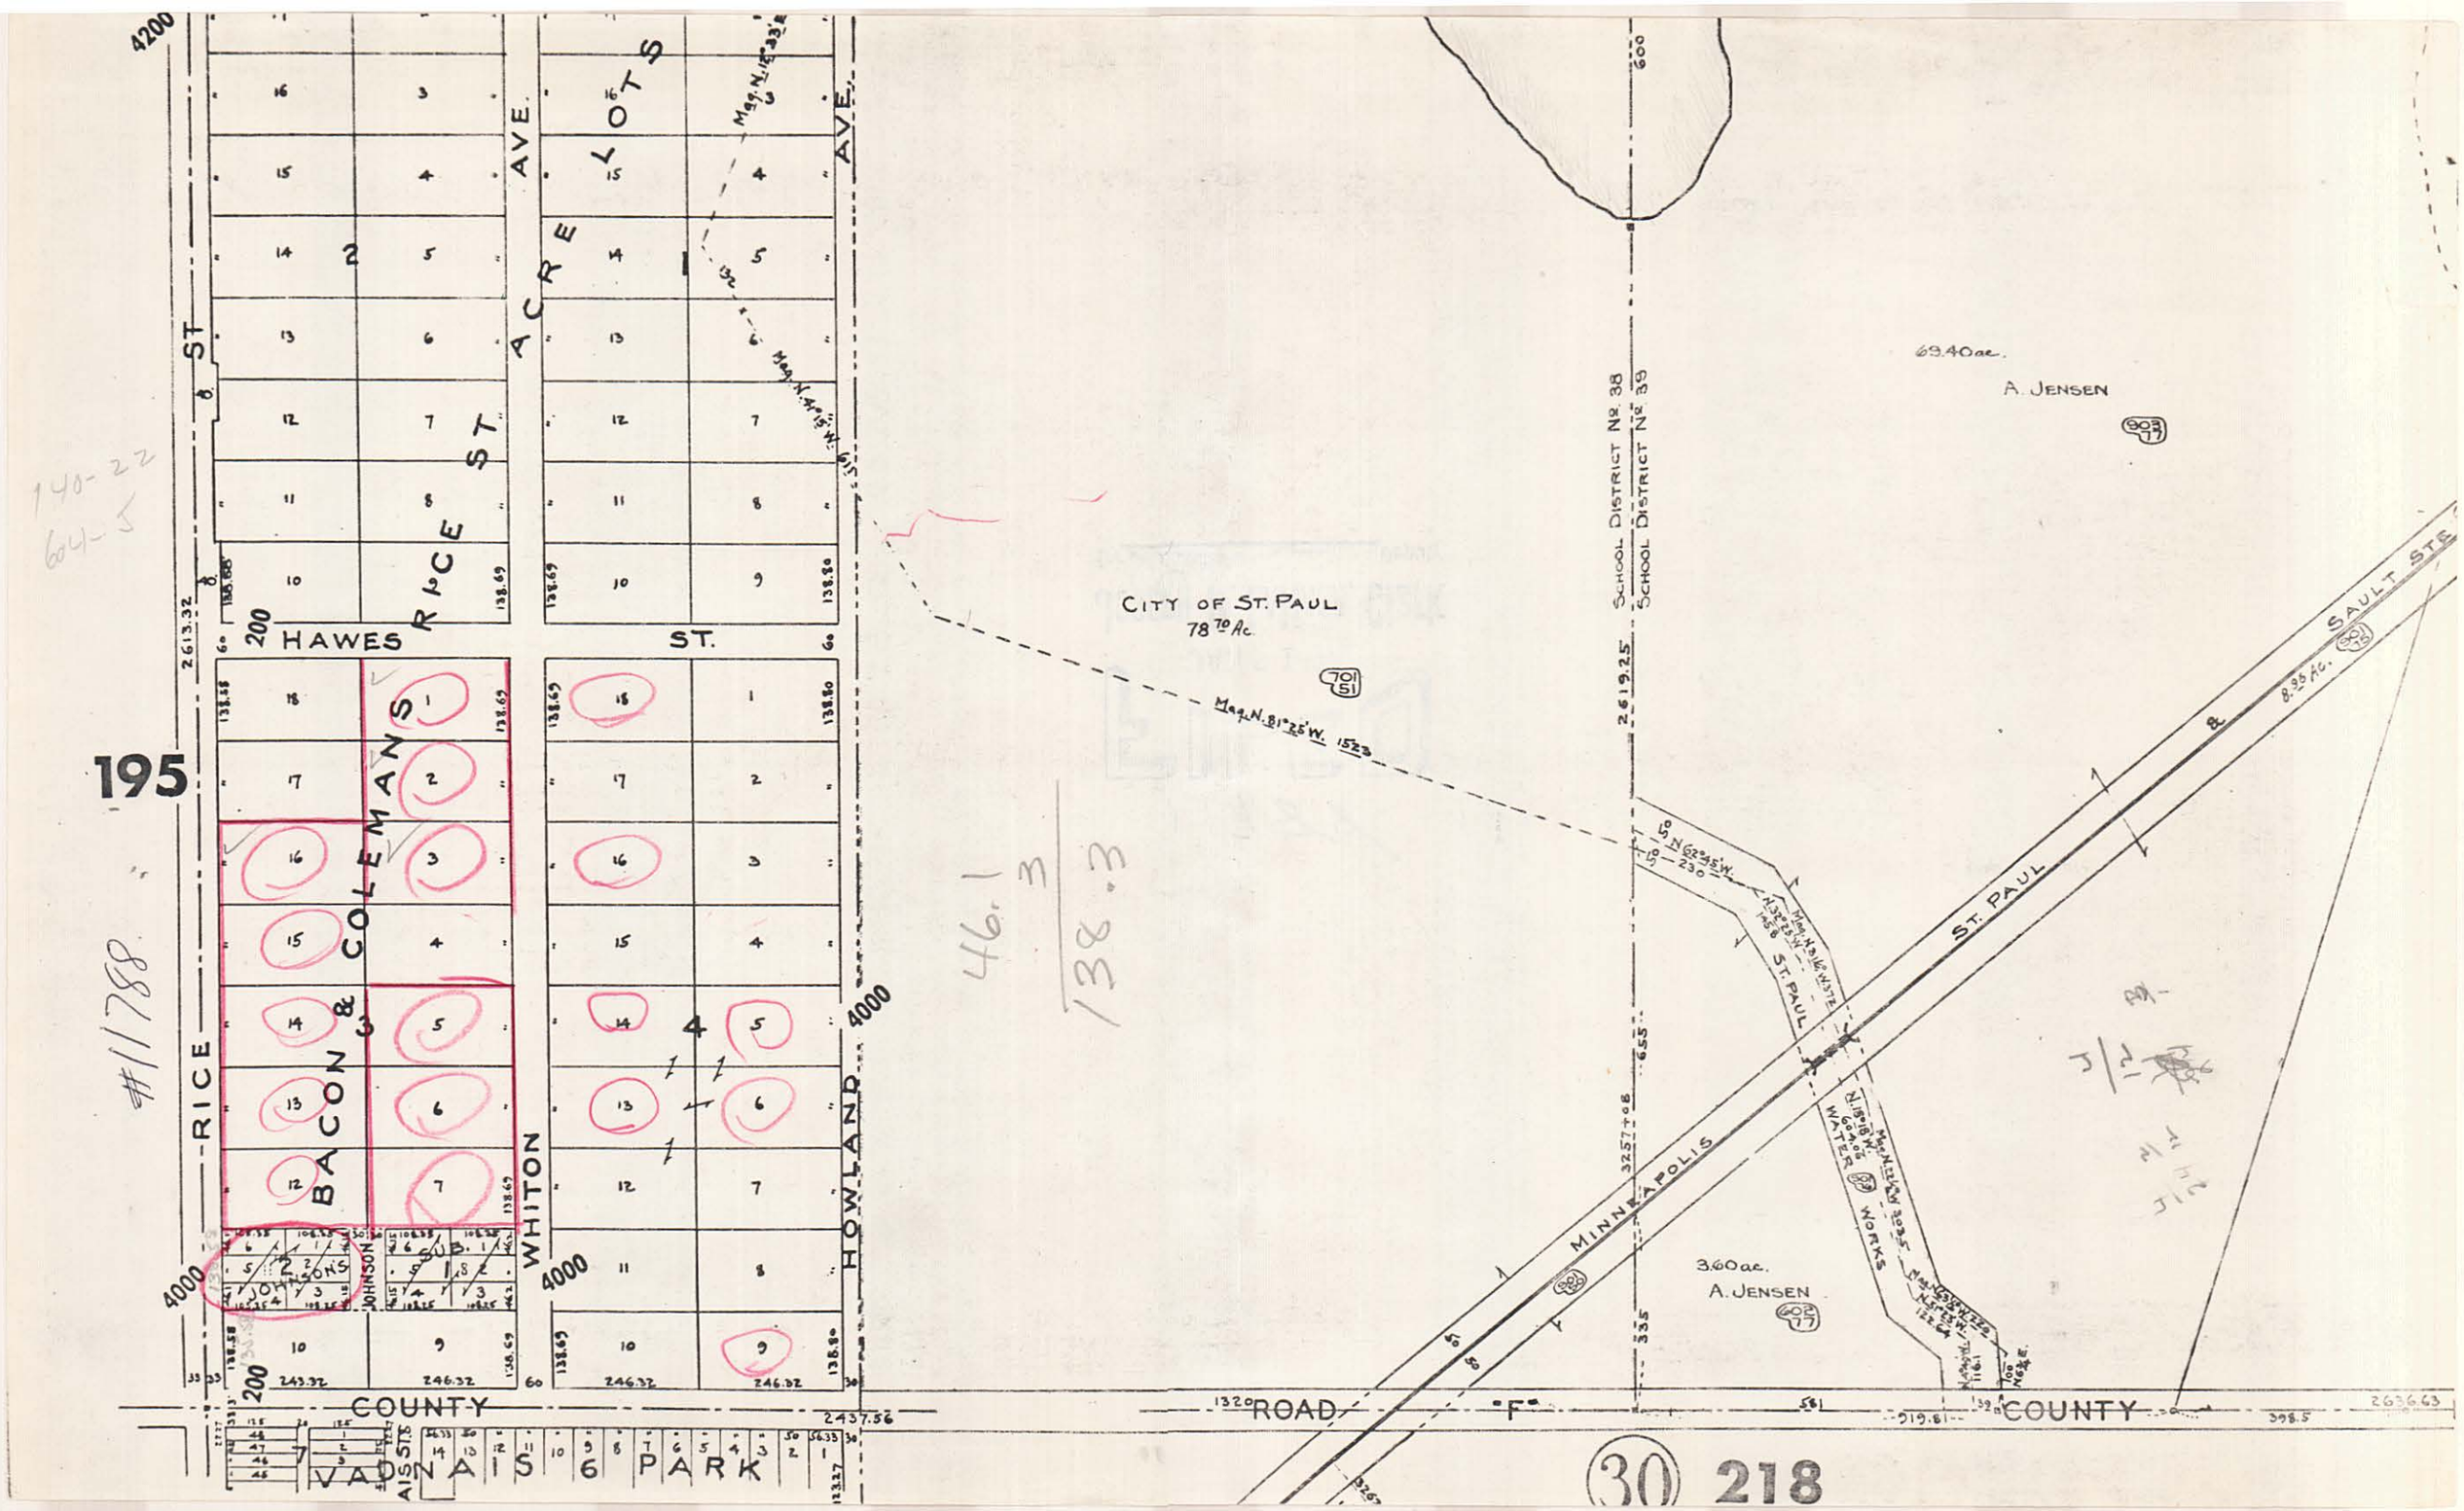

195
#11788
140-22
604-5
46.1
3
138.3
RICE ST
HAWES ST.
BACON & COLEMANS RICE ST ACRE LOTS
WHITON AVE.
HOWLAND AVE.
JOHNSONS SUB.
COUNTY ROAD "F" COUNTY
VADNAIS PARK
CITY OF ST. PAUL
78.70 Ac.
SCHOOL DISTRICT No. 38
SCHOOL DISTRICT No. 39
69.40 ac.
A. JENSEN
3.60 ac.
A. JENSEN
MINNEAPOLIS ST. PAUL
SAULT STE
WATER WORKS
30
218