


Applicants & A.

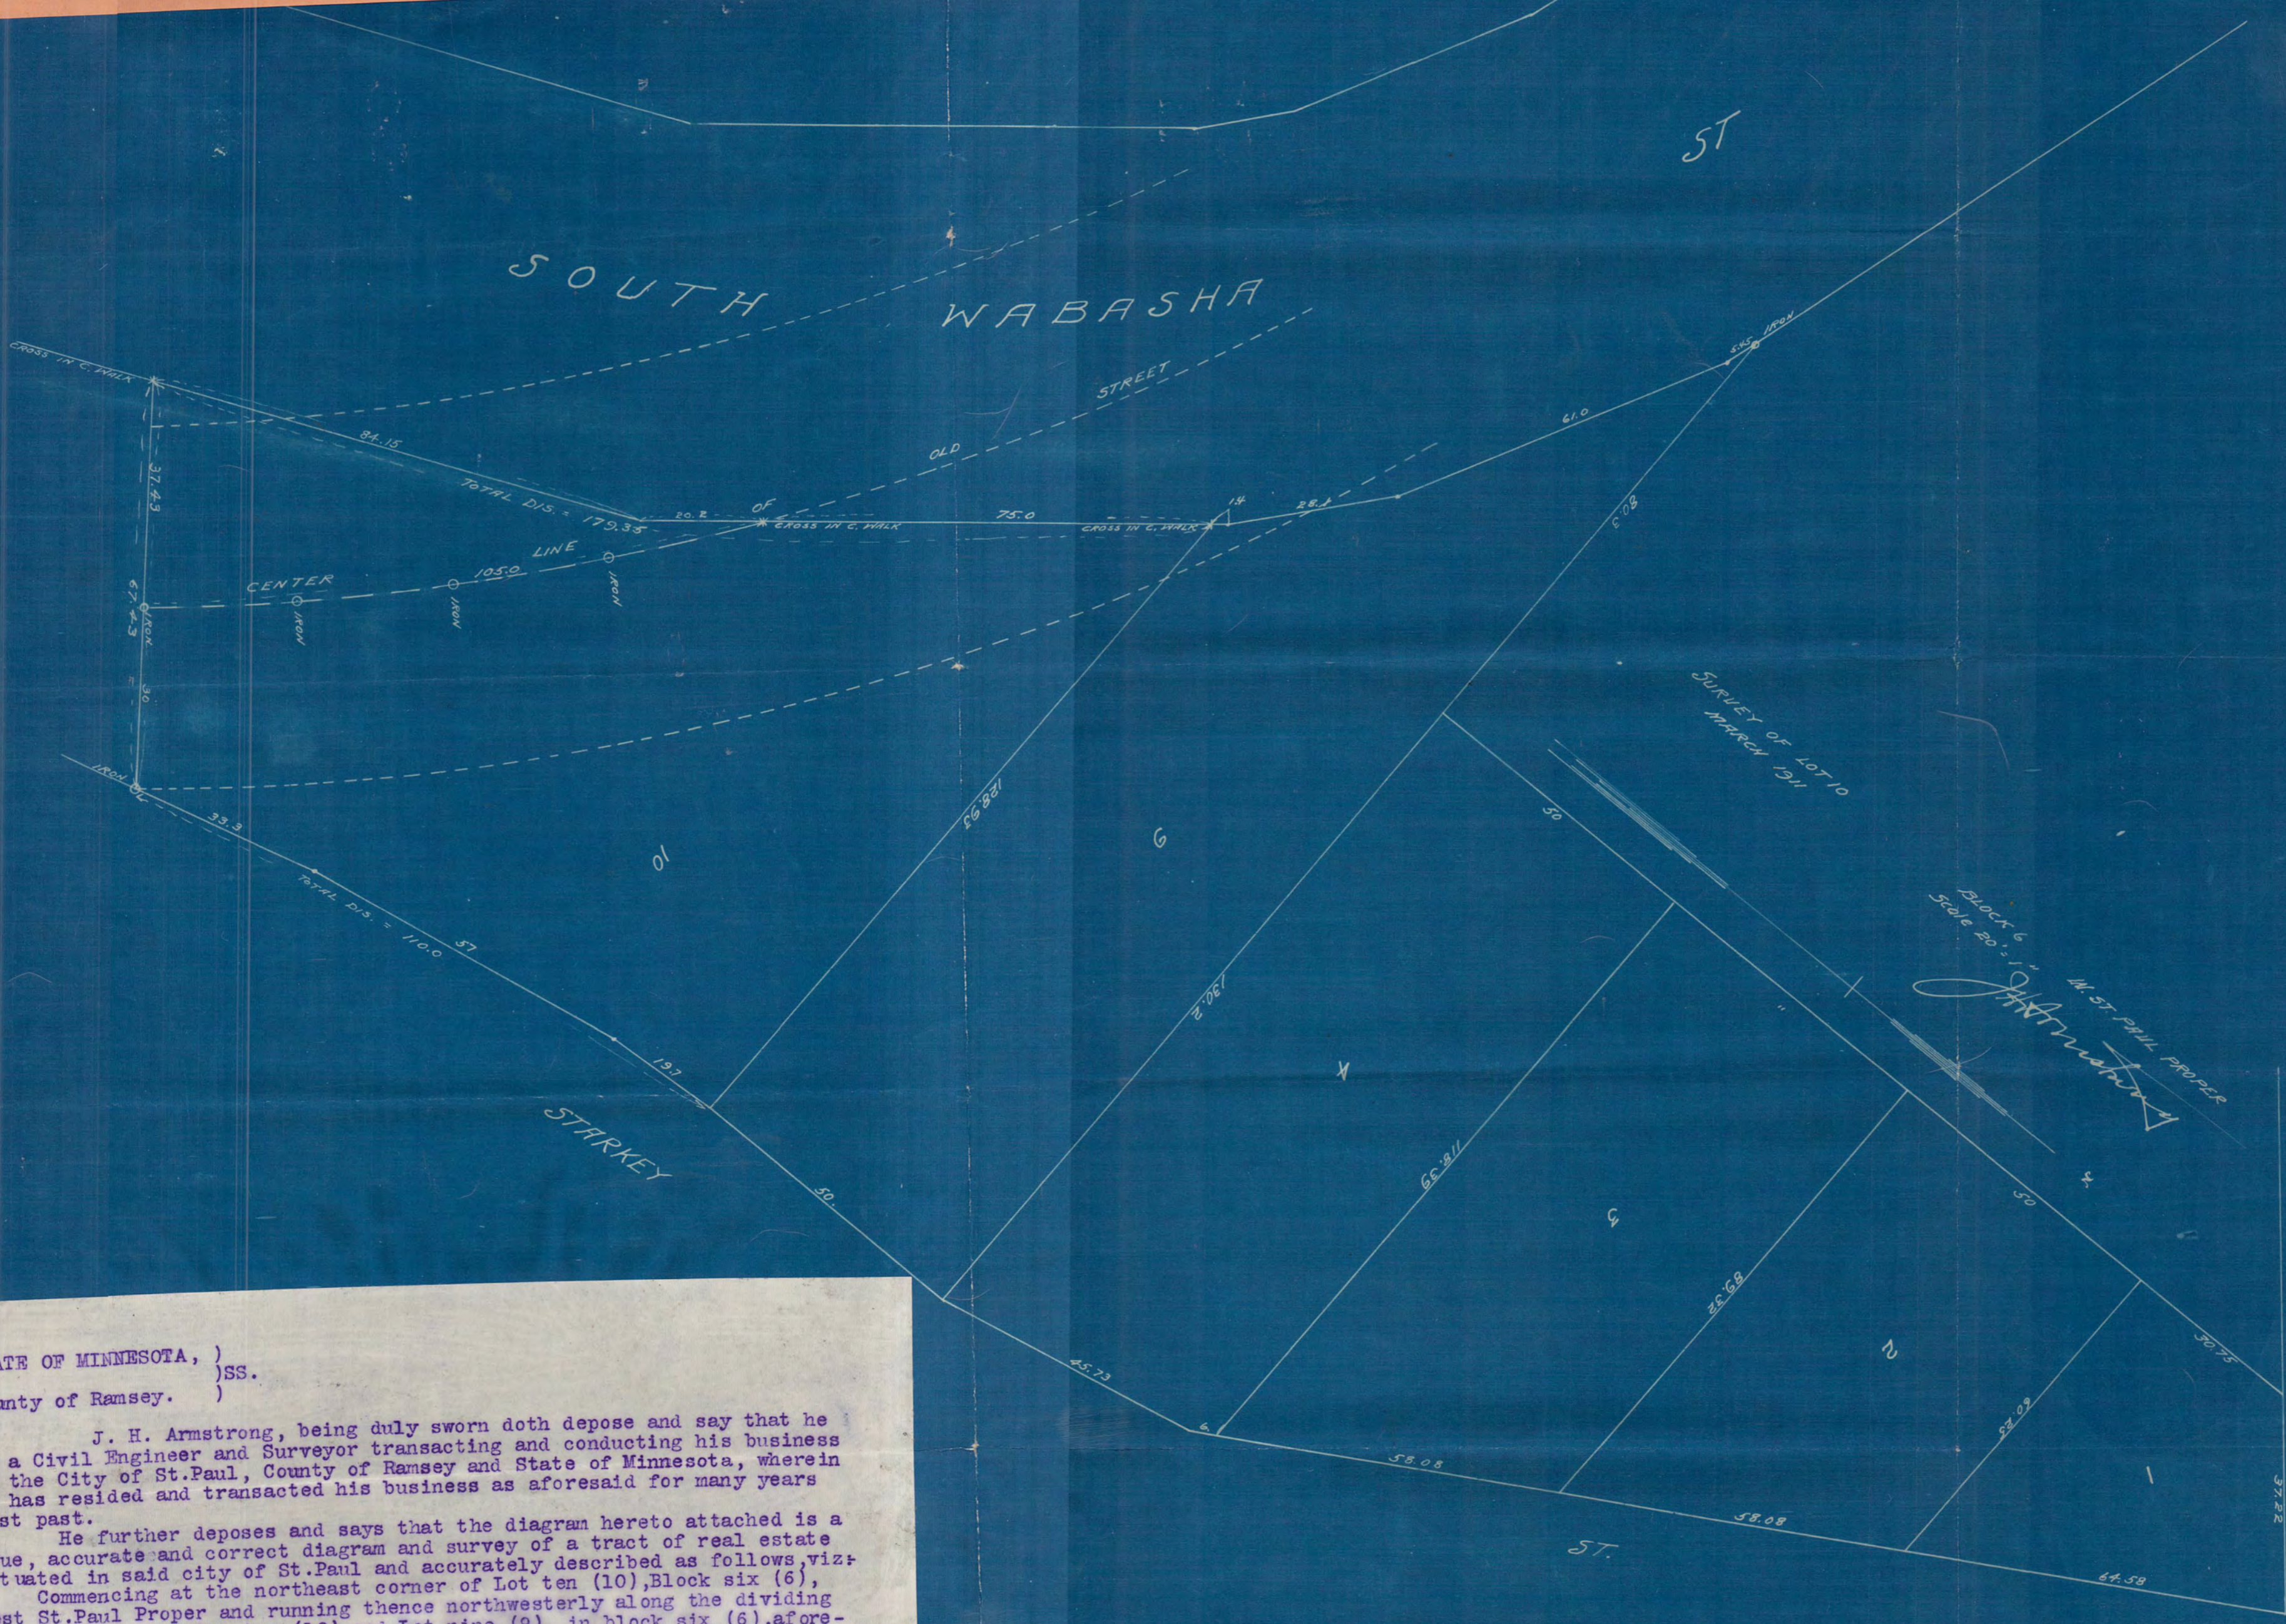

STATE OF MINNESOTA,)
 County of Ramsey.)SS.

J. H. Armstrong, being duly sworn doth depose and say that he is a Civil Engineer and Surveyor transacting and conducting his business in the City of St. Paul, County of Ramsey and State of Minnesota, wherein he has resided and transacted his business as aforesaid for many years last past.

He further deposes and says that the diagram hereto attached is a true, accurate and correct diagram and survey of a tract of real estate situated in said city of St. Paul and accurately described as follows, viz:

Commencing at the northeast corner of Lot ten (10), Block six (6), West St. Paul Proper and running thence northwesterly along the dividing line between said Lot ten (10) and Lot nine (9), in block six (6), aforesaid, one hundred twenty-eight and 93/100 (128.93) feet to the easterly line of South Wabasha Street, as it now exists; thence running southeasterly along the existing easterly line of said South Wabasha Street, one hundred seventy-nine and 35/100 (179.35) feet to a cross in the cement sidewalk; thence running northeasterly sixty-seven and 43/100 (67.43) feet to an iron monument on the westerly line of Starkey Street; thence northwesterly along the westerly line of said Starkey Street, one hundred ten (110) feet to the point of beginning. Said tract of real estate being otherwise known and described as Lot ten (10), Block six (6) of the Original Town of West St. Paul, commonly known as West St. Paul Proper according to the recorded plat thereof on file and of record in the office of the Register of Deeds in and for the County of Ramsey and State of Minnesota.

Affiant further deposes and says that said survey was made by him as aforesaid on the 28th day of March, A.D. 1911.

Subscribed and sworn to before me this 28th day of March, A. D. 1911.

Notary Public, Ramsey County, Minnesota.
 My Commission expires

J. H. Armstrong
William G. White
 Jan. 4, 1914.

1201