

GERALD T. COYNE
300 BRUNSWICK AVE. S.
GOLDEN VALLEY, MINN.
MINN. REG. NO. 4741

LOT SURVEYS COMPANY

LAND SURVEYORS


REGISTERED UNDER LAWS OF STATE OF MINNESOTA
LICENSED BY ORDINANCE OF CITY OF MINNEAPOLIS

5747 W. Broadway
Minneapolis, Minnesota 55428

RAYMOND A. PRASCH
6917 IDAHO AVE. N.
BROOKLYN PARK, MINN.
MINN. REG. NO. 6743

TOM BUDZYNSKI

16th STREET N.

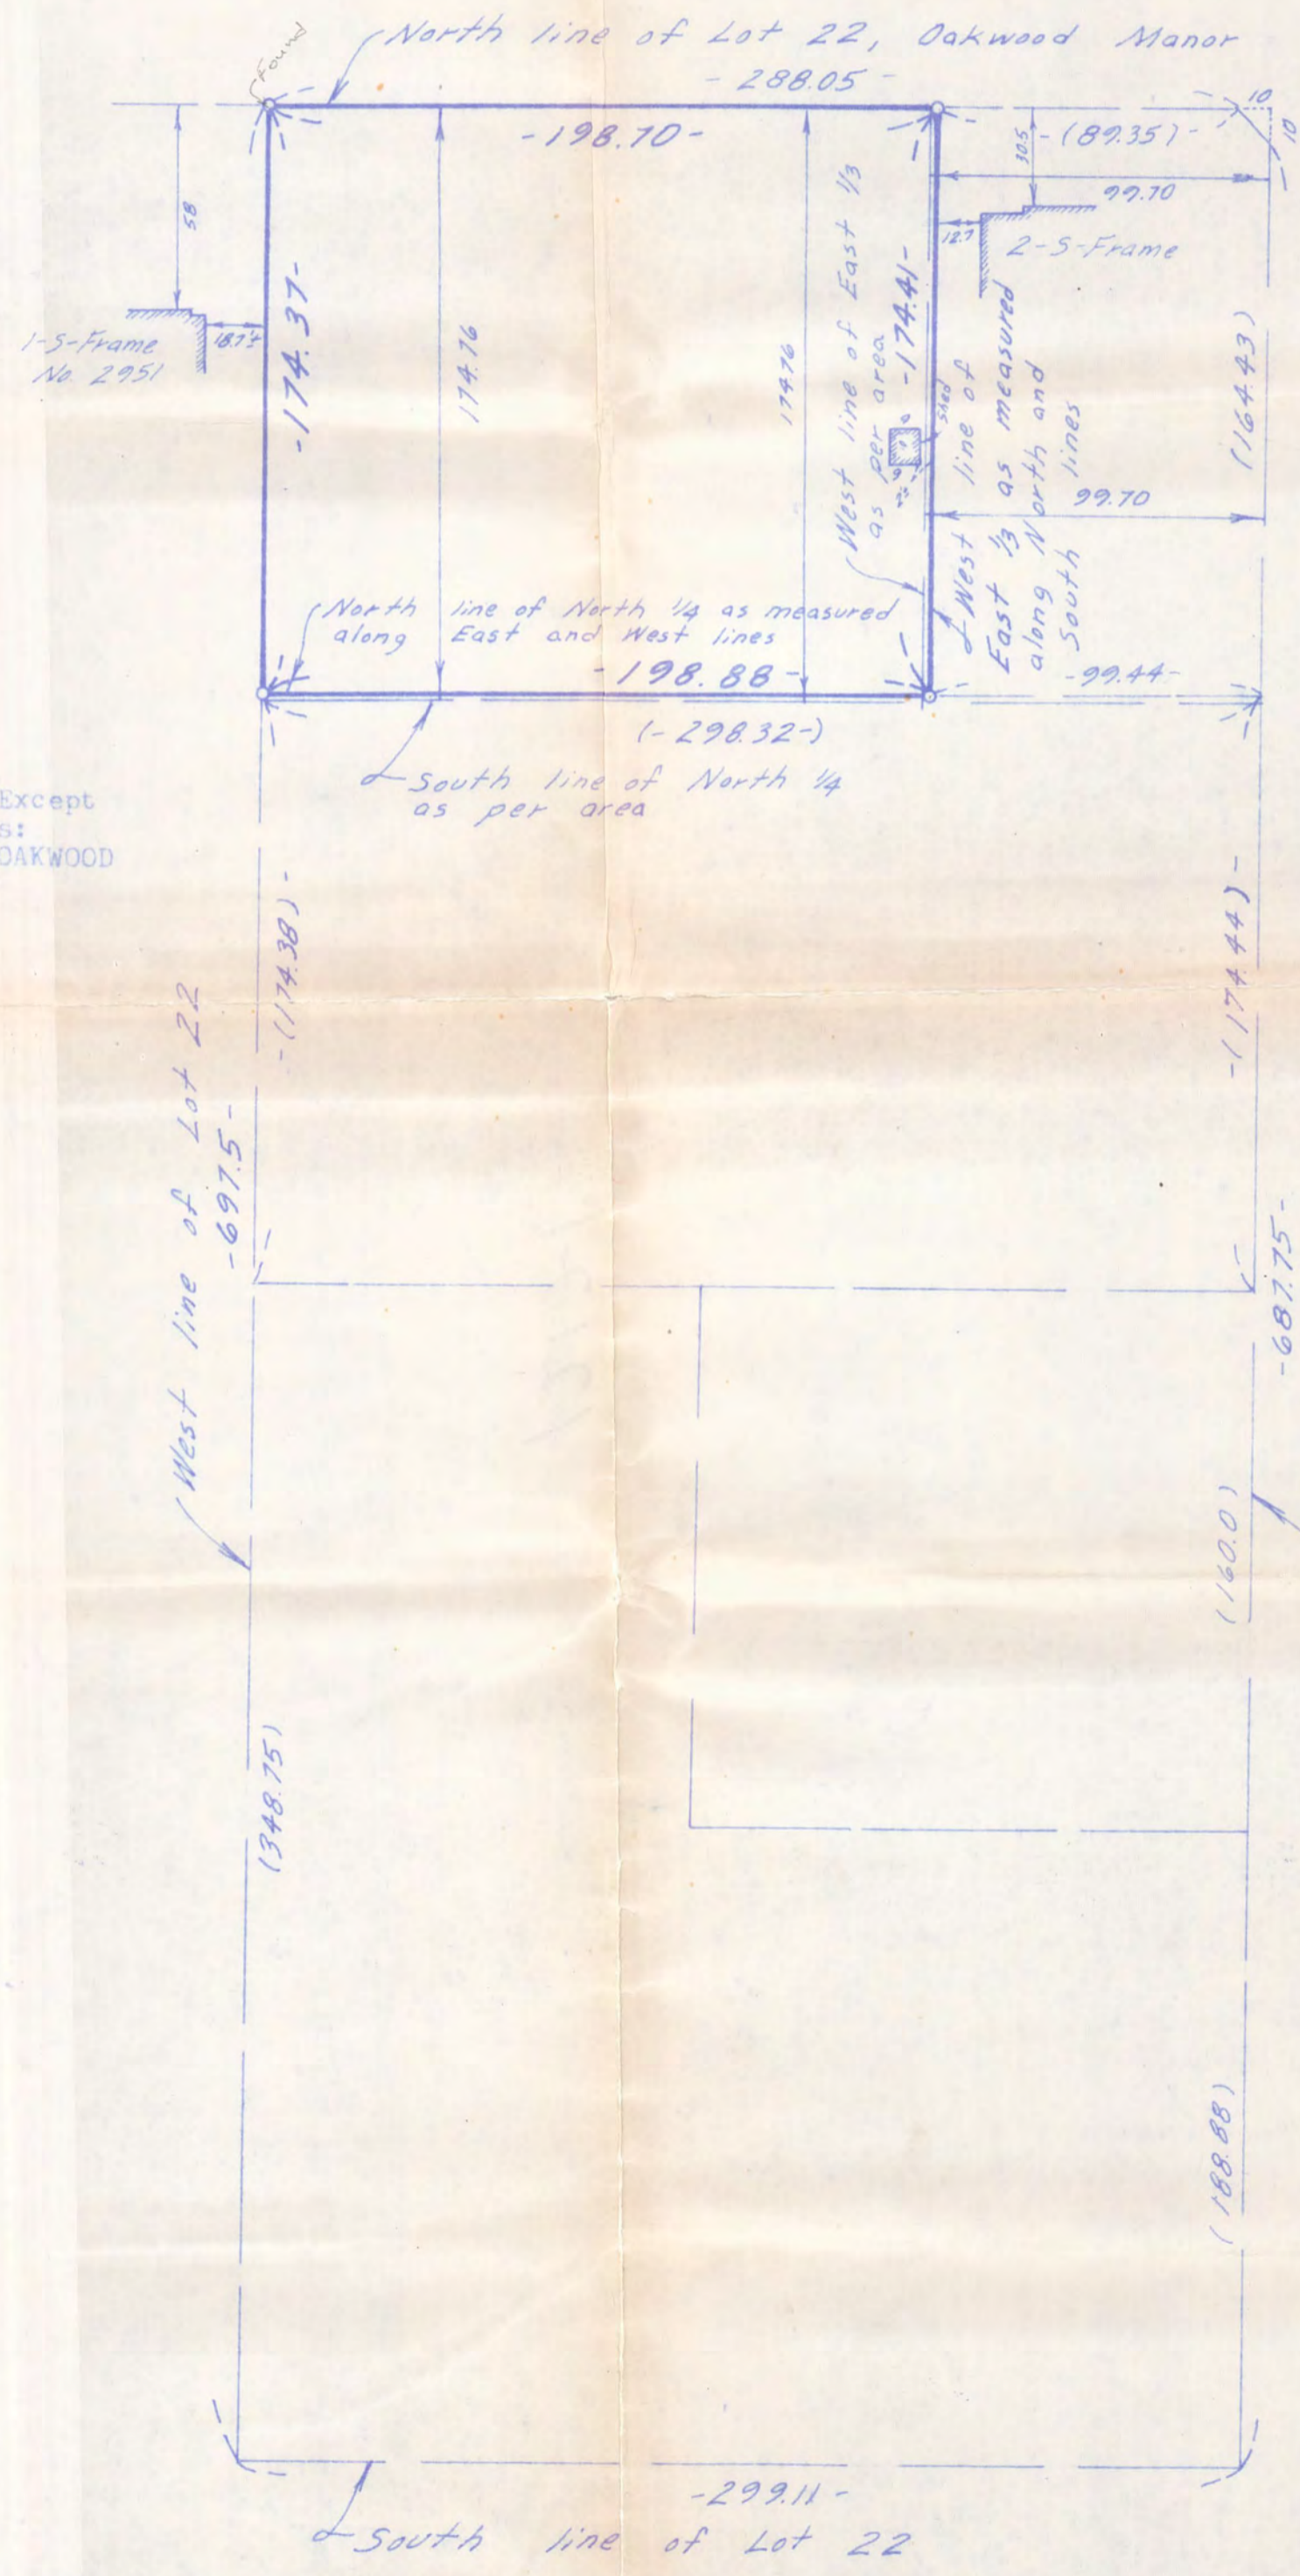

Scale 1" = 50'
Invoice # 5646
F.B. 164-53
o Denotes Iron

The North 1/2 of Lot 22, OAKWOOD MANOR. Except therefrom partial redemption described as:
The East 1/3 of the North 1/4 of Lot 22, OAKWOOD MANOR.

We hereby certify that this is a true and correct representation of a survey of the boundaries of the above described land and the location of all buildings and visible encroachments, if any, from or on said land.

Surveyed by us this 24th day of February 19 77

Signed Gerald T. Coyne

LOT SURVEYS COMPANY

12/21
FILED
MAY 10 1977
JOSEPH F. LAWASA, CLERK
[Signature]

GERALD T. COYNE
300 BRUNSWICK AVE. S.
GOLDEN VALLEY, MINN.
MINN. REG. NO. 4741

LOT SURVEYS COMPANY

LAND SURVEYORS

RAYMOND A. PRASCH
6917 IDAHO AVE. N.
BROOKLYN PARK, MINN.
MINN. REG. NO. 6743


REGISTERED UNDER LAWS OF STATE OF MINNESOTA
LICENSED BY ORDINANCE OF CITY OF MINNEAPOLIS

5747 W. Broadway
Minneapolis, Minnesota 55428

533-9922

SURVEY FOR:

TOM BUDZYNSKI

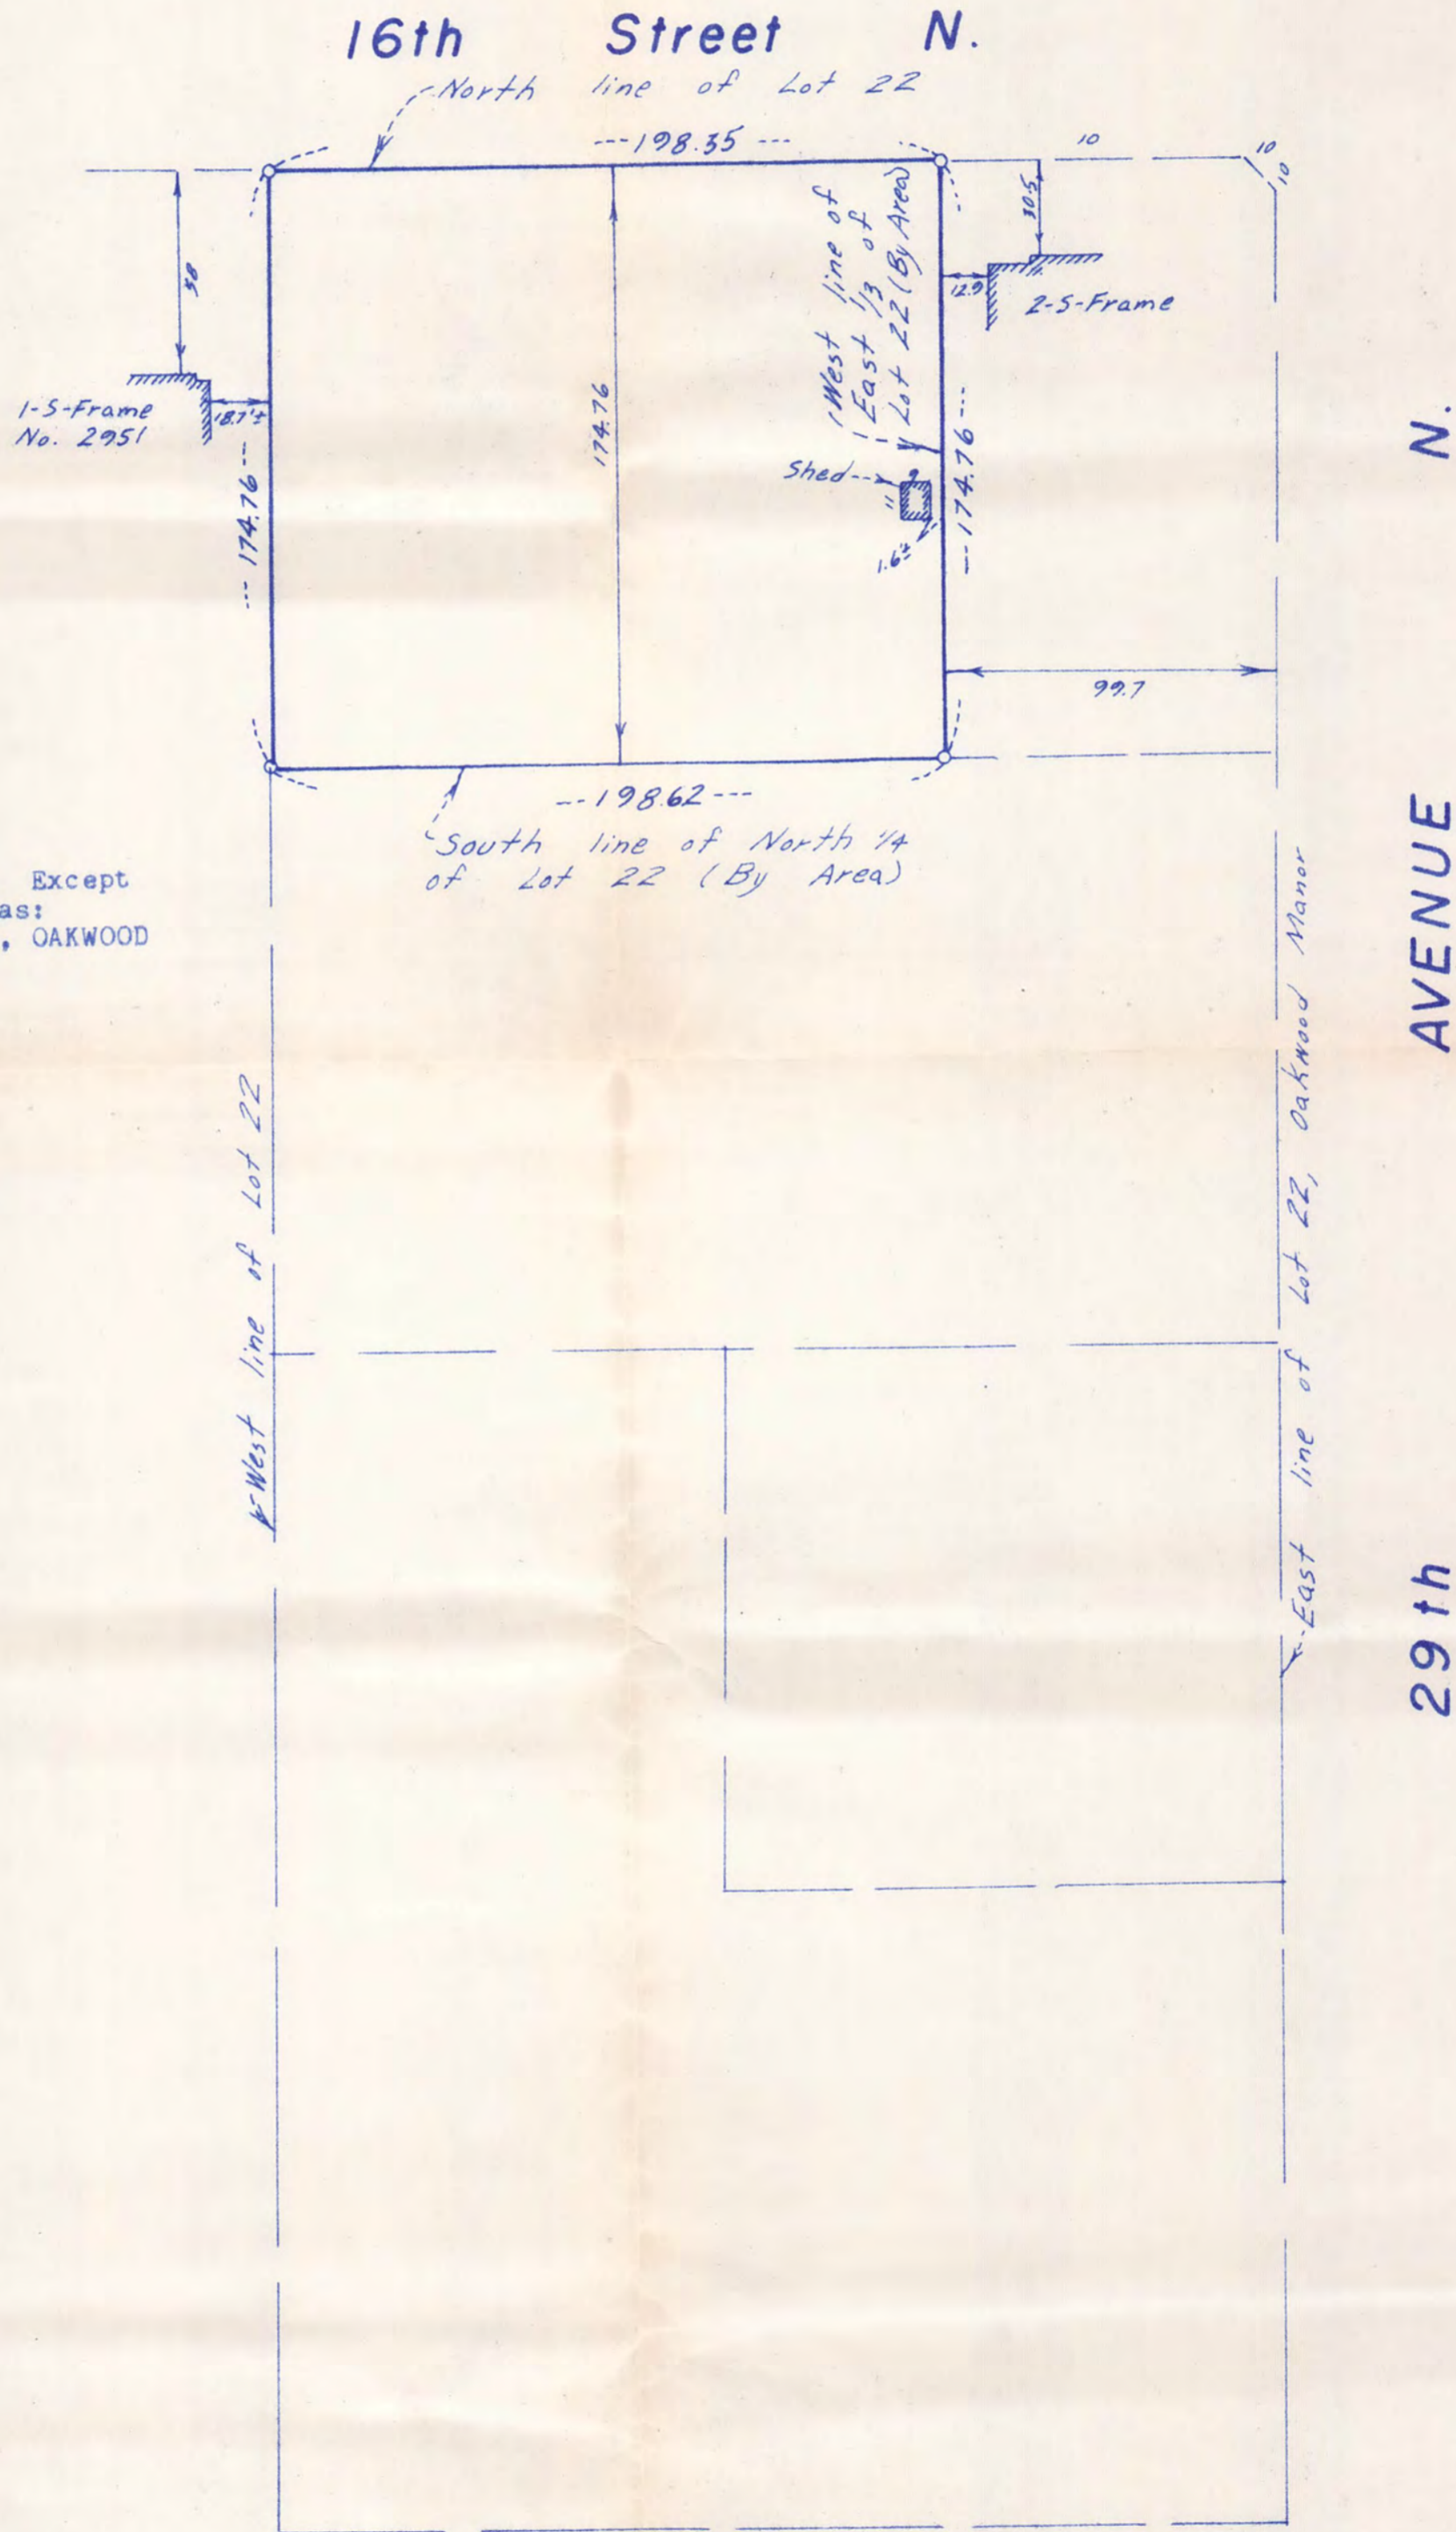

The North 1/4 of Lot 22, OAKWOOD MANOR. Except therefrom partial redemption described as:
The East 1/3 of the North 1/4 of Lot 22, OAKWOOD MANOR.



Scale 1" = 50'
Invoice # 5646
F.B. 164-53
o Denotes Iron

N.
AVENUE
29th

FILED
1977
JUL 11

We hereby certify that this is a true and correct representation of a survey of the boundaries of the above described land and the location of all buildings and visible encroachments, if any, from or on said land.

Surveyed by us this 24th day of February 19 77

Signed Gerald T. Coyne MEH
LOT SURVEYS COMPANY