


E. DELOS

AVE.

ST.

ST

CLINTON

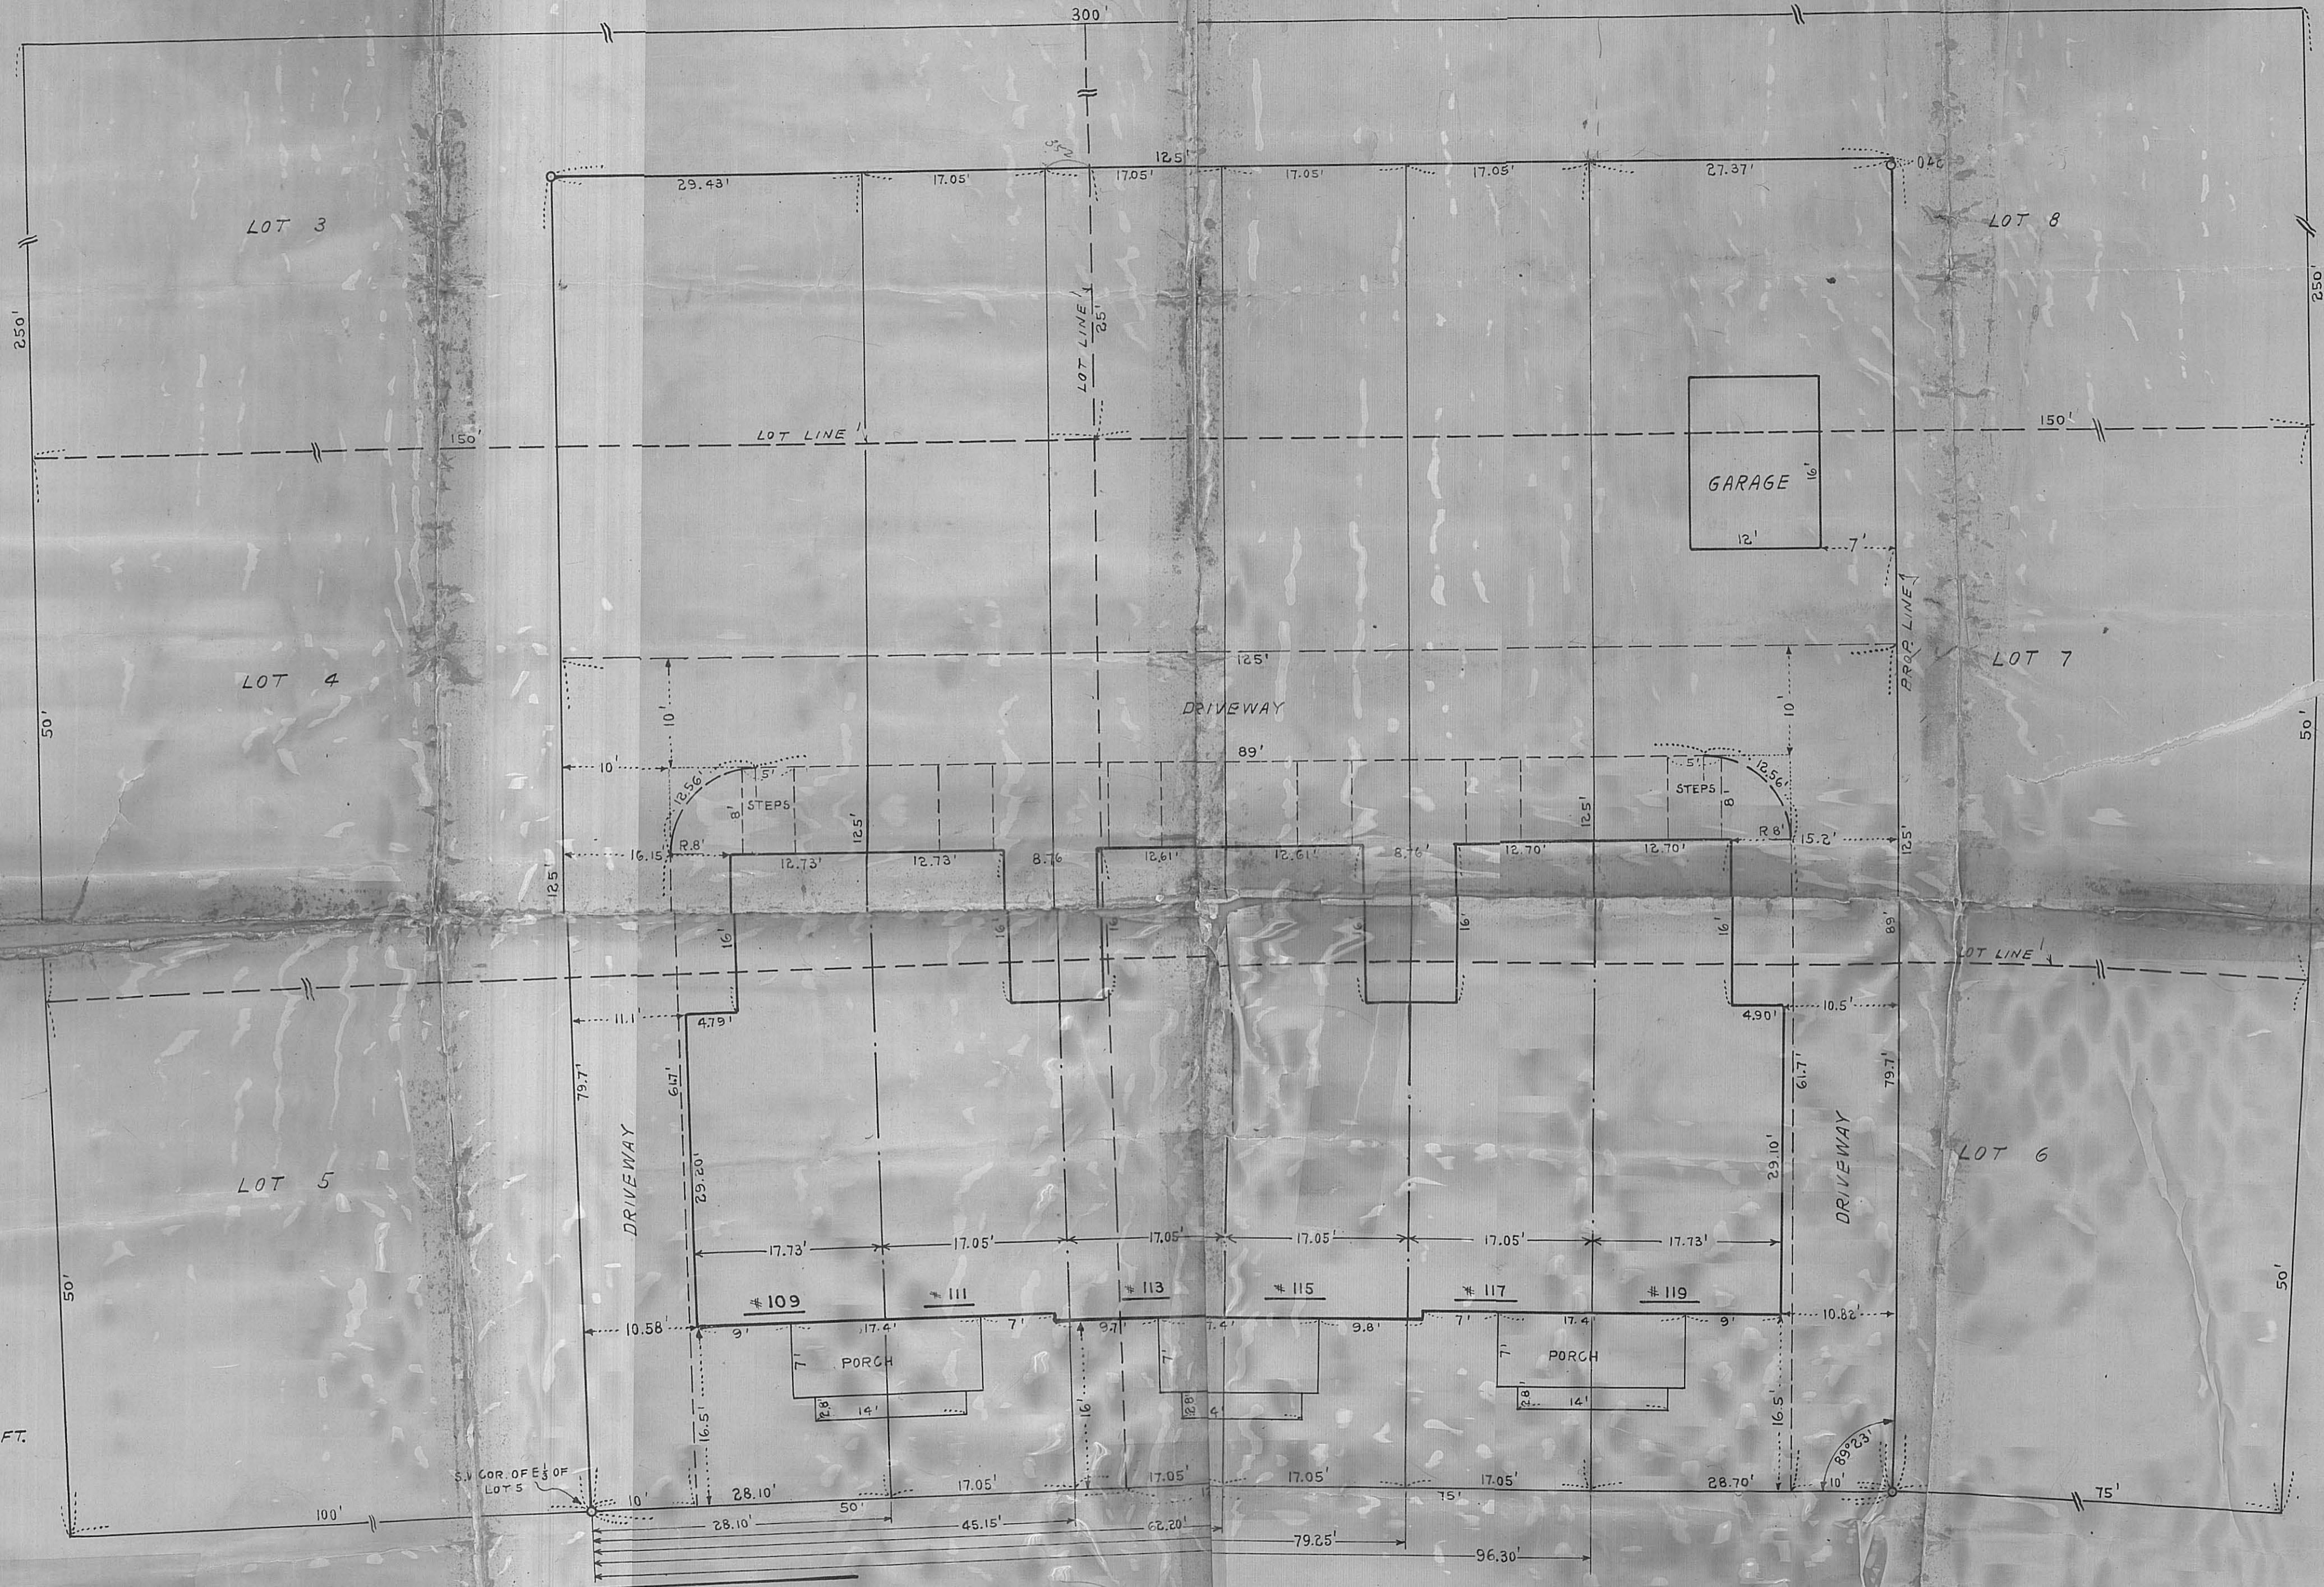

SCALE: 1 IN. = 10 FT.
 O INDICATES IRON

**SURVEY OF PART OF LOTS 3, 4, 5, 6, 7 & 8 OF BLK. 37
 OF WEST ST. PAUL PROPER AND LOCATION OF BUILDINGS.**

E. ISABEL

ST.

ENGINEERING SERVICE CO.
 W. G. Ramlow,
 REG. SURVEYOR & ENGR. MINN. NO. 1150
 700 COMMERCE BLDG. ST. PAUL 1 MINN.
 DEC. - 18 - 1947.