


WYOMING ST.


12355

Ho. # 468
Adjacent
Edmund
Hopinski
Maintains
Lot 3

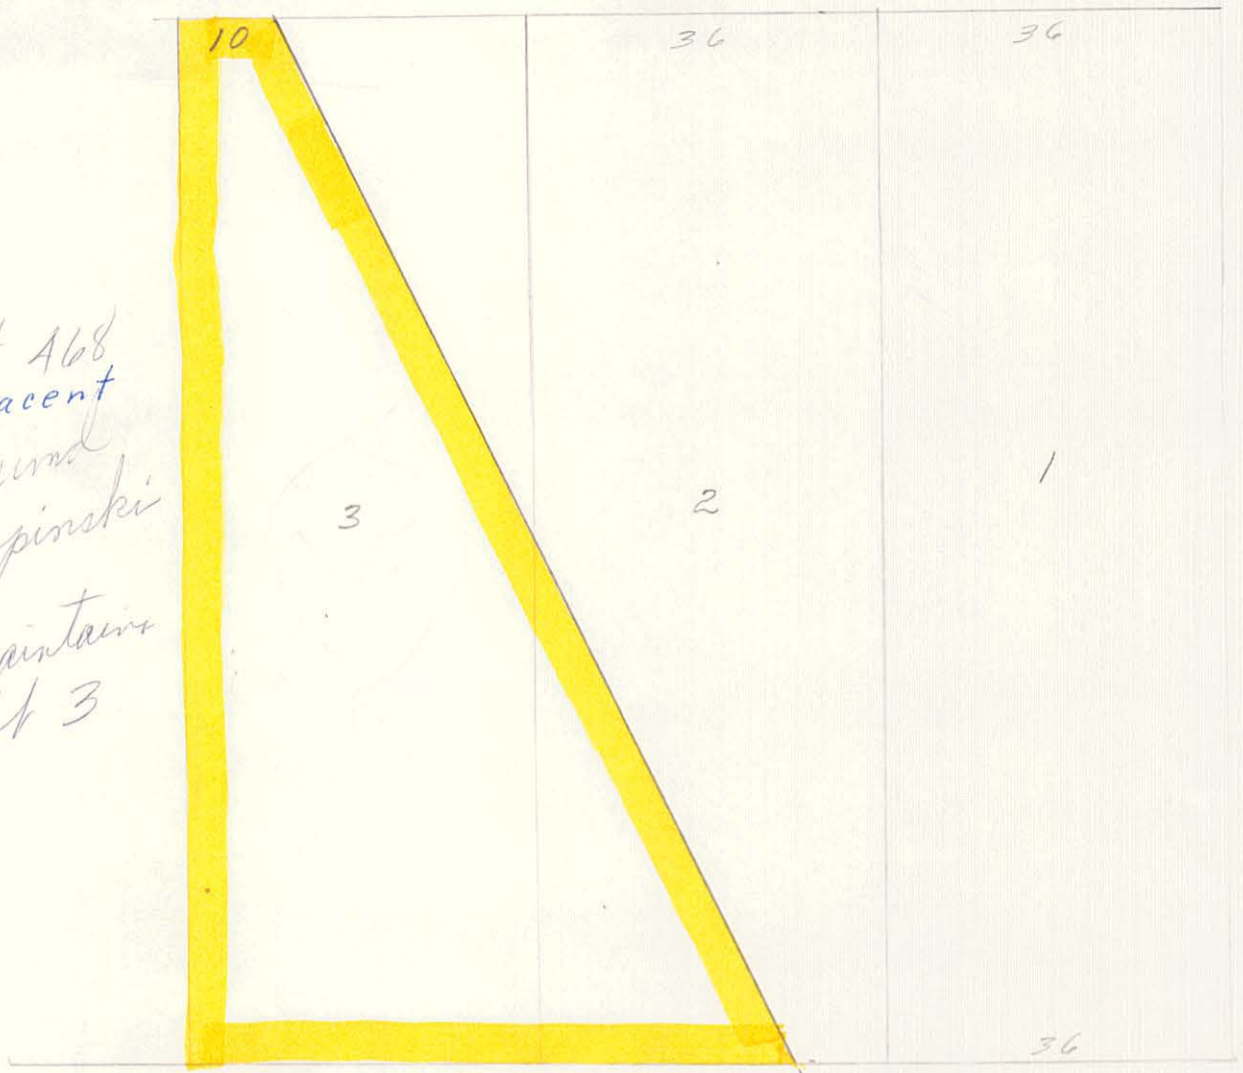

20' Alley

15' ± to fence

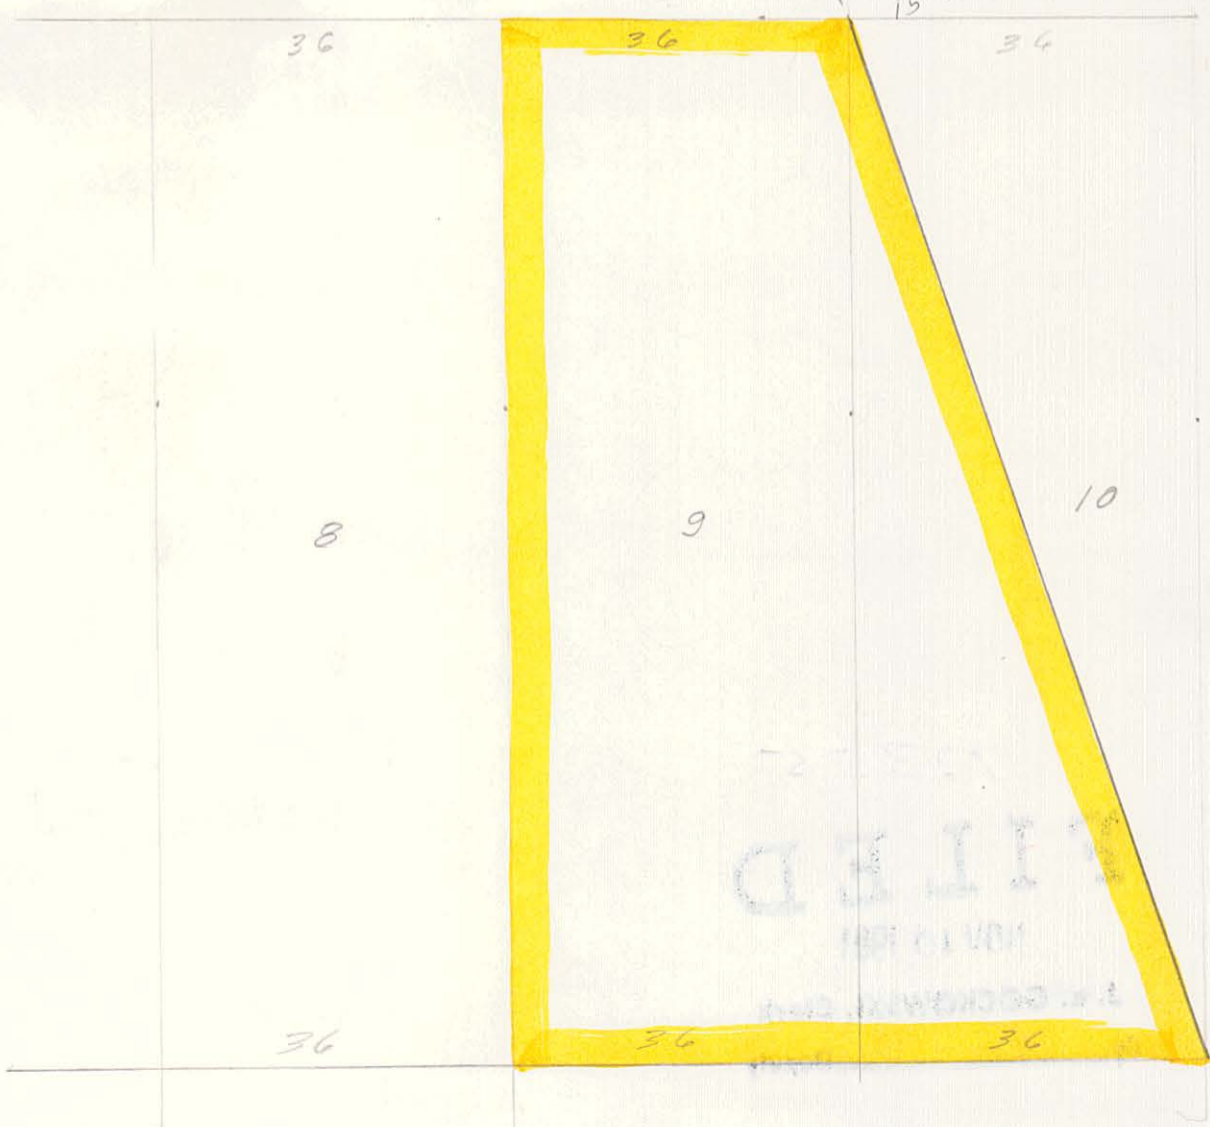

ST

WATERLOO

15' ± to fence

ANNAPOLIS ST.