BRUCE A. FOLZ & ASSOCIATES
LAND SURVEYING — LAND PLANNING
14791 60TH STREET N.
STILLWATER, MN. 55082
(612) 439-8833

CERTIFICATE of SURVEY

SURVEY FOR:
Richard E. Klein
1955 Oakdale Ave.
Apt. 234
W. St.Paul, Mn. 55118

I HEREBY CERTIFY THAT THIS DRAWING IS A CORRECT REPRESENTATION OF THIS SURVEY AND ALL MONUMENTS HAVE BEEN PLACED IN THE GROUND AS SHOWN. THIS SURVEY OR PLAN WAS PREPARED BY ME OR UNDER MY DIRECT SUPERVISION AND I AM A DULY REGISTERED LAND SURVEYOR UNDER THE LAWS OF THE STATE OF MINNESOTA.

Bruce A Folz — October 20, 1981

BRUCE A. FOLZ — MINN. REG. NO. 9232 — DATE

LEGAL DESCRIPTION: SEE ATTACHED SHEET

NOTE: See Attached Survey Report Dated October 21, 1981

NOTE: The Existing MDOT Chainlink Fence Near The West Line of Lot 19 Is Encroached Onto Lot 19. A One Foot Easement Will Be Granted By Mr. Klein To MDOT For Purposes Of A Chainlink Fence.
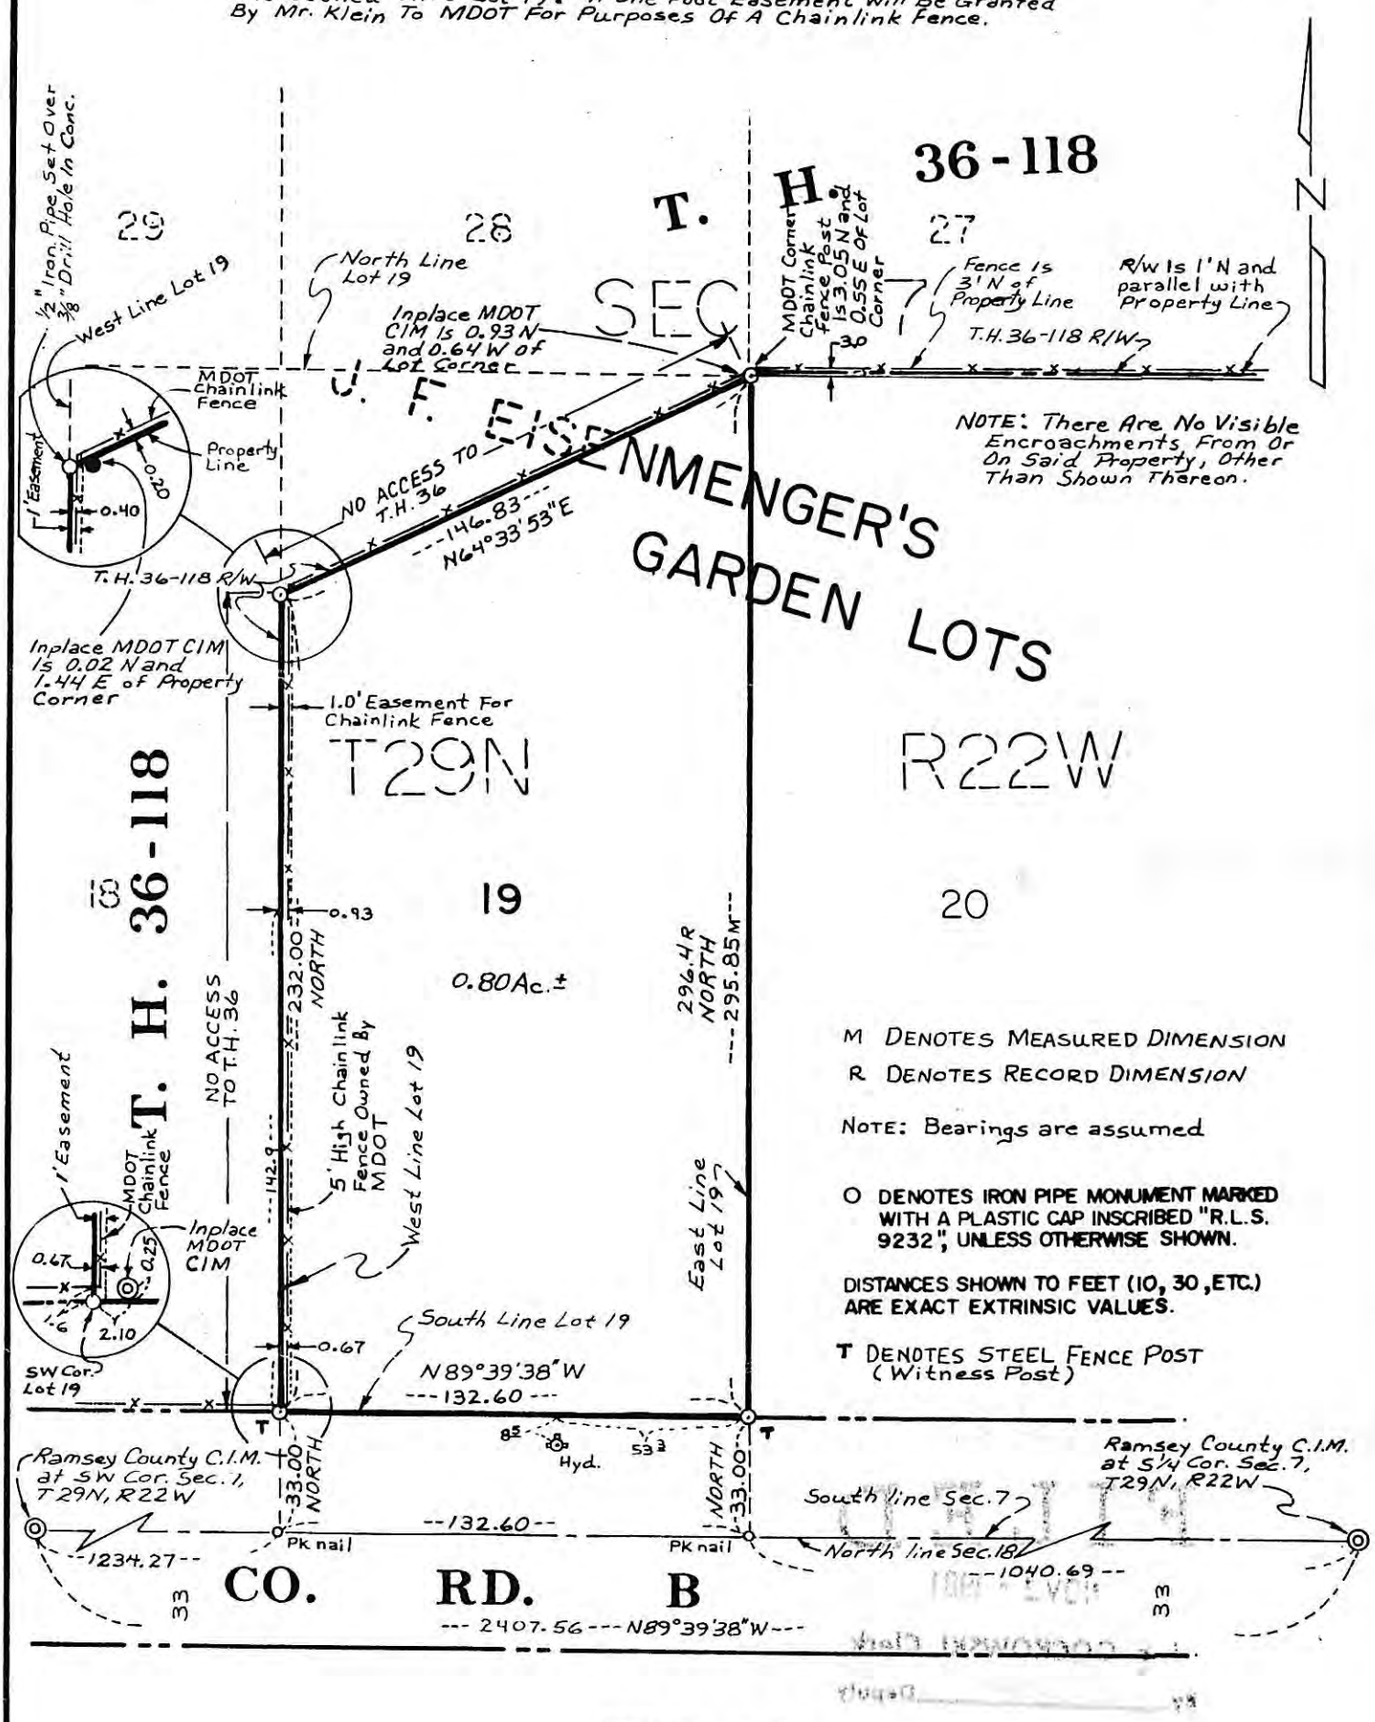
SCALE: 1 inch = 50 feet (0, 25, 50)