

12479
FILED

CERTIFICATE OF SURVEY

NOV 1 1983
J. E. GOCKOWSKI, Clerk
By Deputy

by
JOHN R. TURPIN
REGISTERED LAND SURVEYOR
MINN. REGISTRATION NO. 6740
ST. PAUL, MINNESOTA

I hereby certify that this is a true and correct plat of survey of the land shown and described hereon, and that any monuments or markers indicated hereon have been placed as shown, and that any improvements or physical conditions indicated hereon are as shown.


John R. Turpin

Surveyed July 11, 1983

Plat Scale - 1 in. = 10 ft. o Indicates iron pipe monument.

Description - Lot 11, Auditor's Sub. No. 65; situated in St. Paul, Ramsey County, Minnesota.

Previously described as : "Southeast One-Quarter of the Southwest One-Quarter of Lot 3, except the West 85 feet thereof, Leech's Addition of Out Lots to the Town of St. Paul, Minnesota Territory. (Book 1111 of Deeds, Page 233)

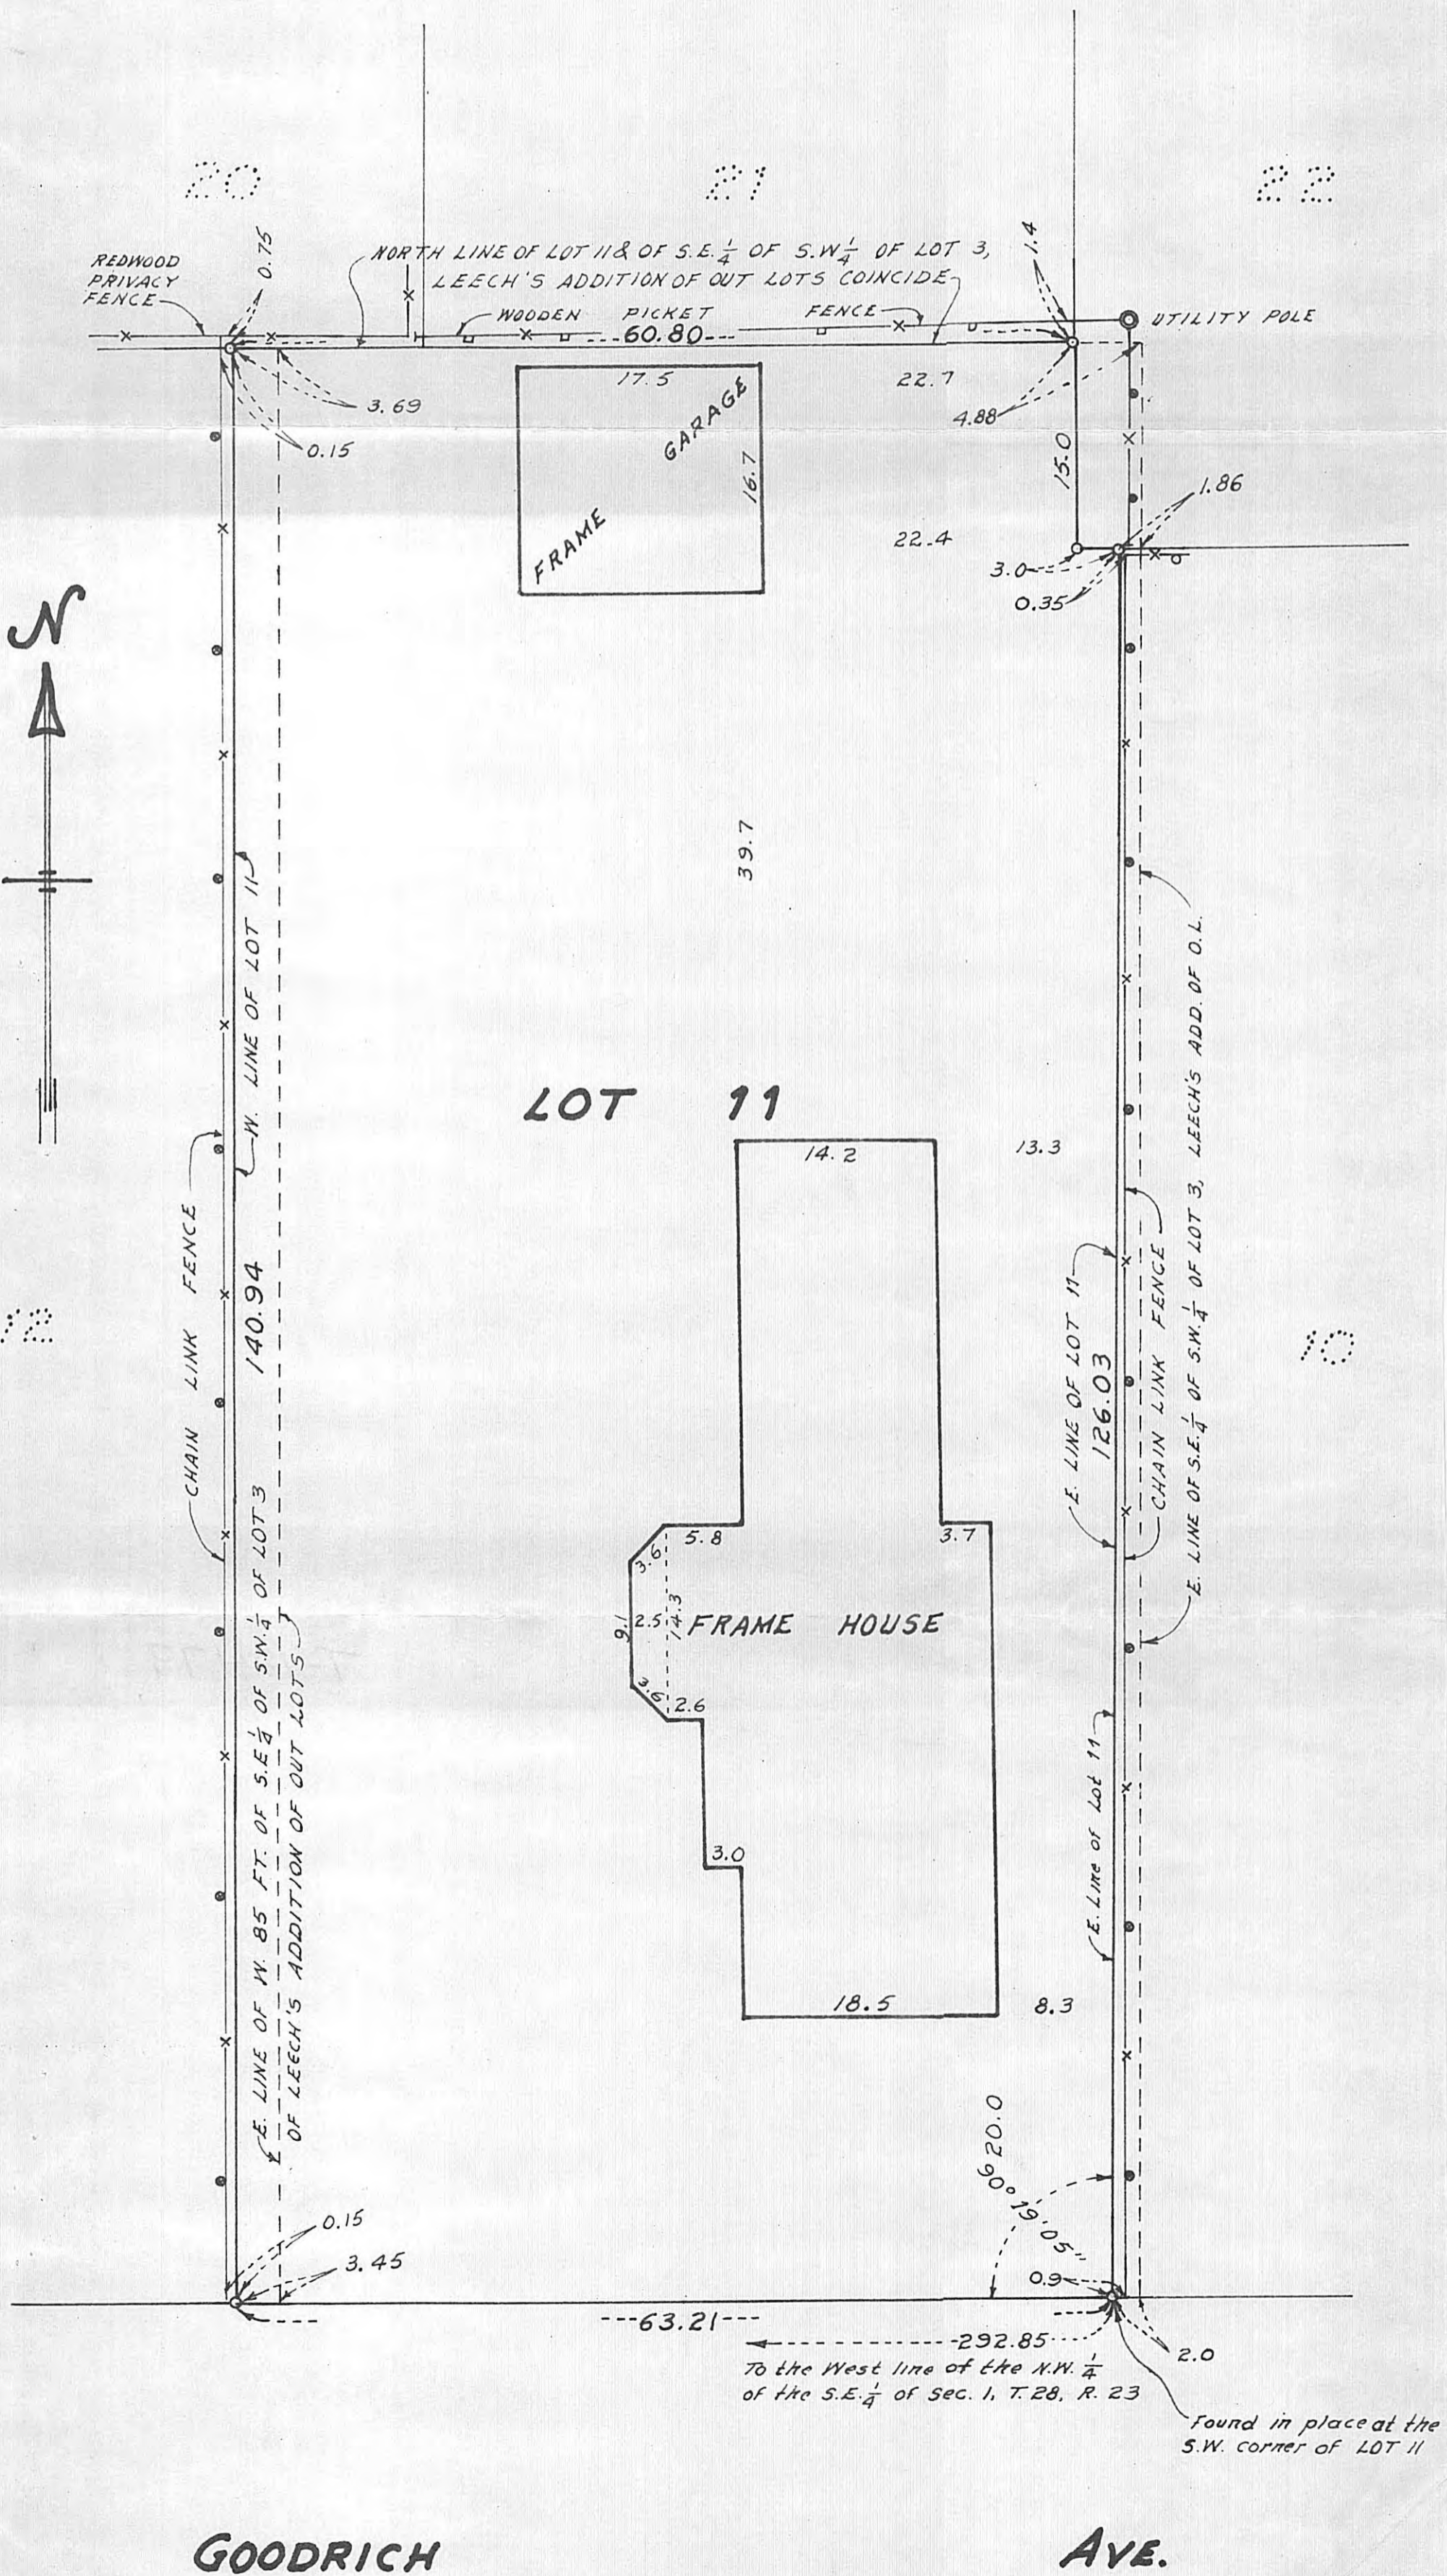

GOODRICH

AVE.

Found in place at the S.W. corner of LOT 11

